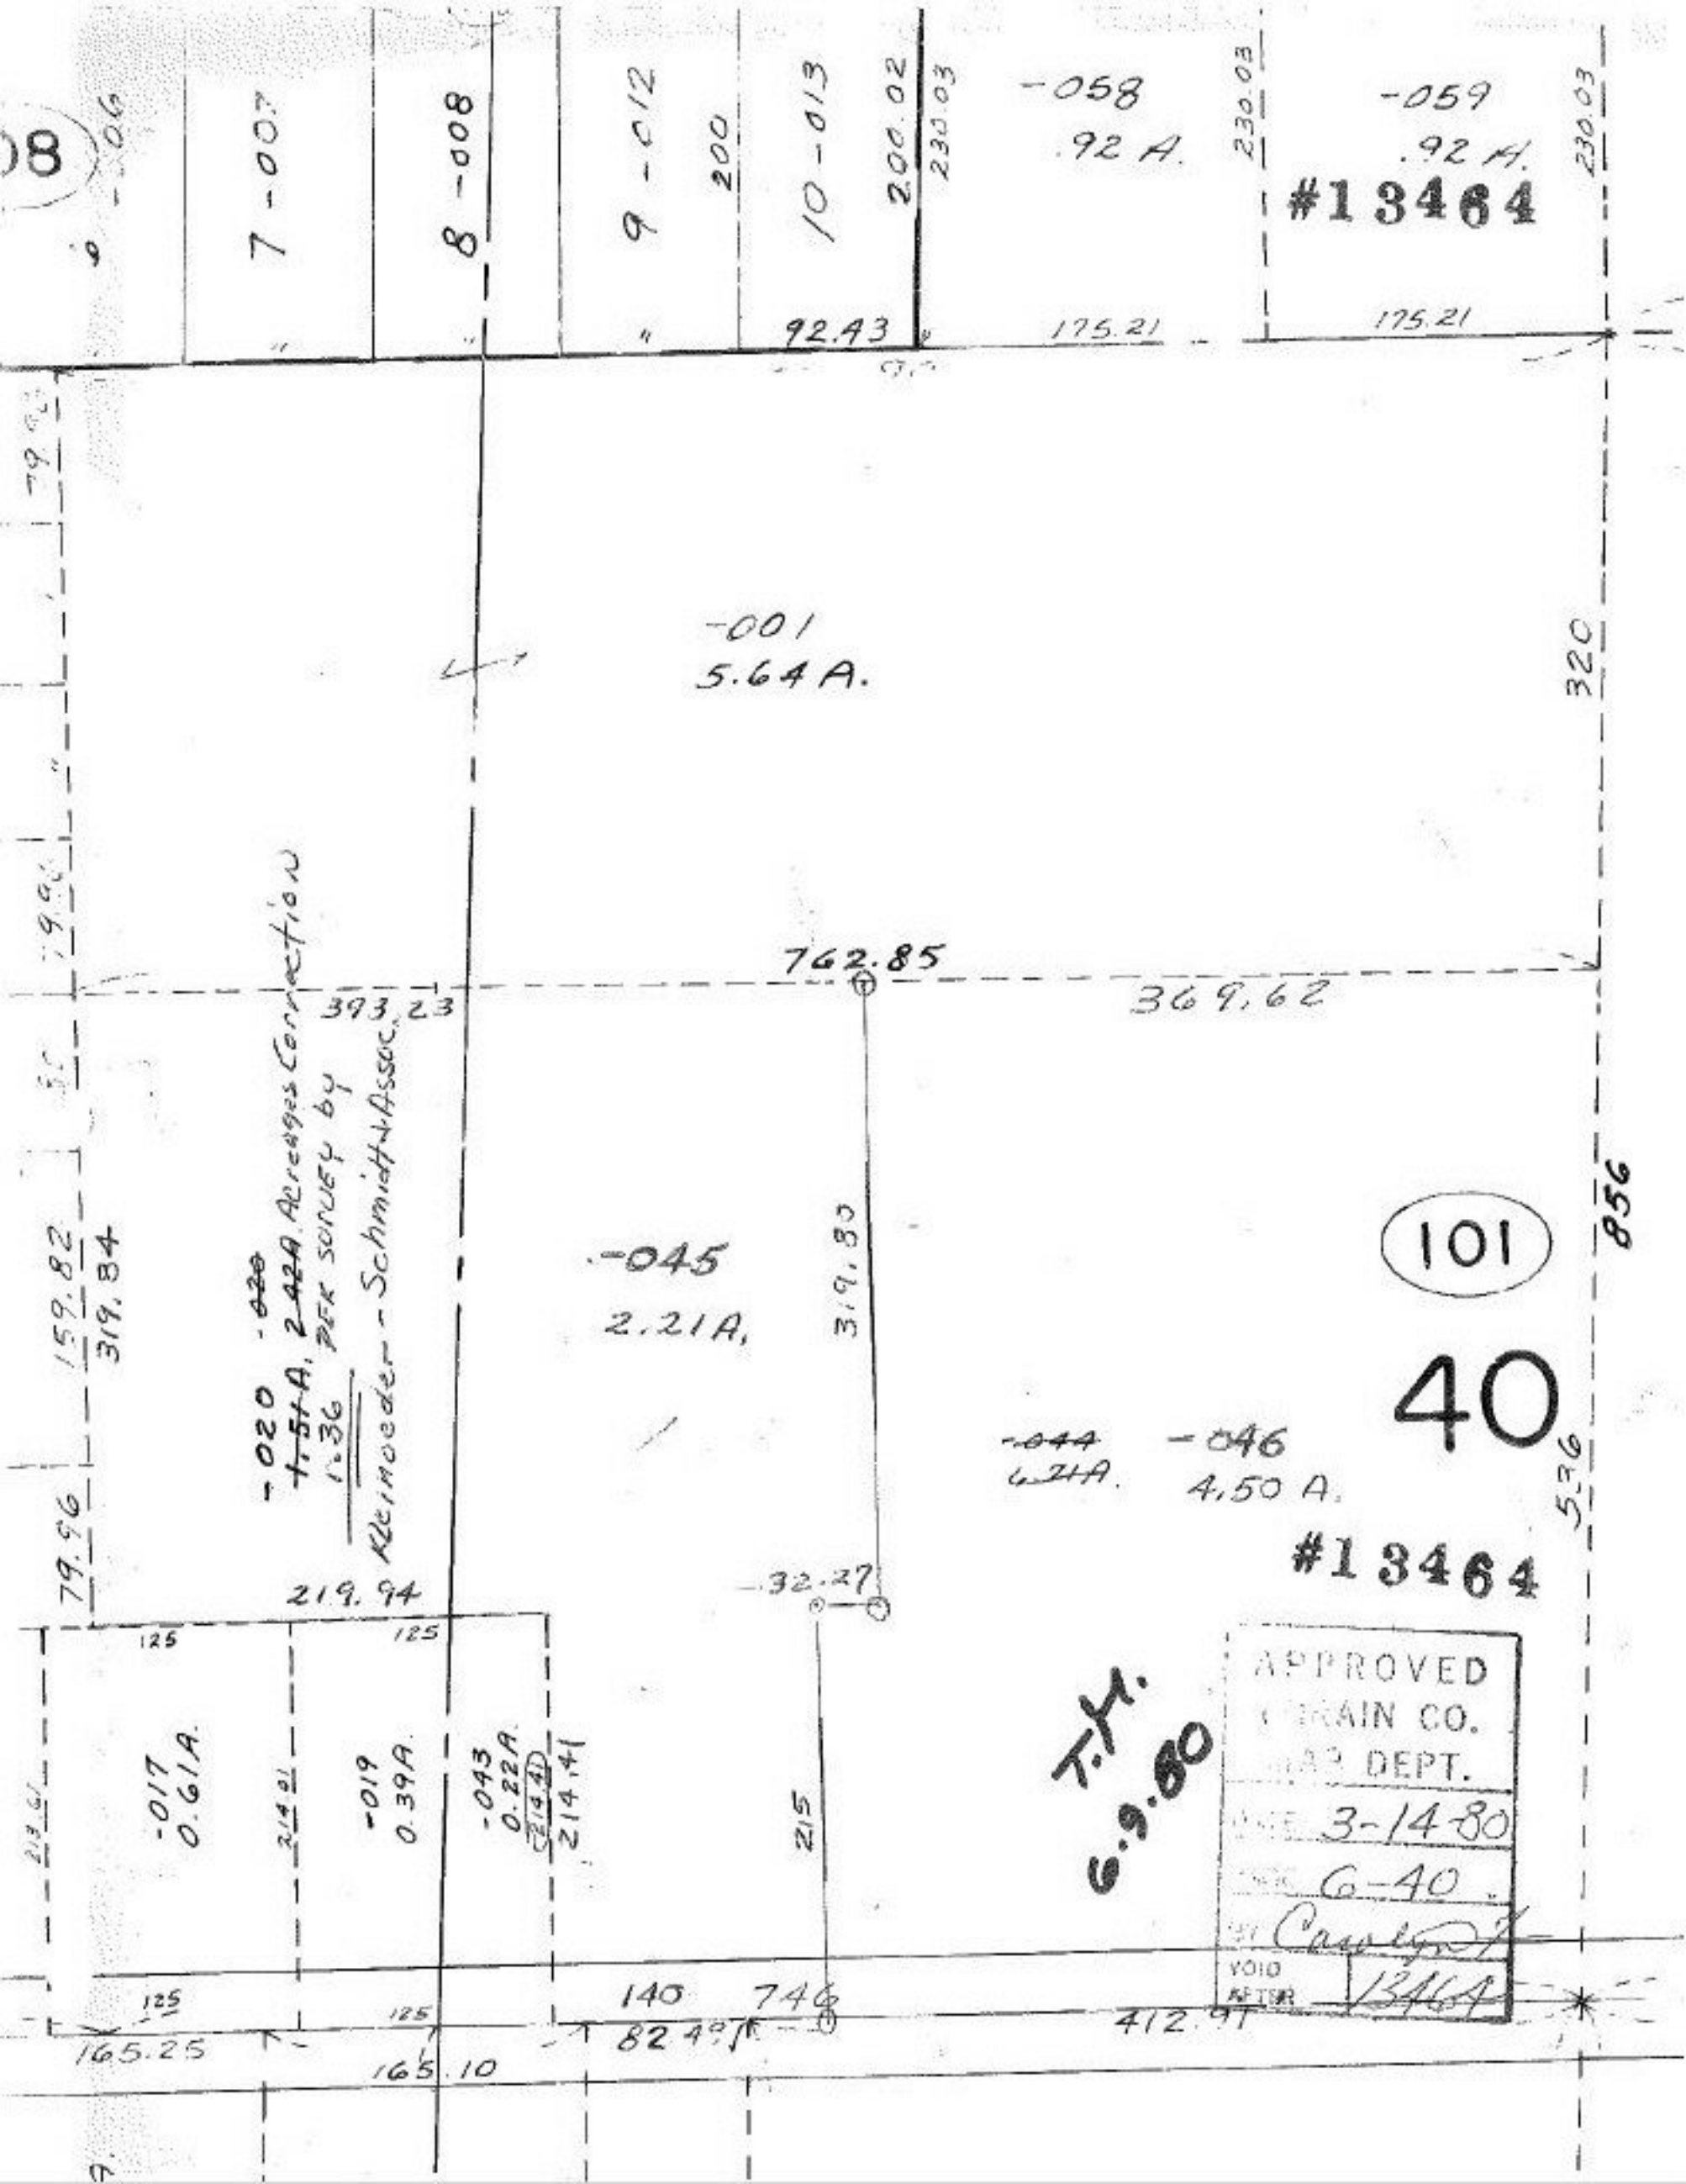

08
7-007
8-008
9-012
200
10-013
200.02
230.03
-058
.92 A.
230.03
-059
.92 A.
230.03
#13464
92.43
175.21
175.21
-001
5.64 A.
320
762.85
393.23
369.62
Acreages Correction
PER SURVEY by
Kleinoeder - Schmidt + Assoc.
-020
1.36
-045
2.21 A.
319.80
101
40
856
159.82
319.84
-044
6.21 A.
-046
4.50 A.
536
#13464
79.96
219.94
32.27
125
125
-017
0.61 A.
-019
0.39 A.
-043
0.22 A.
214.41
215
T.H.
6.9.80
APPROVED
DRAIN CO.
MAP DEPT.
3-14-80
6-40
VOID
AFTER
13464
125
125
140
746
82.49
412.91
165.25
165.10