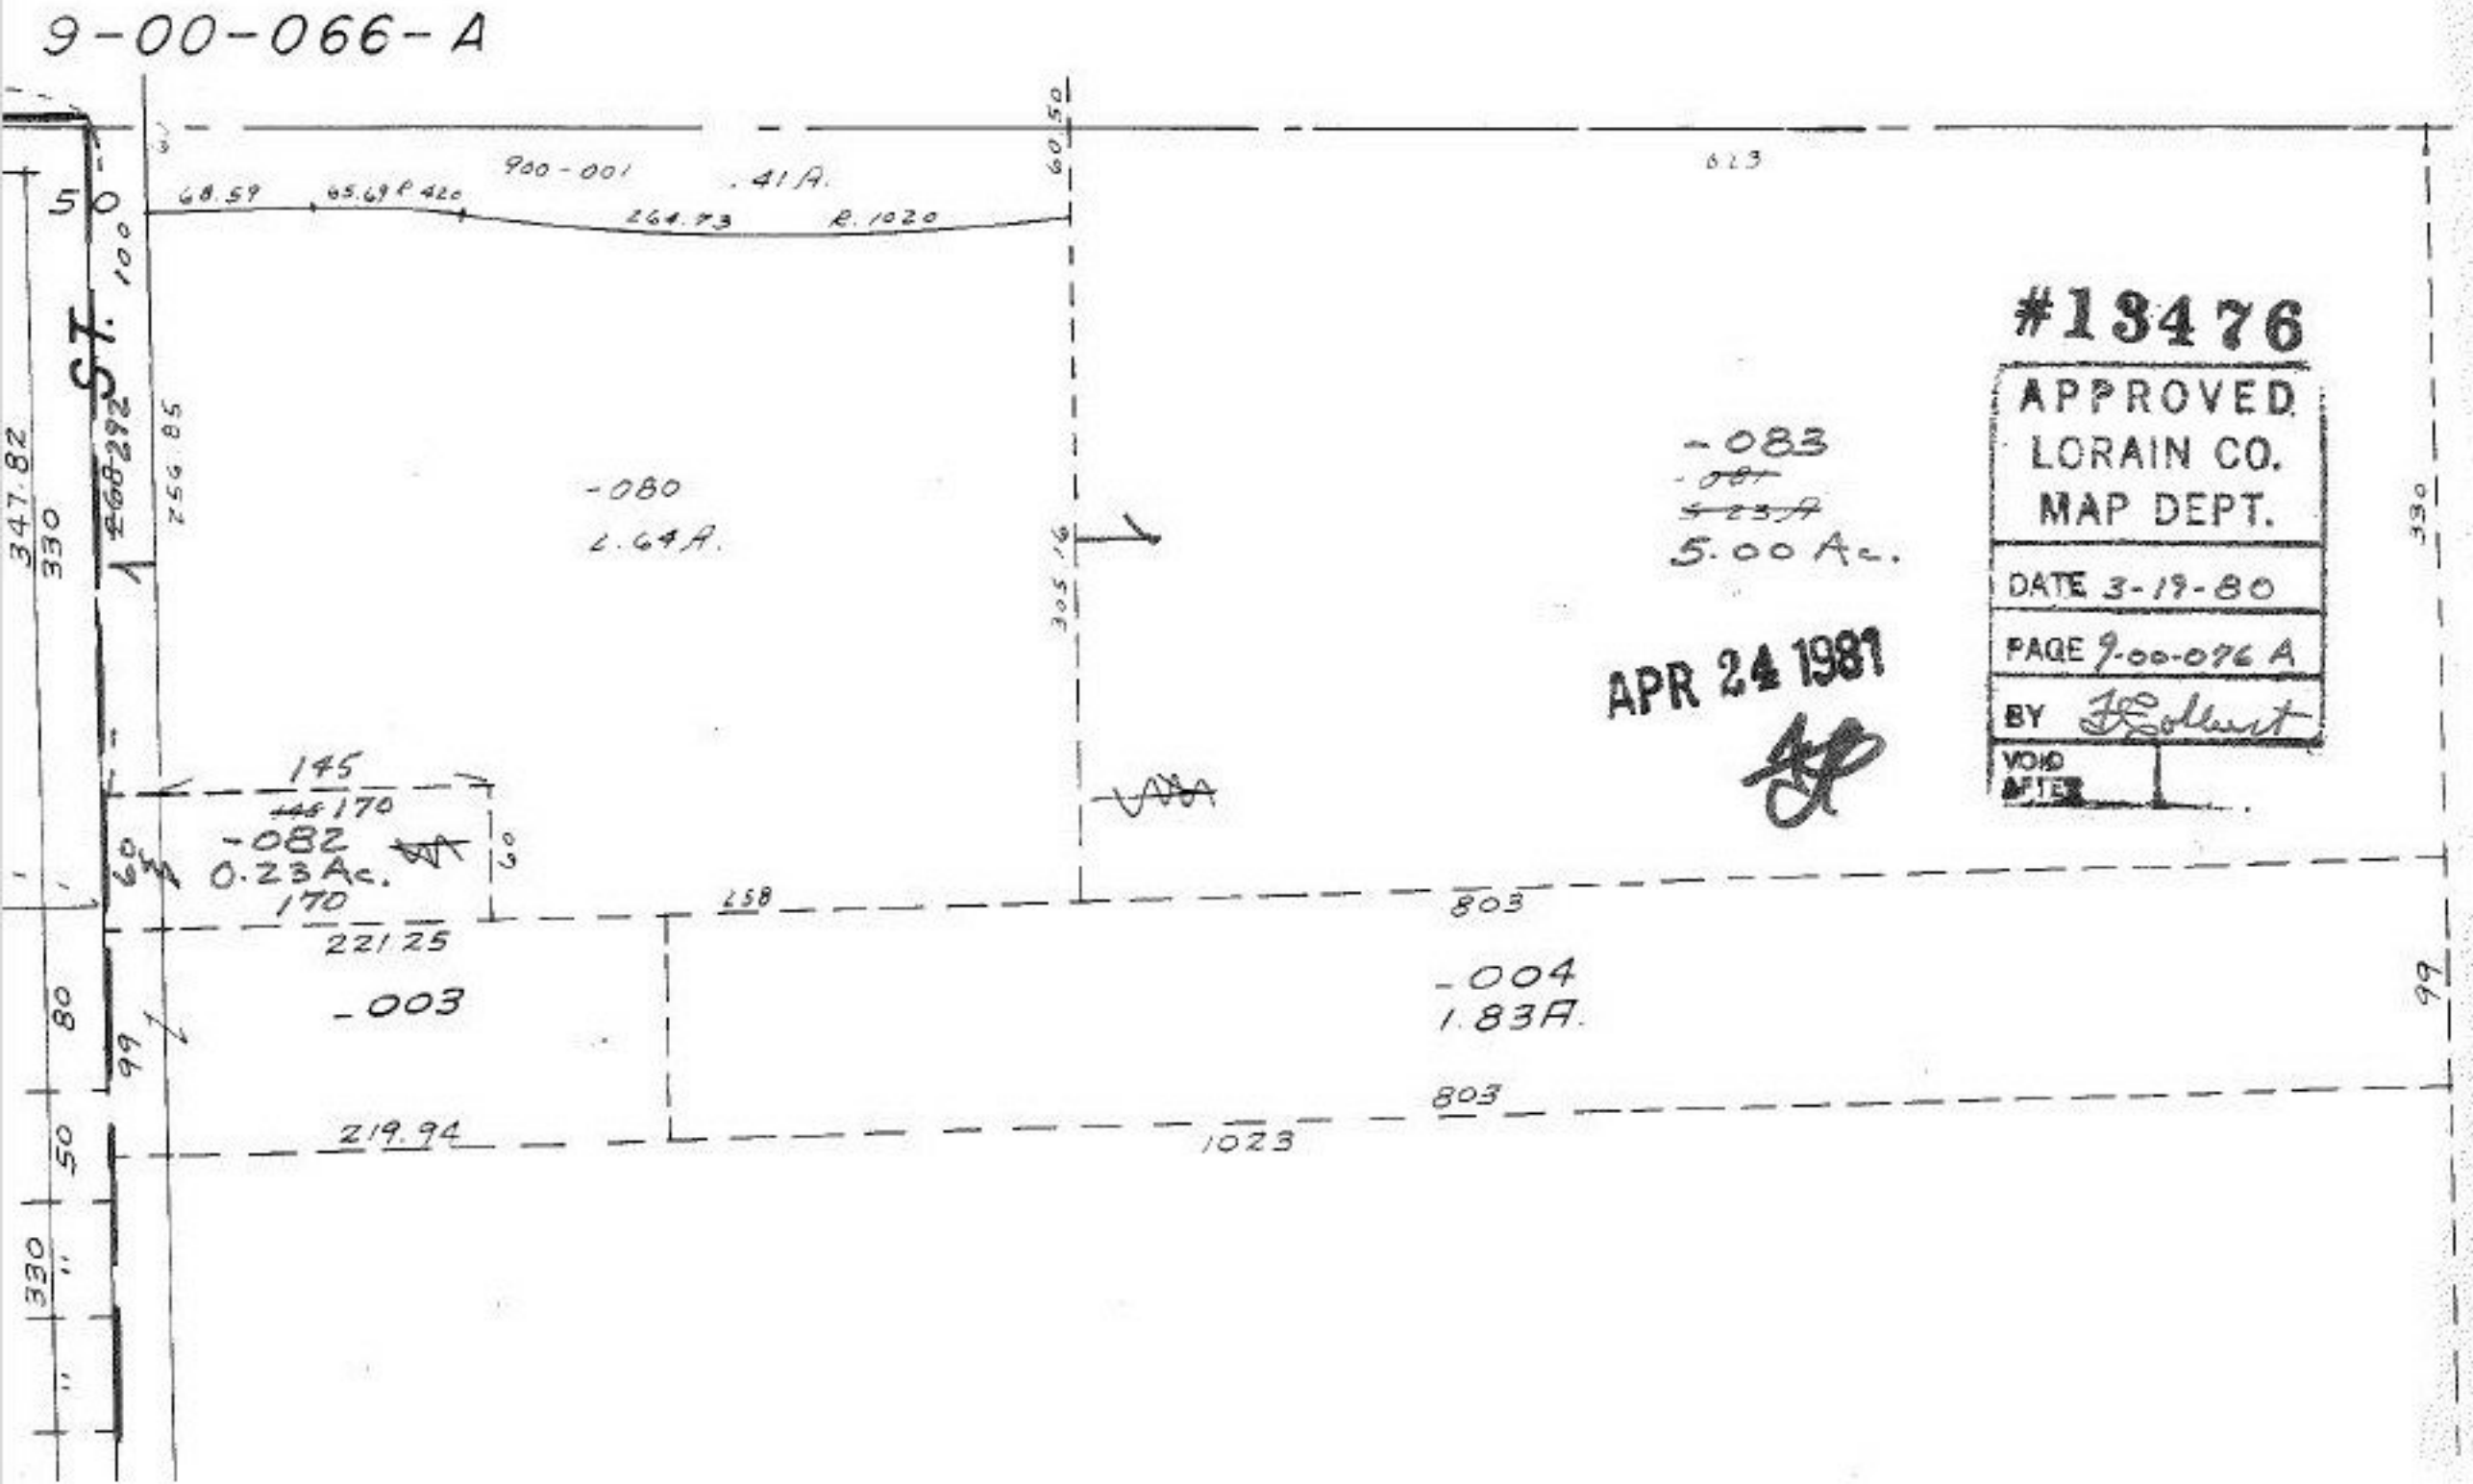
9-00-066-A
900-001
.41A.
68.59
65.69 R 420
264.73
R. 1020
60.50
623
50
100
ST.
347.82
330
256.85
-080
2.64A.
305.16
-083
5.00 Ac.
145
170
-082
0.23 Ac.
170
221.25
258
803
-003
-004
1.83A.
80
99
803
219.94
1023
50
330
330
99
#13476
APPROVED
LORAIN CO.
MAP DEPT.
DATE 3-19-80
PAGE 9-00-076 A
BY
VOID AFTER
APR 24 1981