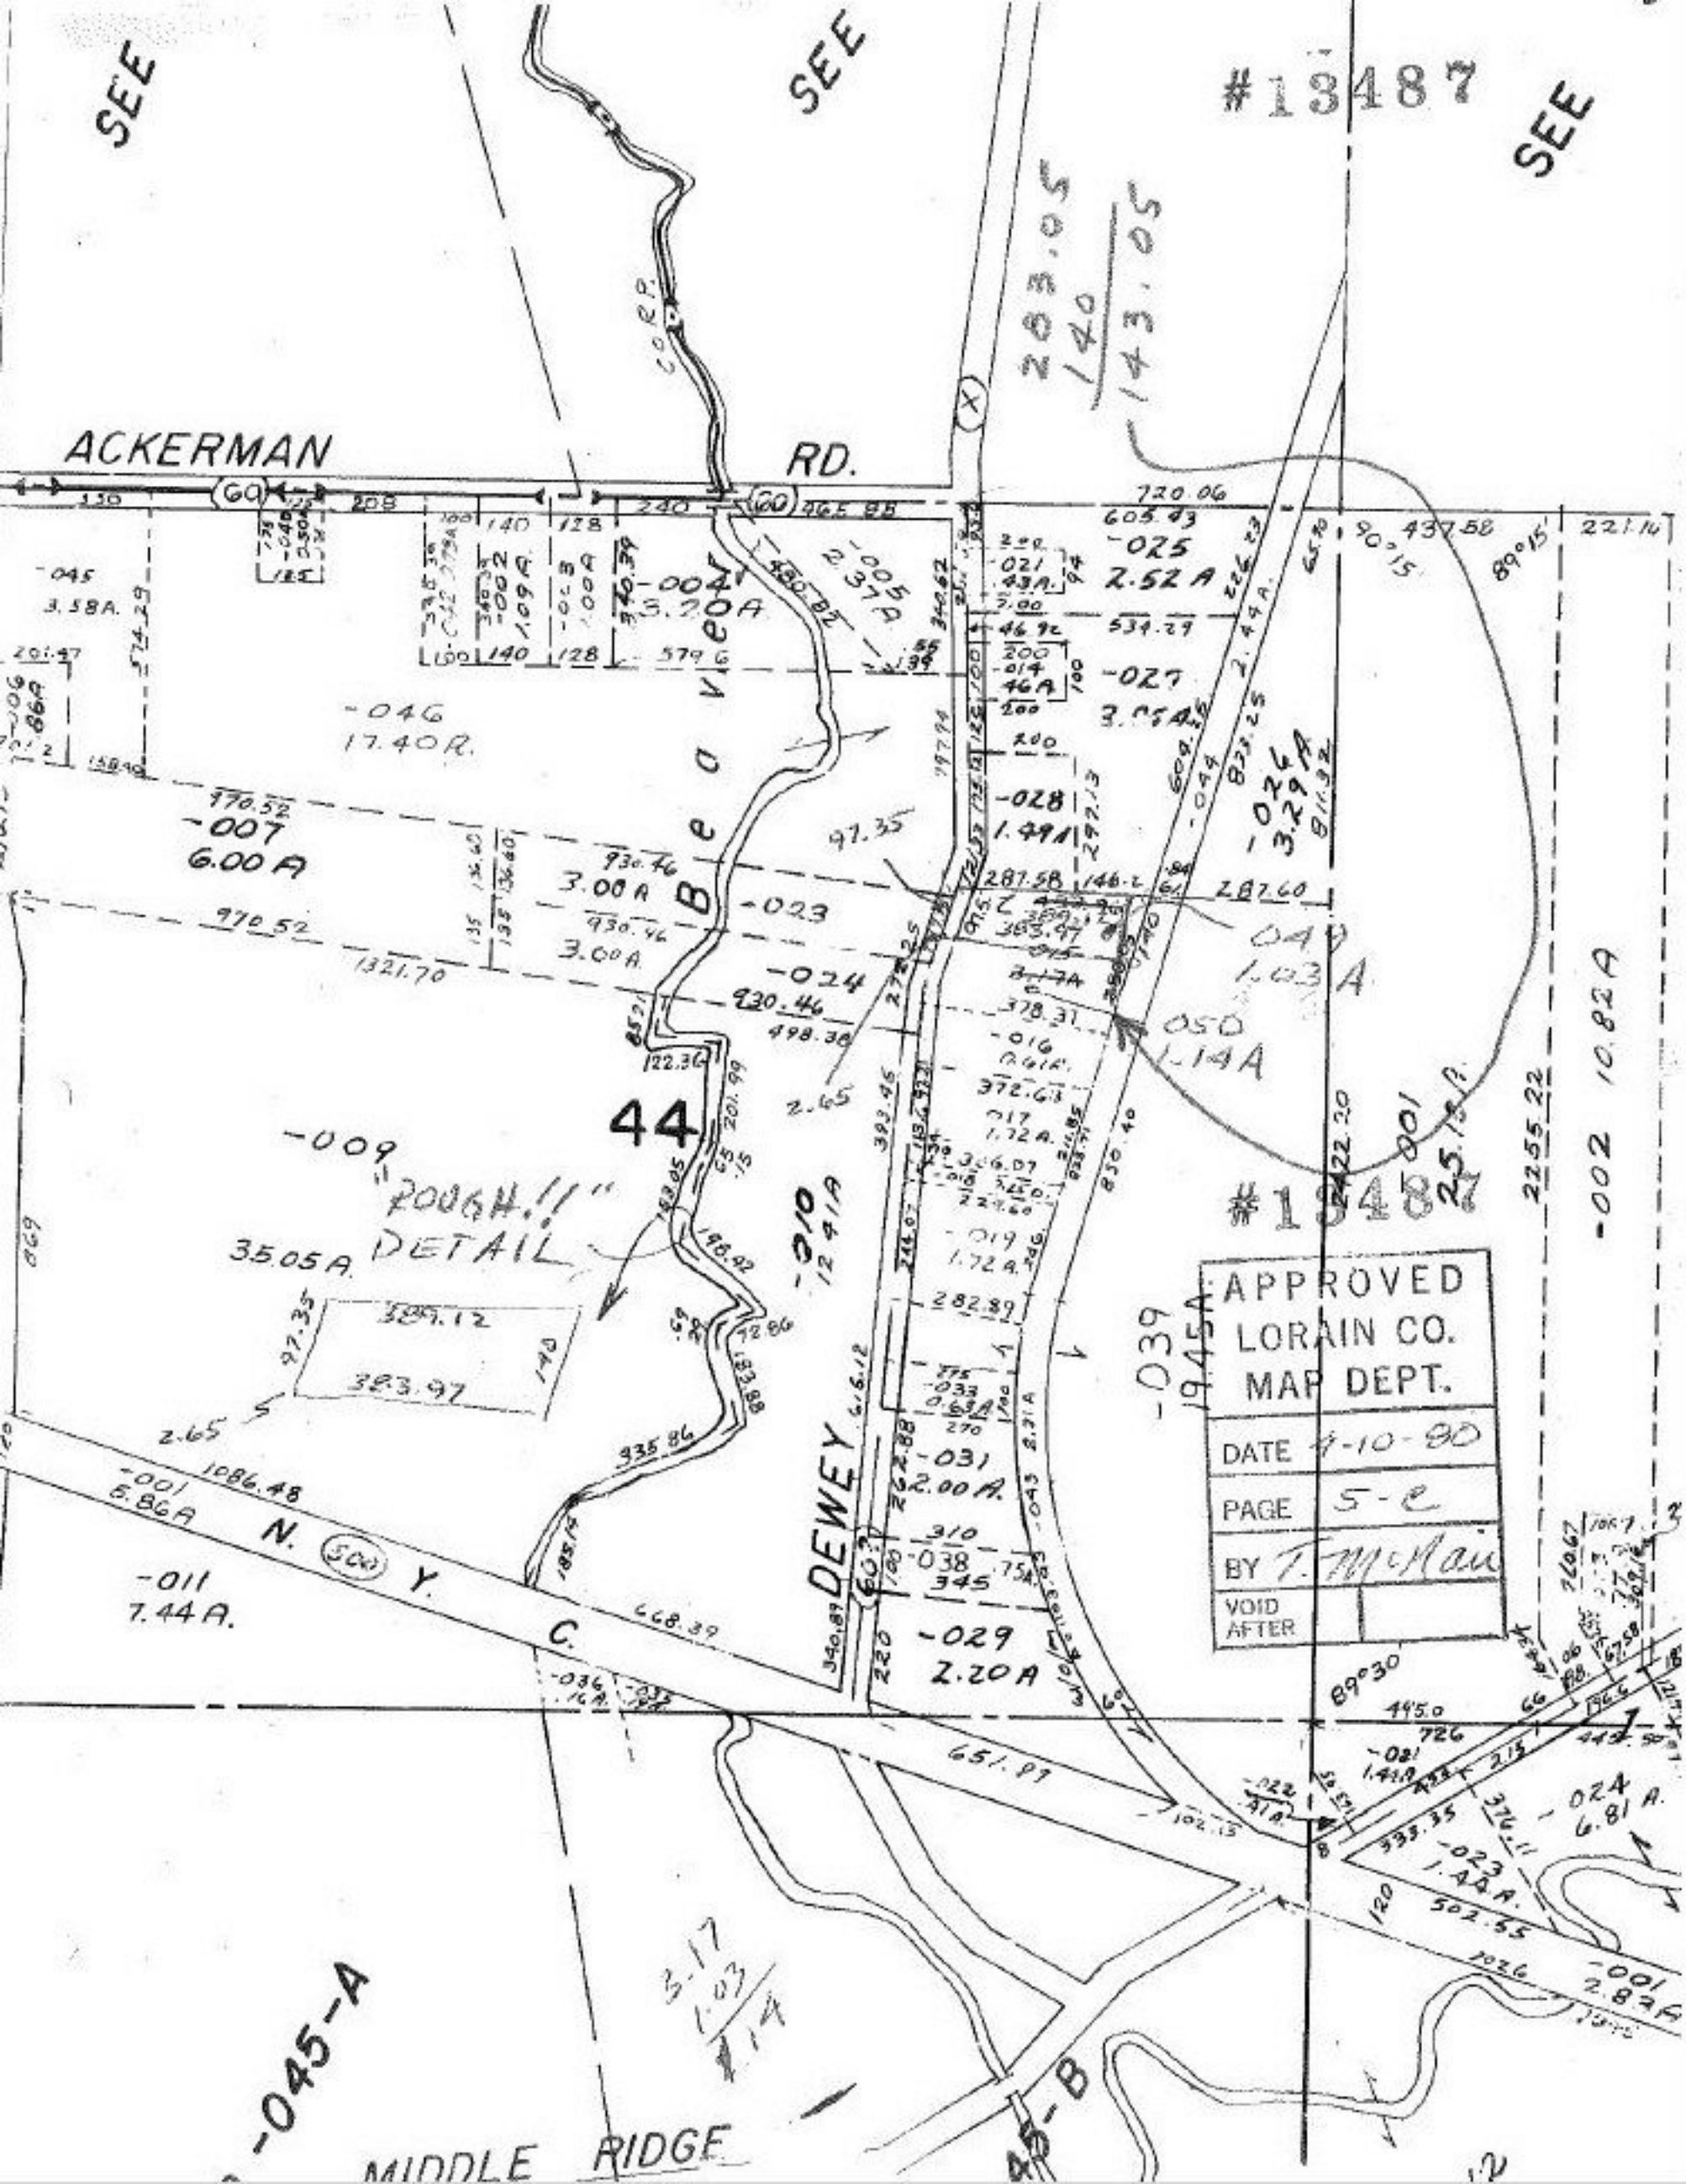

SEE
SEE
SEE
#13487
ACKERMAN
RD.
Beaver
DEWEY
N. Y. C.
MIDDLE RIDGE
44
"ROUGH!!" DETAIL
-046 17.40 A.
-007 6.00 A
-009 35.05 A.
-011 7.44 A.
-004 3.20 A
-025 2.52 A
-027 3.05 A
-028 1.49 A
-026 3.29 A
-023 3.00 A
-024 3.00 A
-049 1.03 A
-050 1.14 A
-010 12.41 A
-031 2.00 A.
-029 2.20 A
-039 19.45 A
-002 10.82 A
-024 6.81 A.
-023 1.44 A.
-001 2.83 A
-045-A
-045-B
APPROVED
LORAIN CO.
MAP DEPT.
DATE 4-10-80
PAGE 5-C
BY T. McNair
VOID AFTER