#13491

#13491

APPROVED
LORAIN CO.
MAP DEPT.
DATE 4-21-80
PAGE 3-00-102-25
BY T. McHair
VOID AFTER
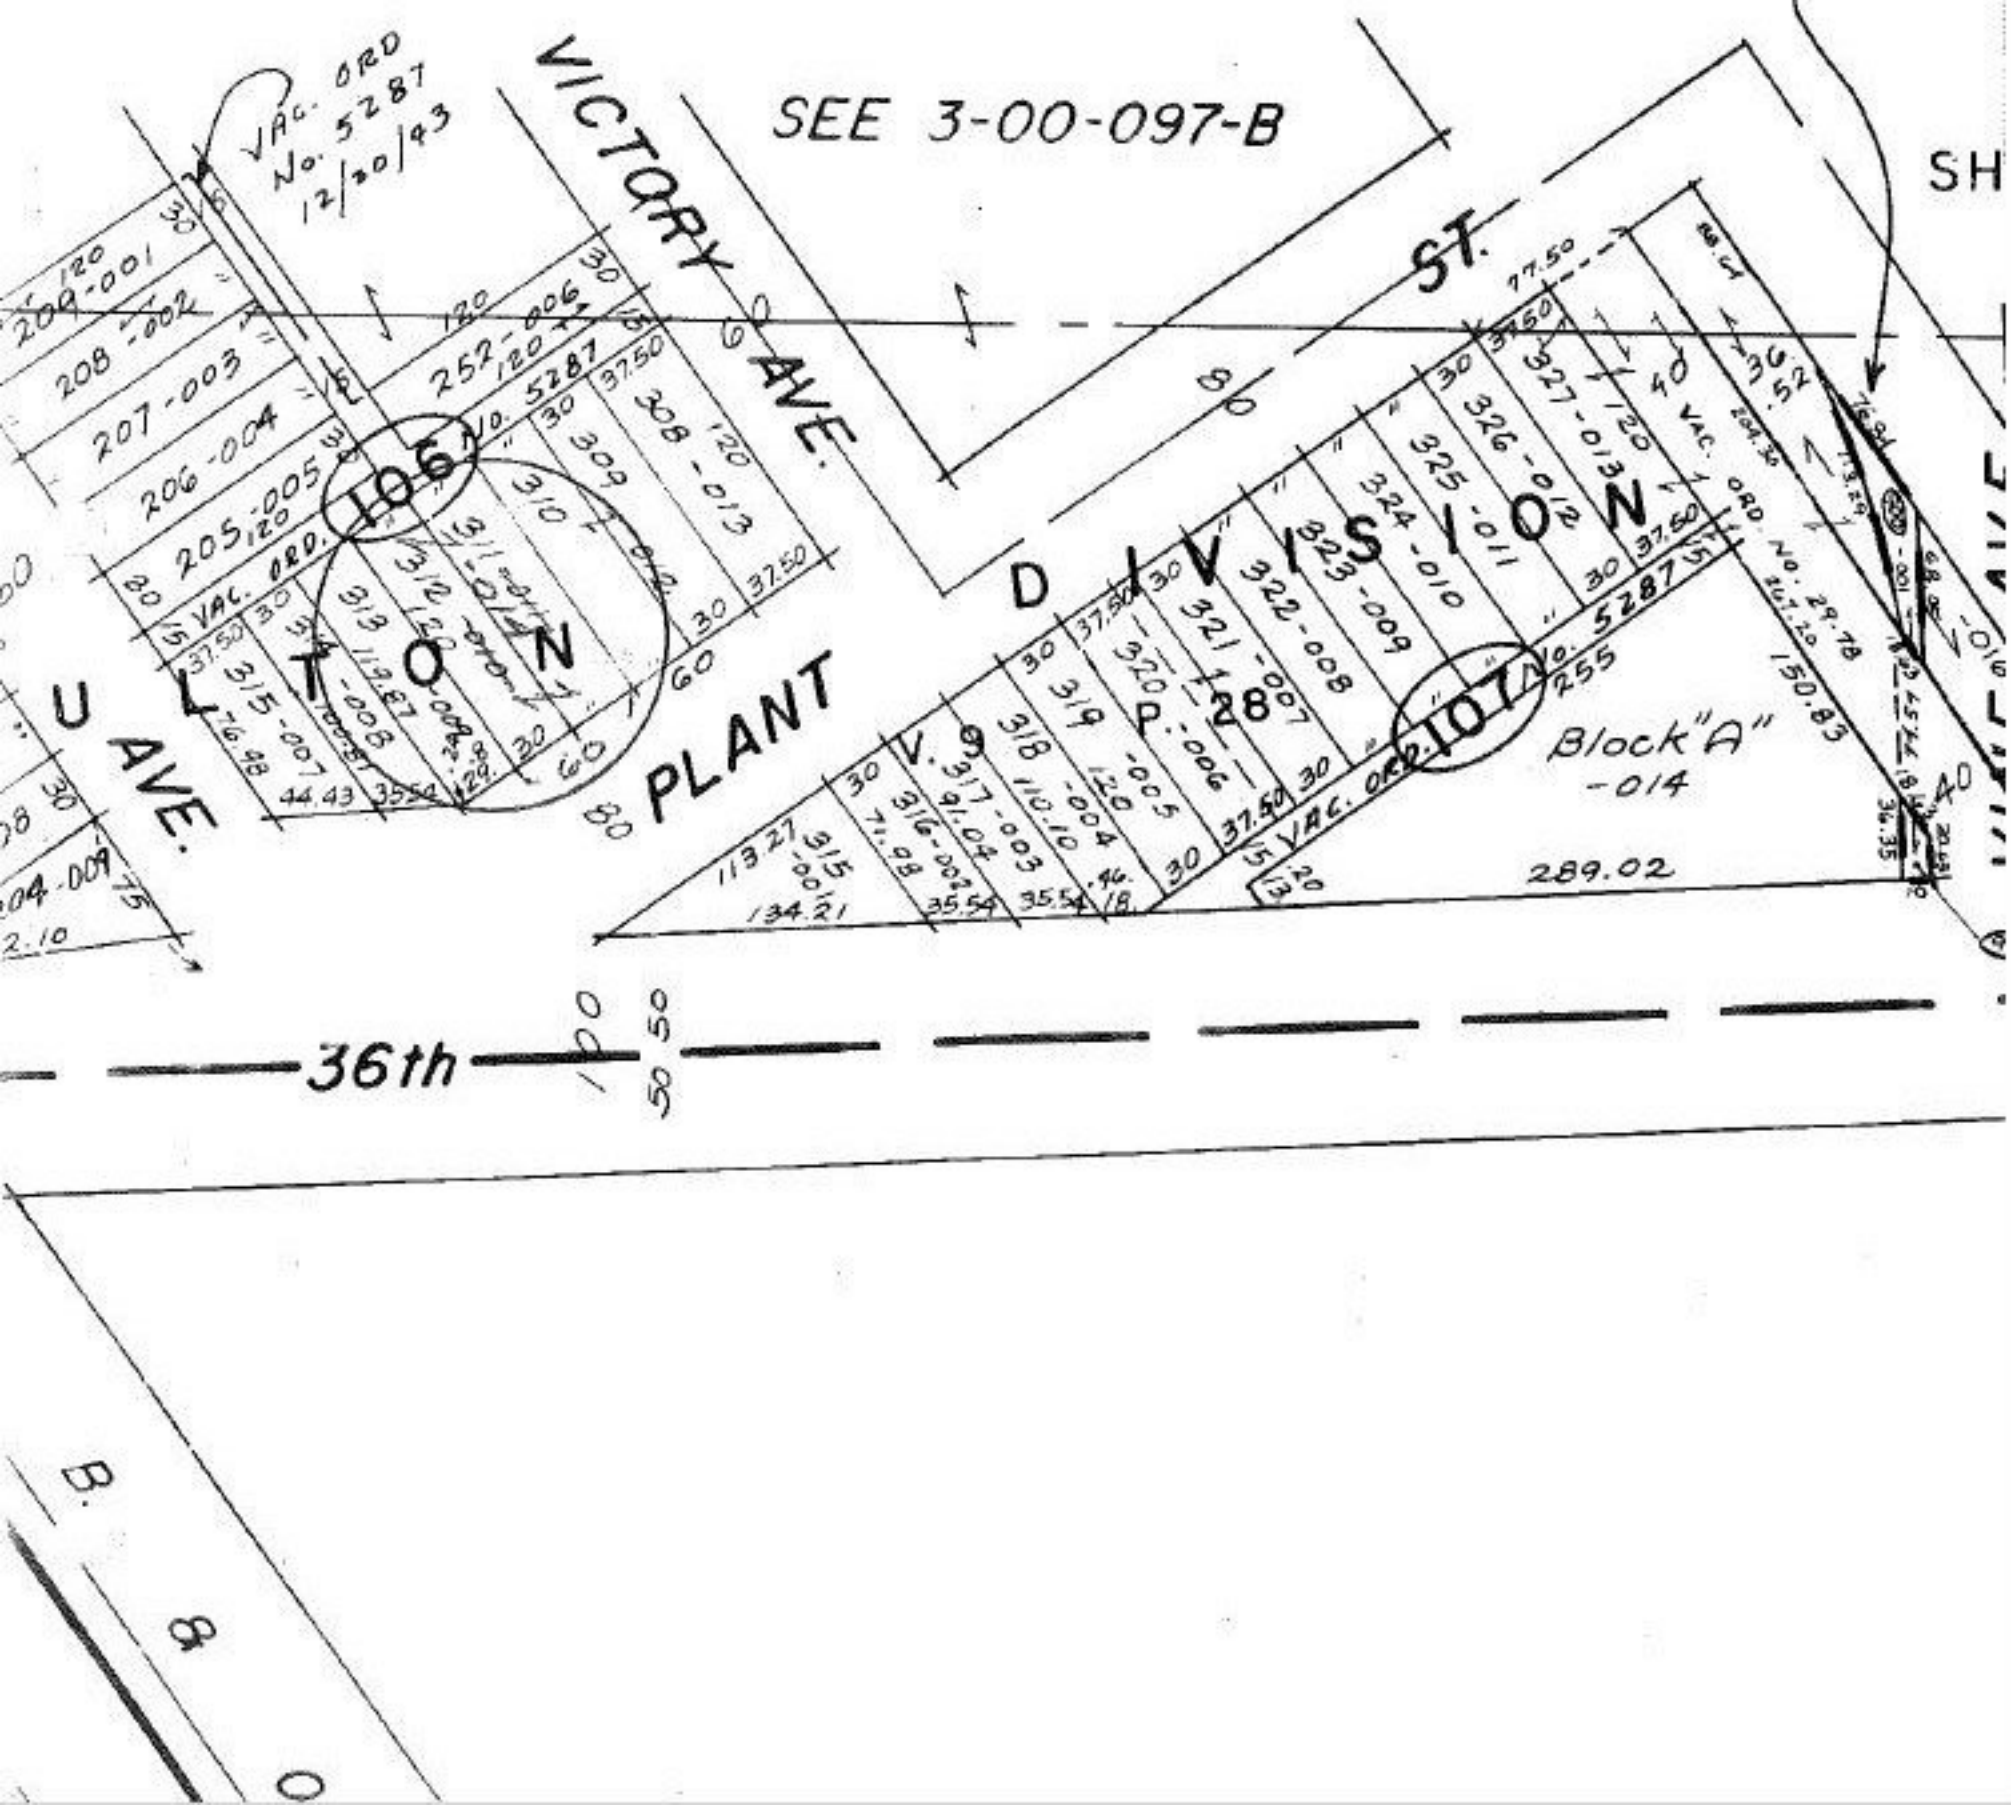
T.M.
5.22.80