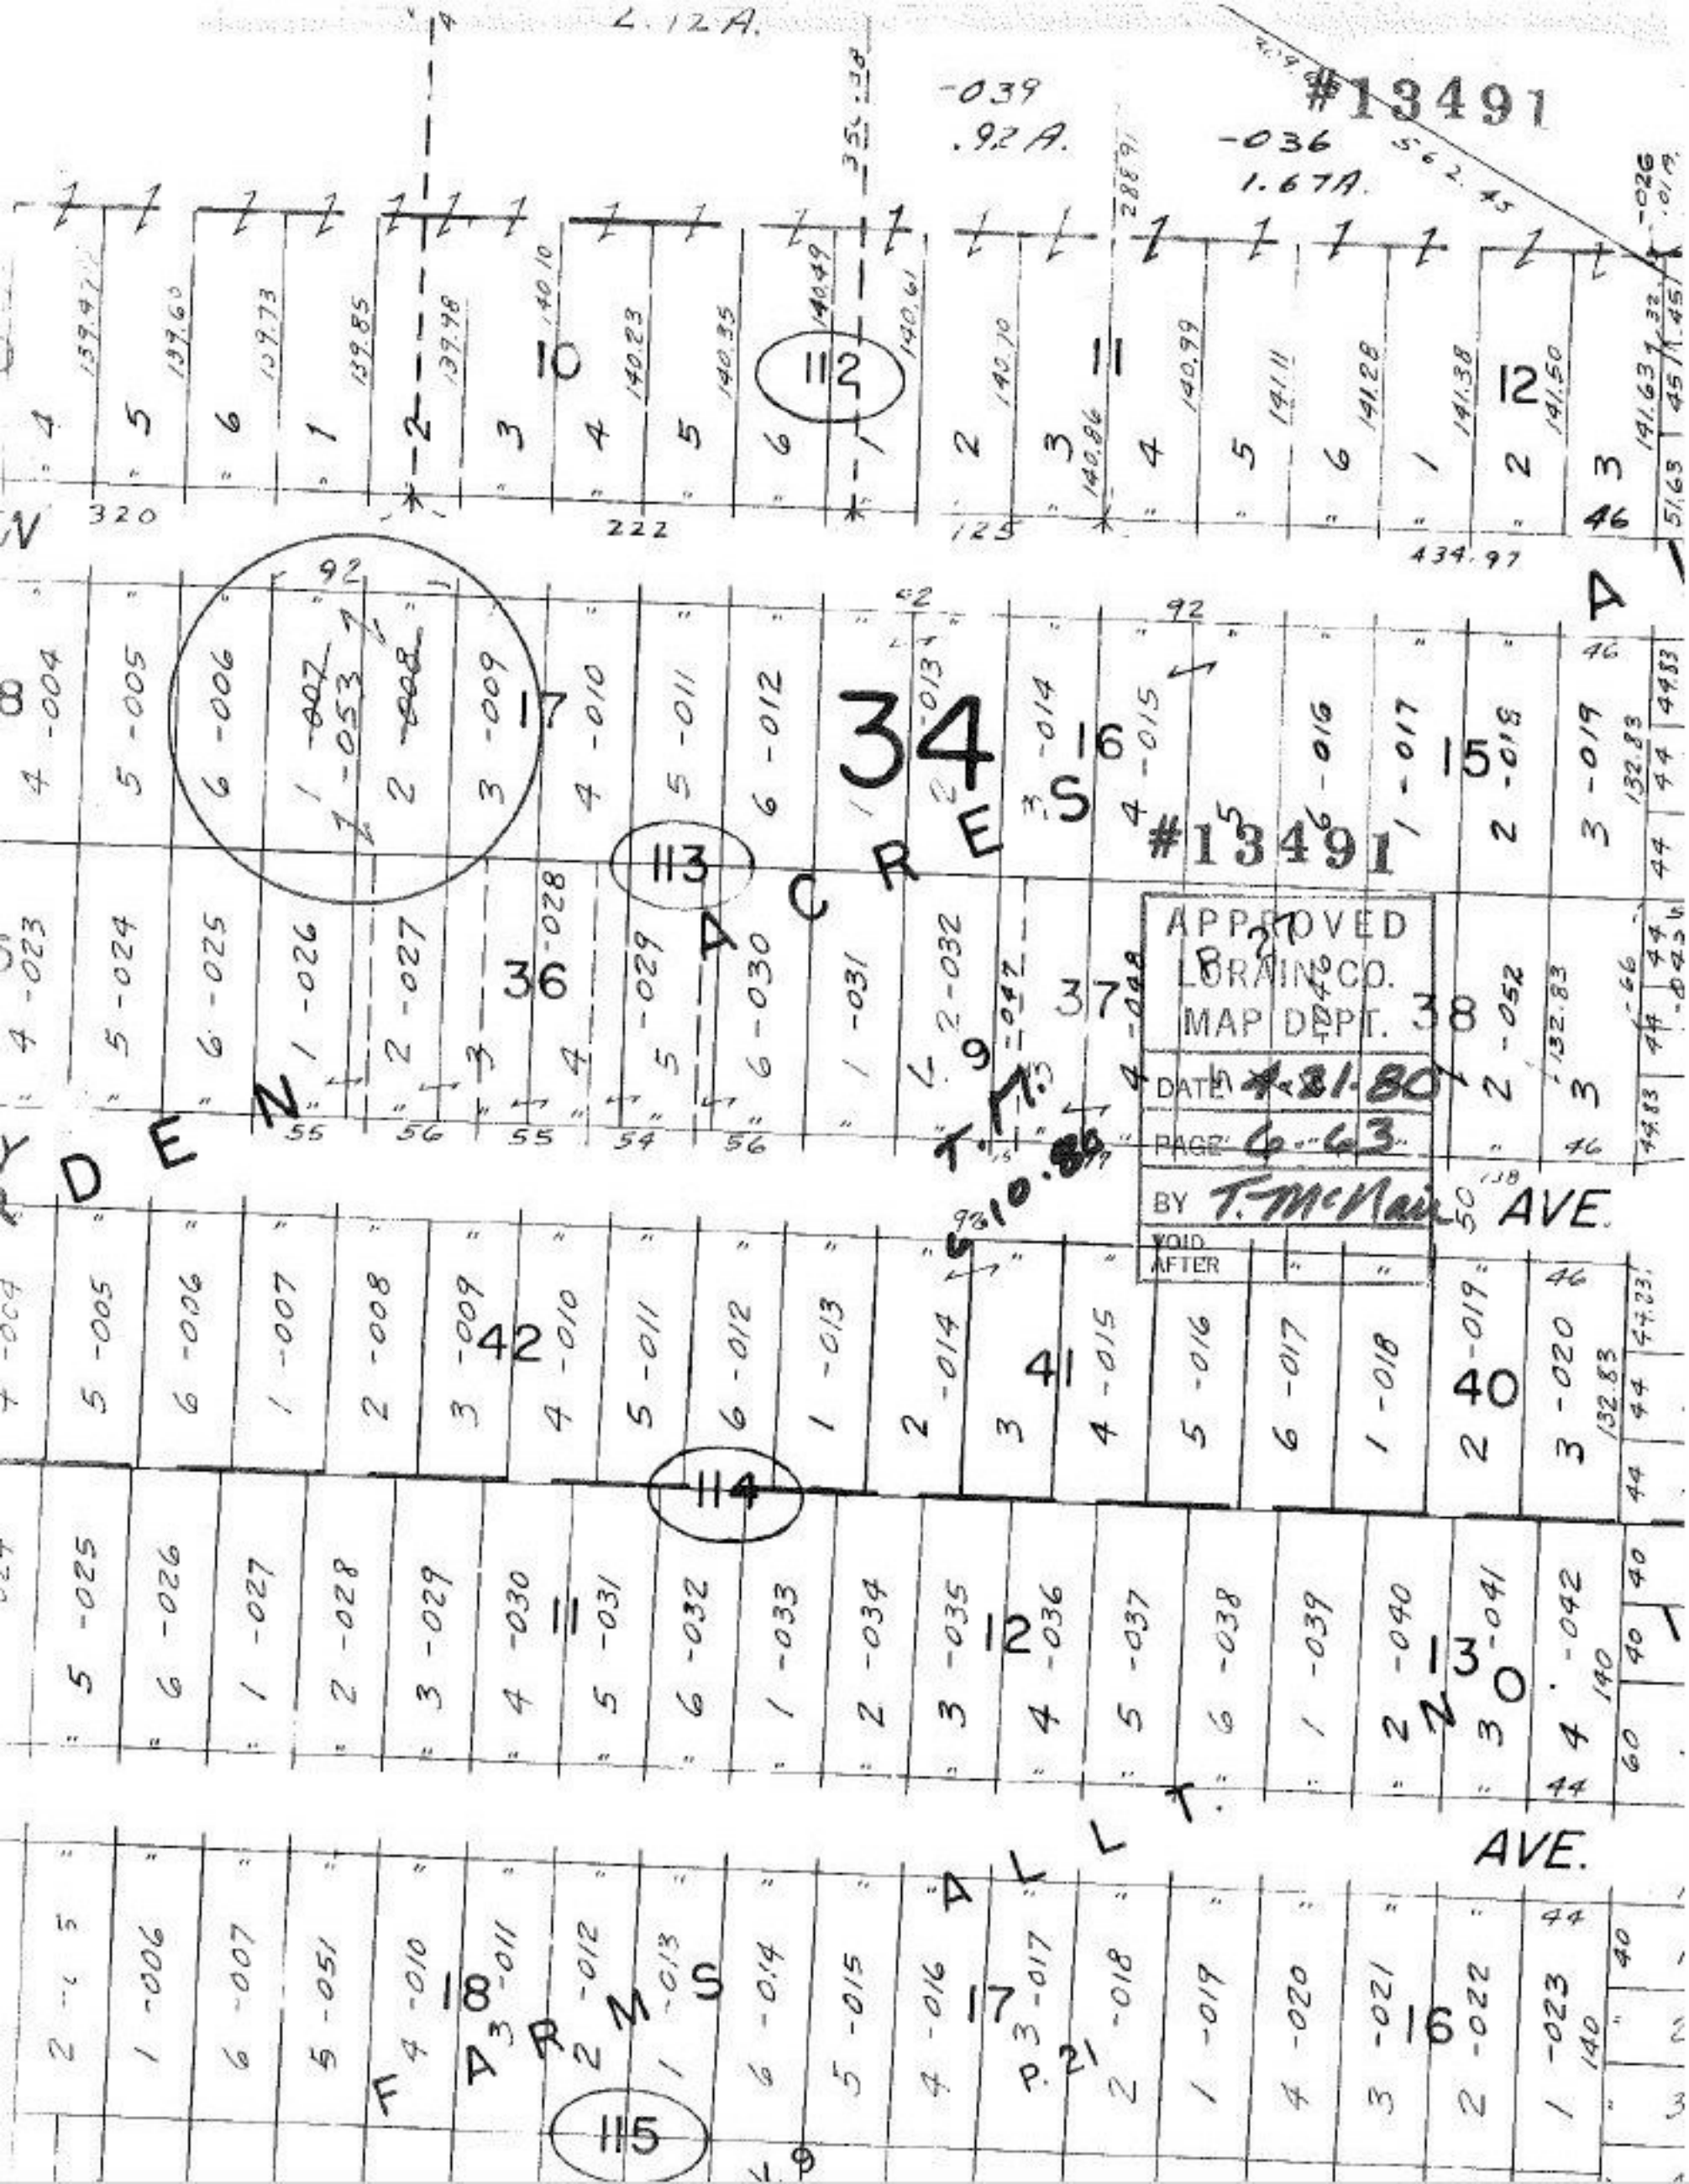
#13491
34 ACRES
APPROVED
LORAIN CO.
MAP DEPT.
DATE 4-21-80
PAGE 6-63
BY T. McNair
VOID AFTER
AVE.
AVE.