#13491

#13491

APPROVED
LORAIN CO.
MAP DEPT.
DATE 4-21-80
PAGE 6-105
BY T. McNair
VOID AFTER
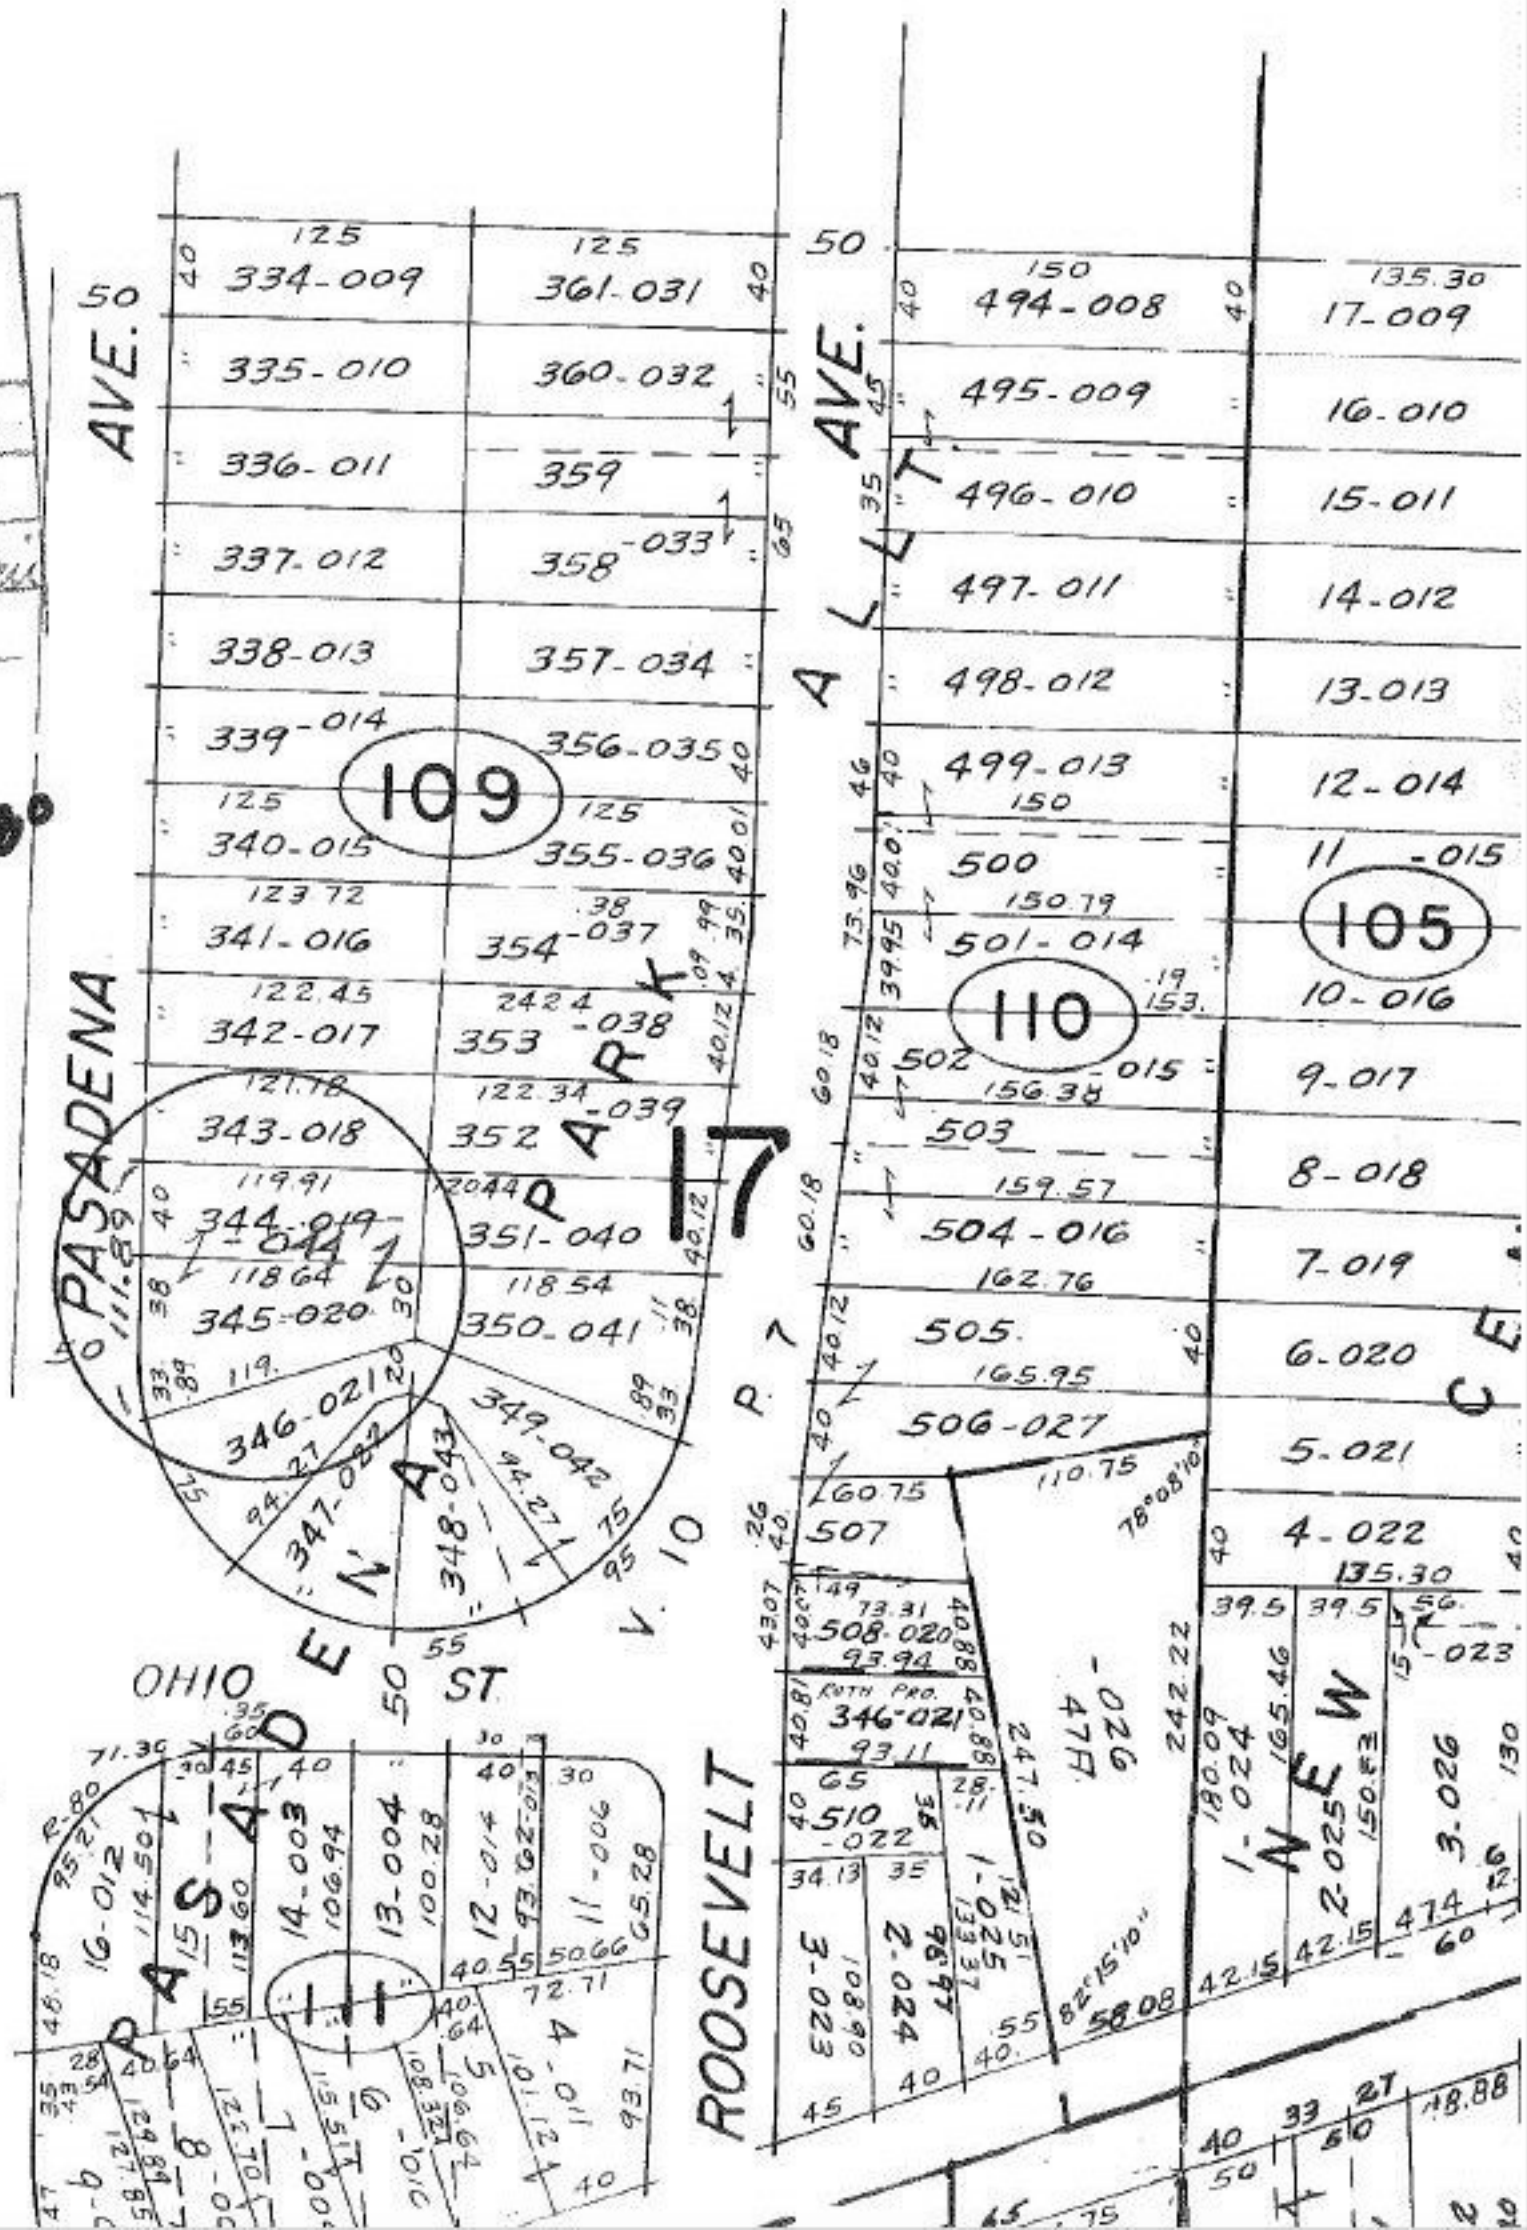
T.M.
6.10.80