#13492

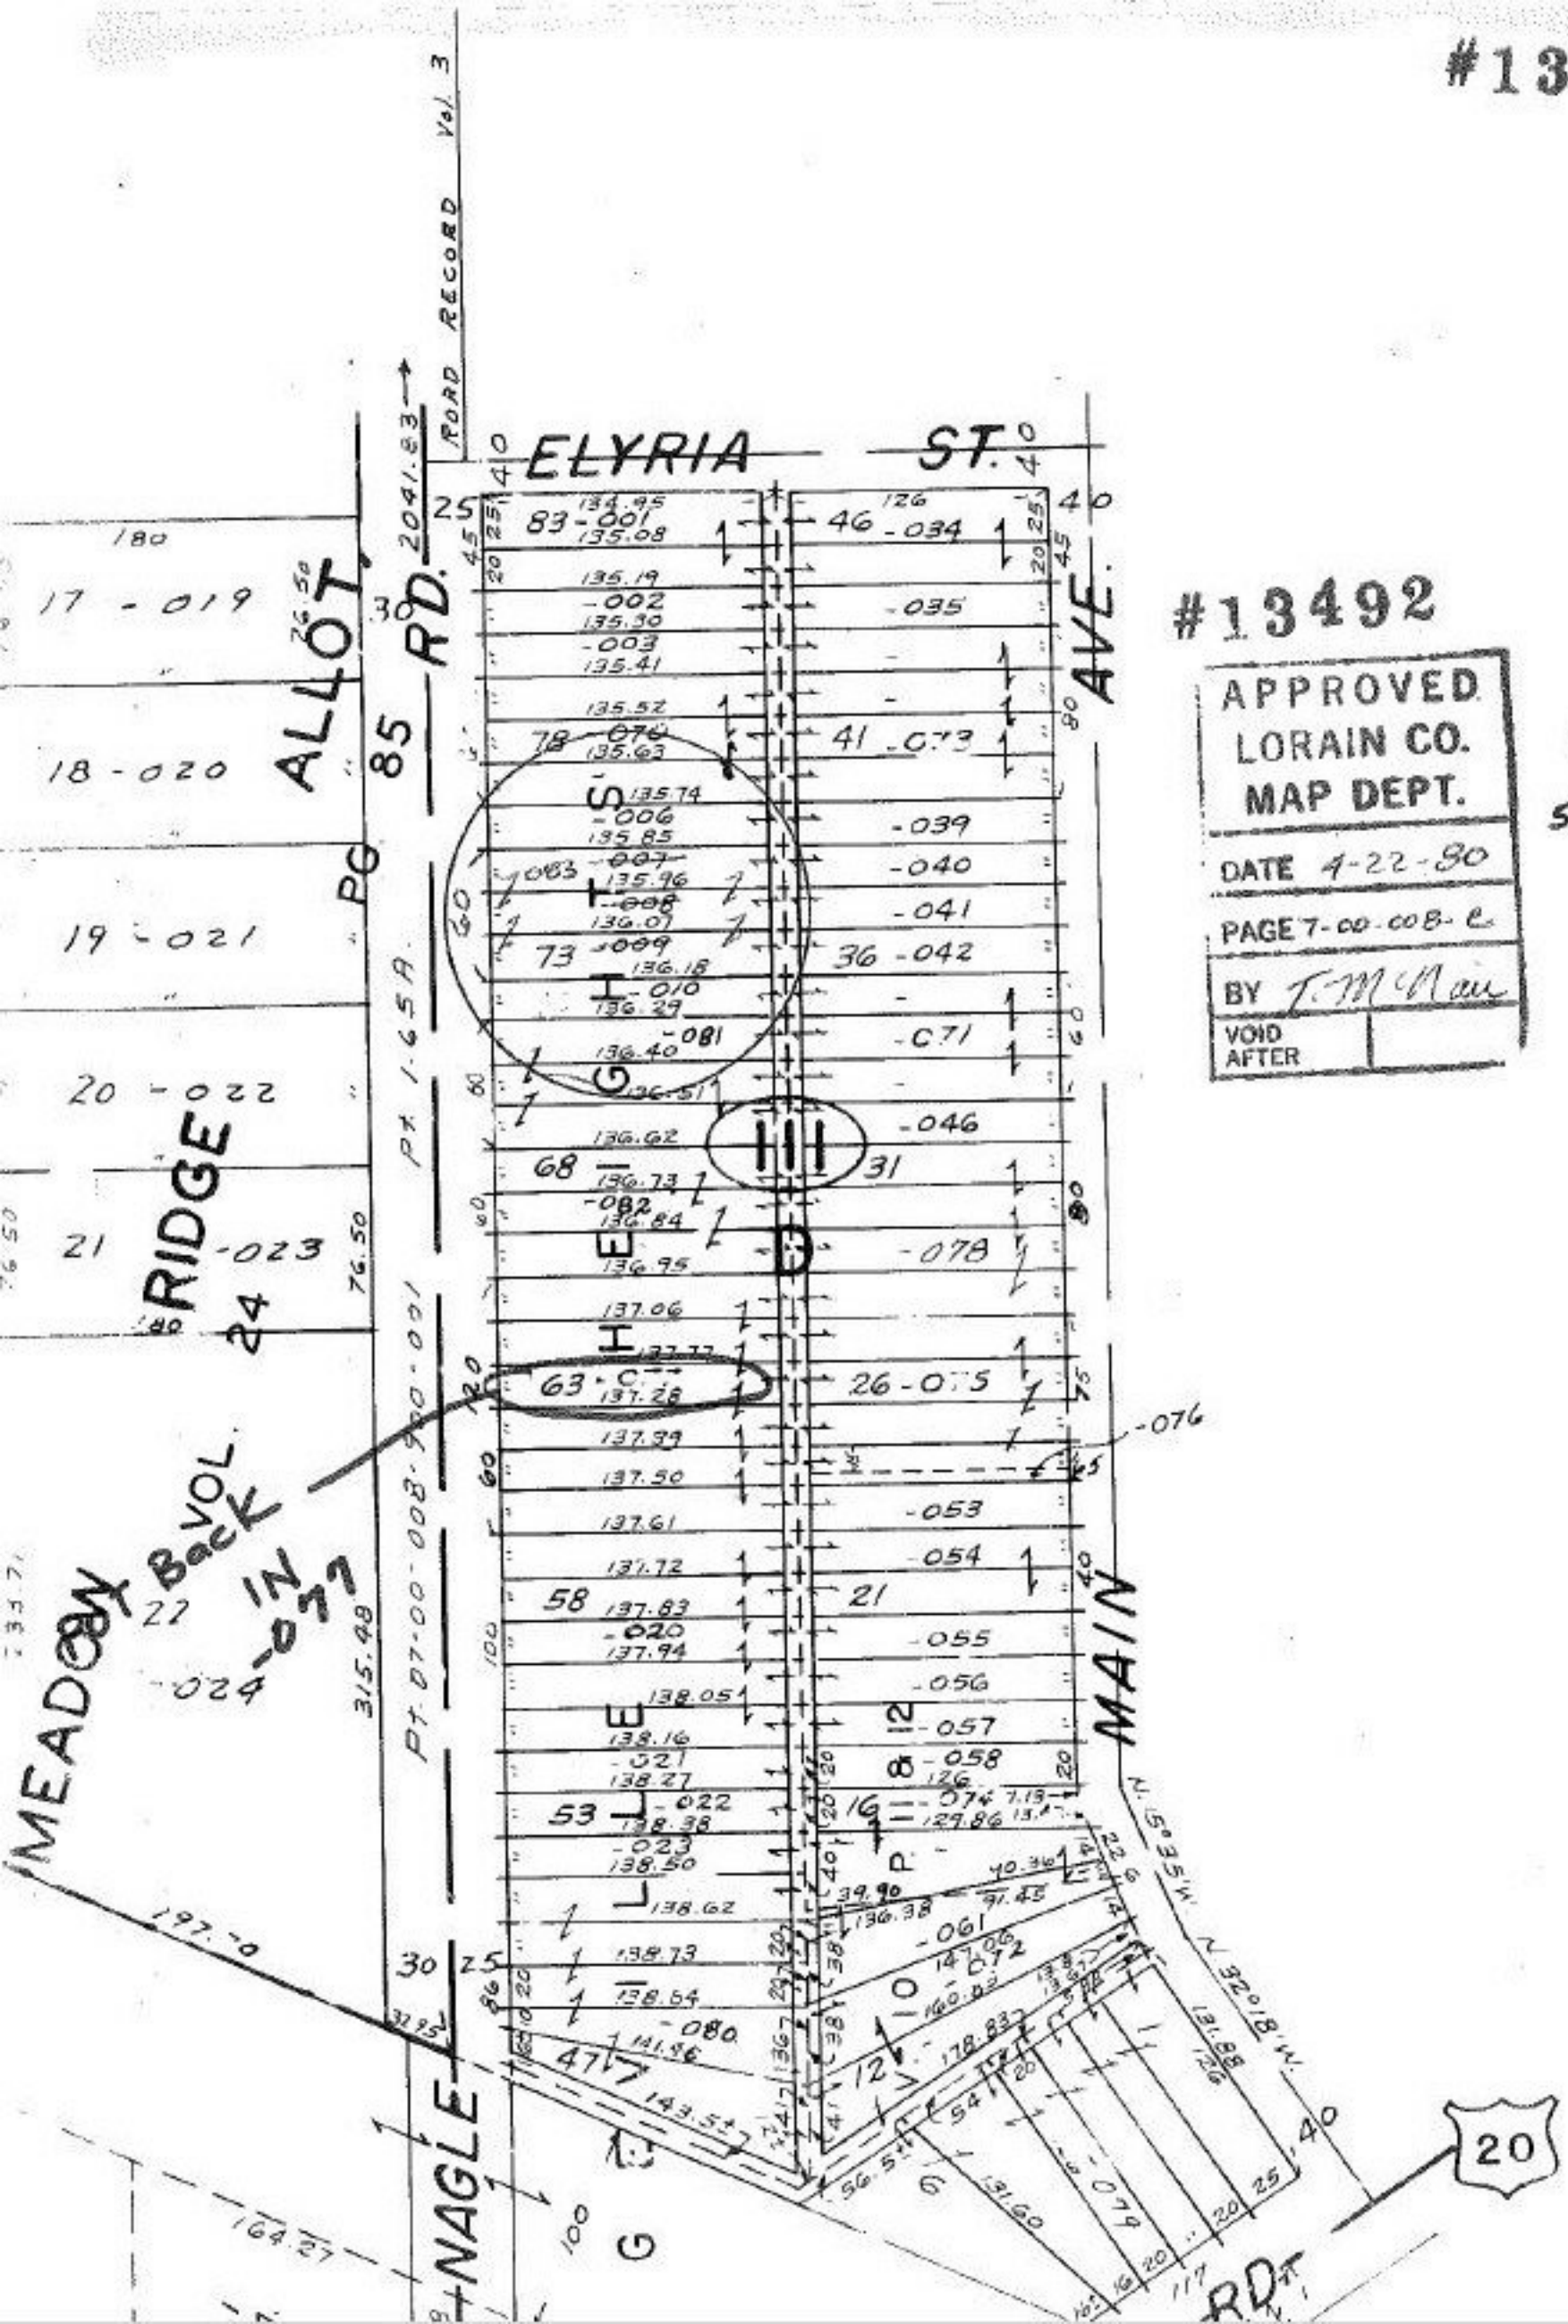

#13492

APPROVED
LORAIN CO.
MAP DEPT.

DATE 4-22-80

PAGE 7-00-008-C

BY T. McNair

VOID AFTER

T.M.
5.29-80