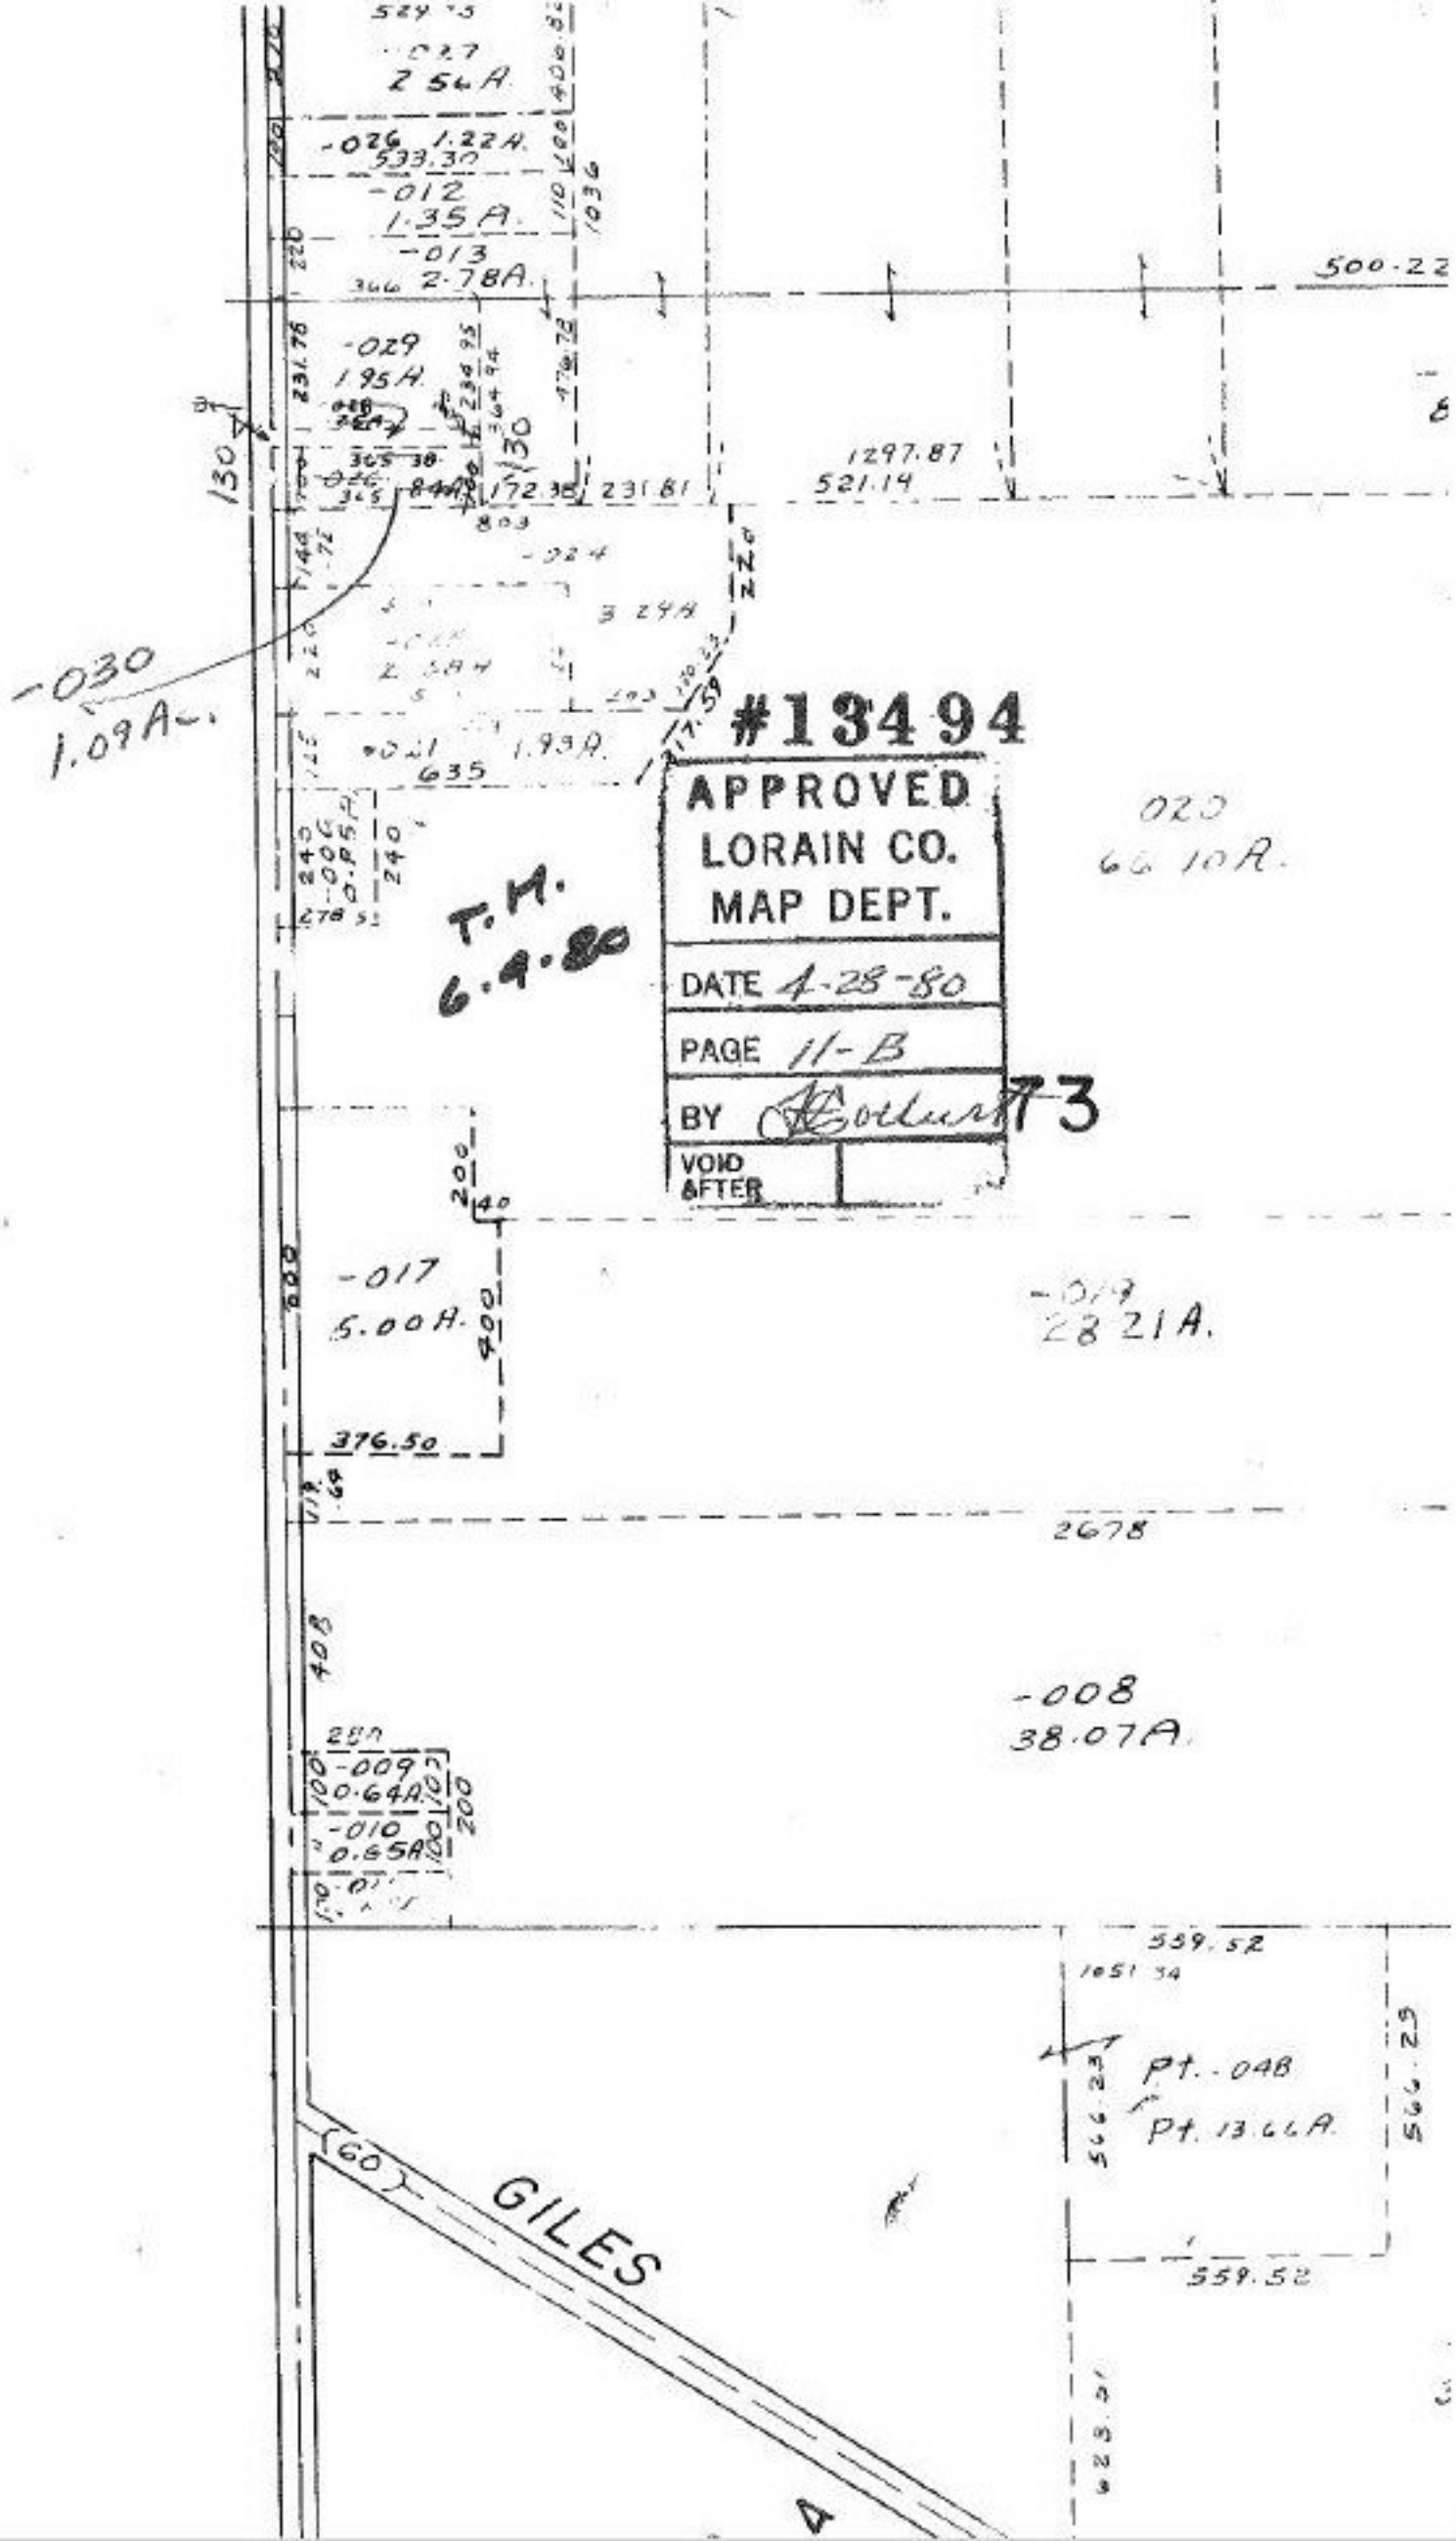

-027
2.56A.
-026 1.22A.
533.30
-012
1.35A.
-013
2.78A.
500.22
-029
1.95A.
1297.87
521.14
231.81
-030
1.09A.
3.29A
1.93A.
635
#13494
APPROVED
LORAIN CO.
MAP DEPT.
DATE 4-28-80
PAGE 11-B
BY
VOID AFTER
T.M.
6.4.80
020
66.10A.
-017
5.00A.
376.50
-019
28.21A.
2678
-008
38.07A.
-009
0.64A.
-010
0.65A.
559.52
Pt. -04B
Pt. 13.66A.
GILES

11-B