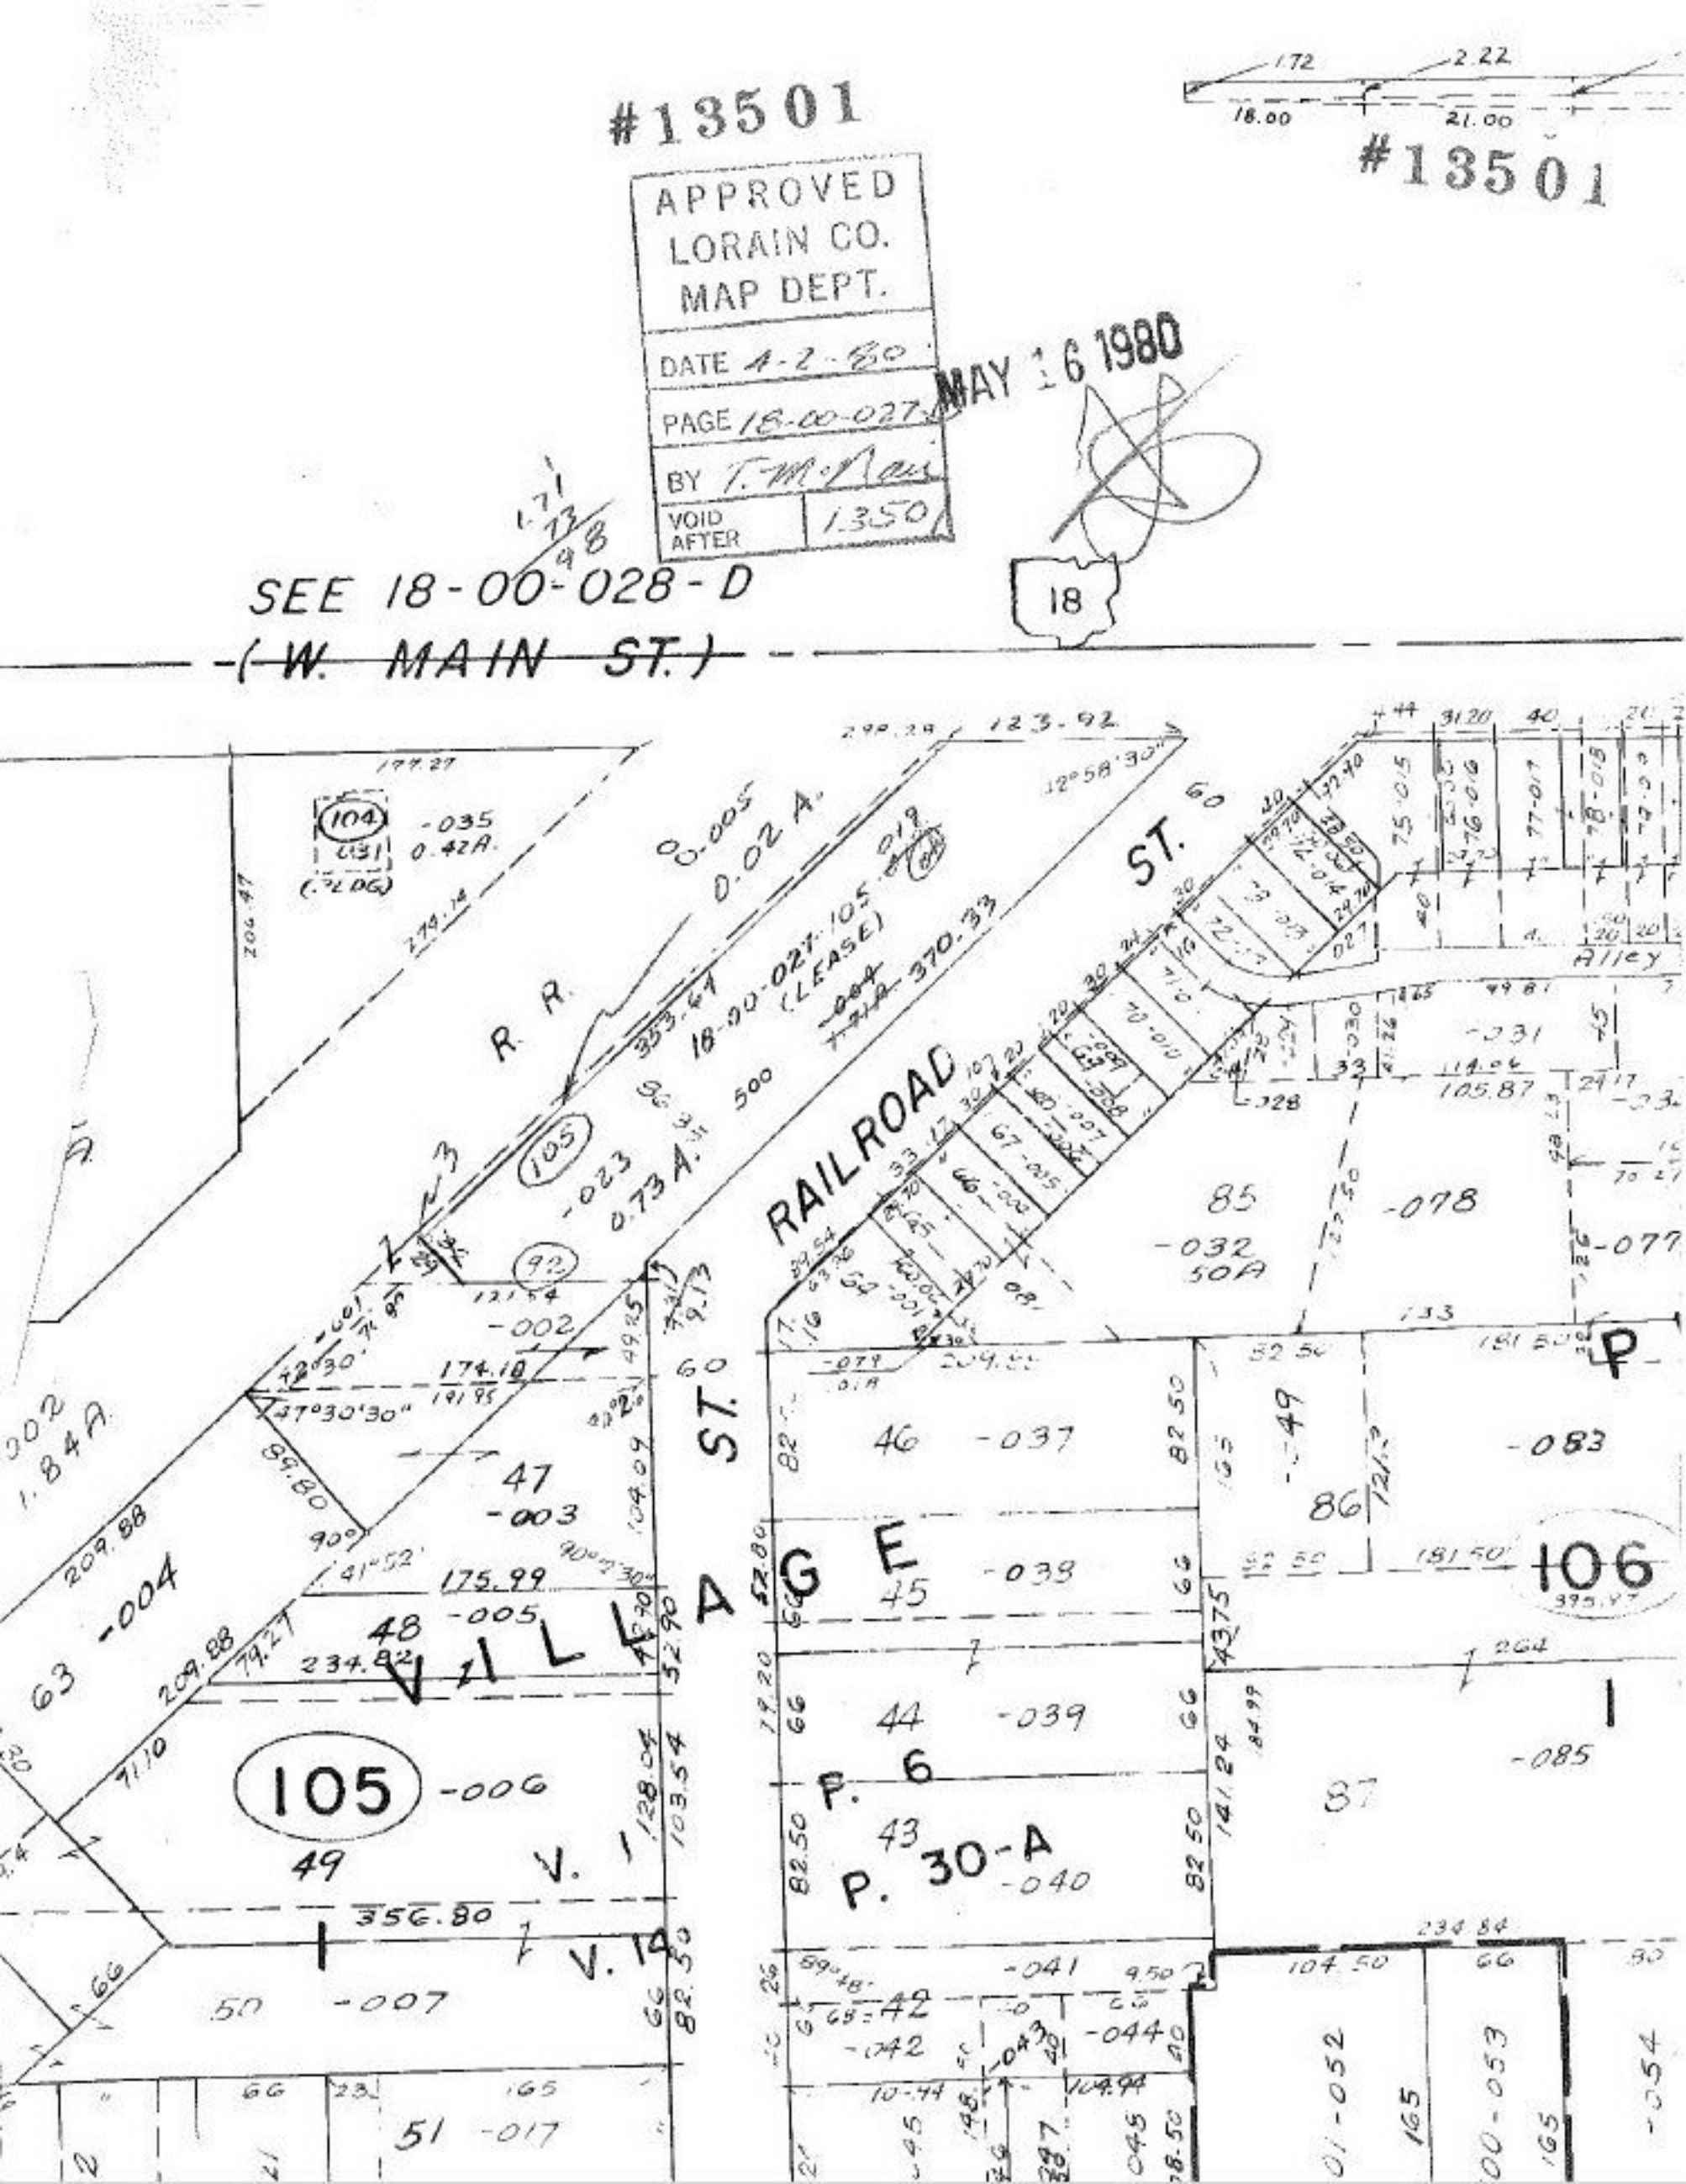

#13501
APPROVED
LORAIN CO.
MAP DEPT.
DATE 4-2-80
PAGE 18-00-027
BY T. McNair
VOID AFTER 1350
MAY 16 1980
#13501
18
SEE 18-00-028-D
(W. MAIN ST.)
RAILROAD ST.
R. R.
VILLAGE ST.
Alley
105
106
P. 6
P. 30-A
V. 1
V. 14