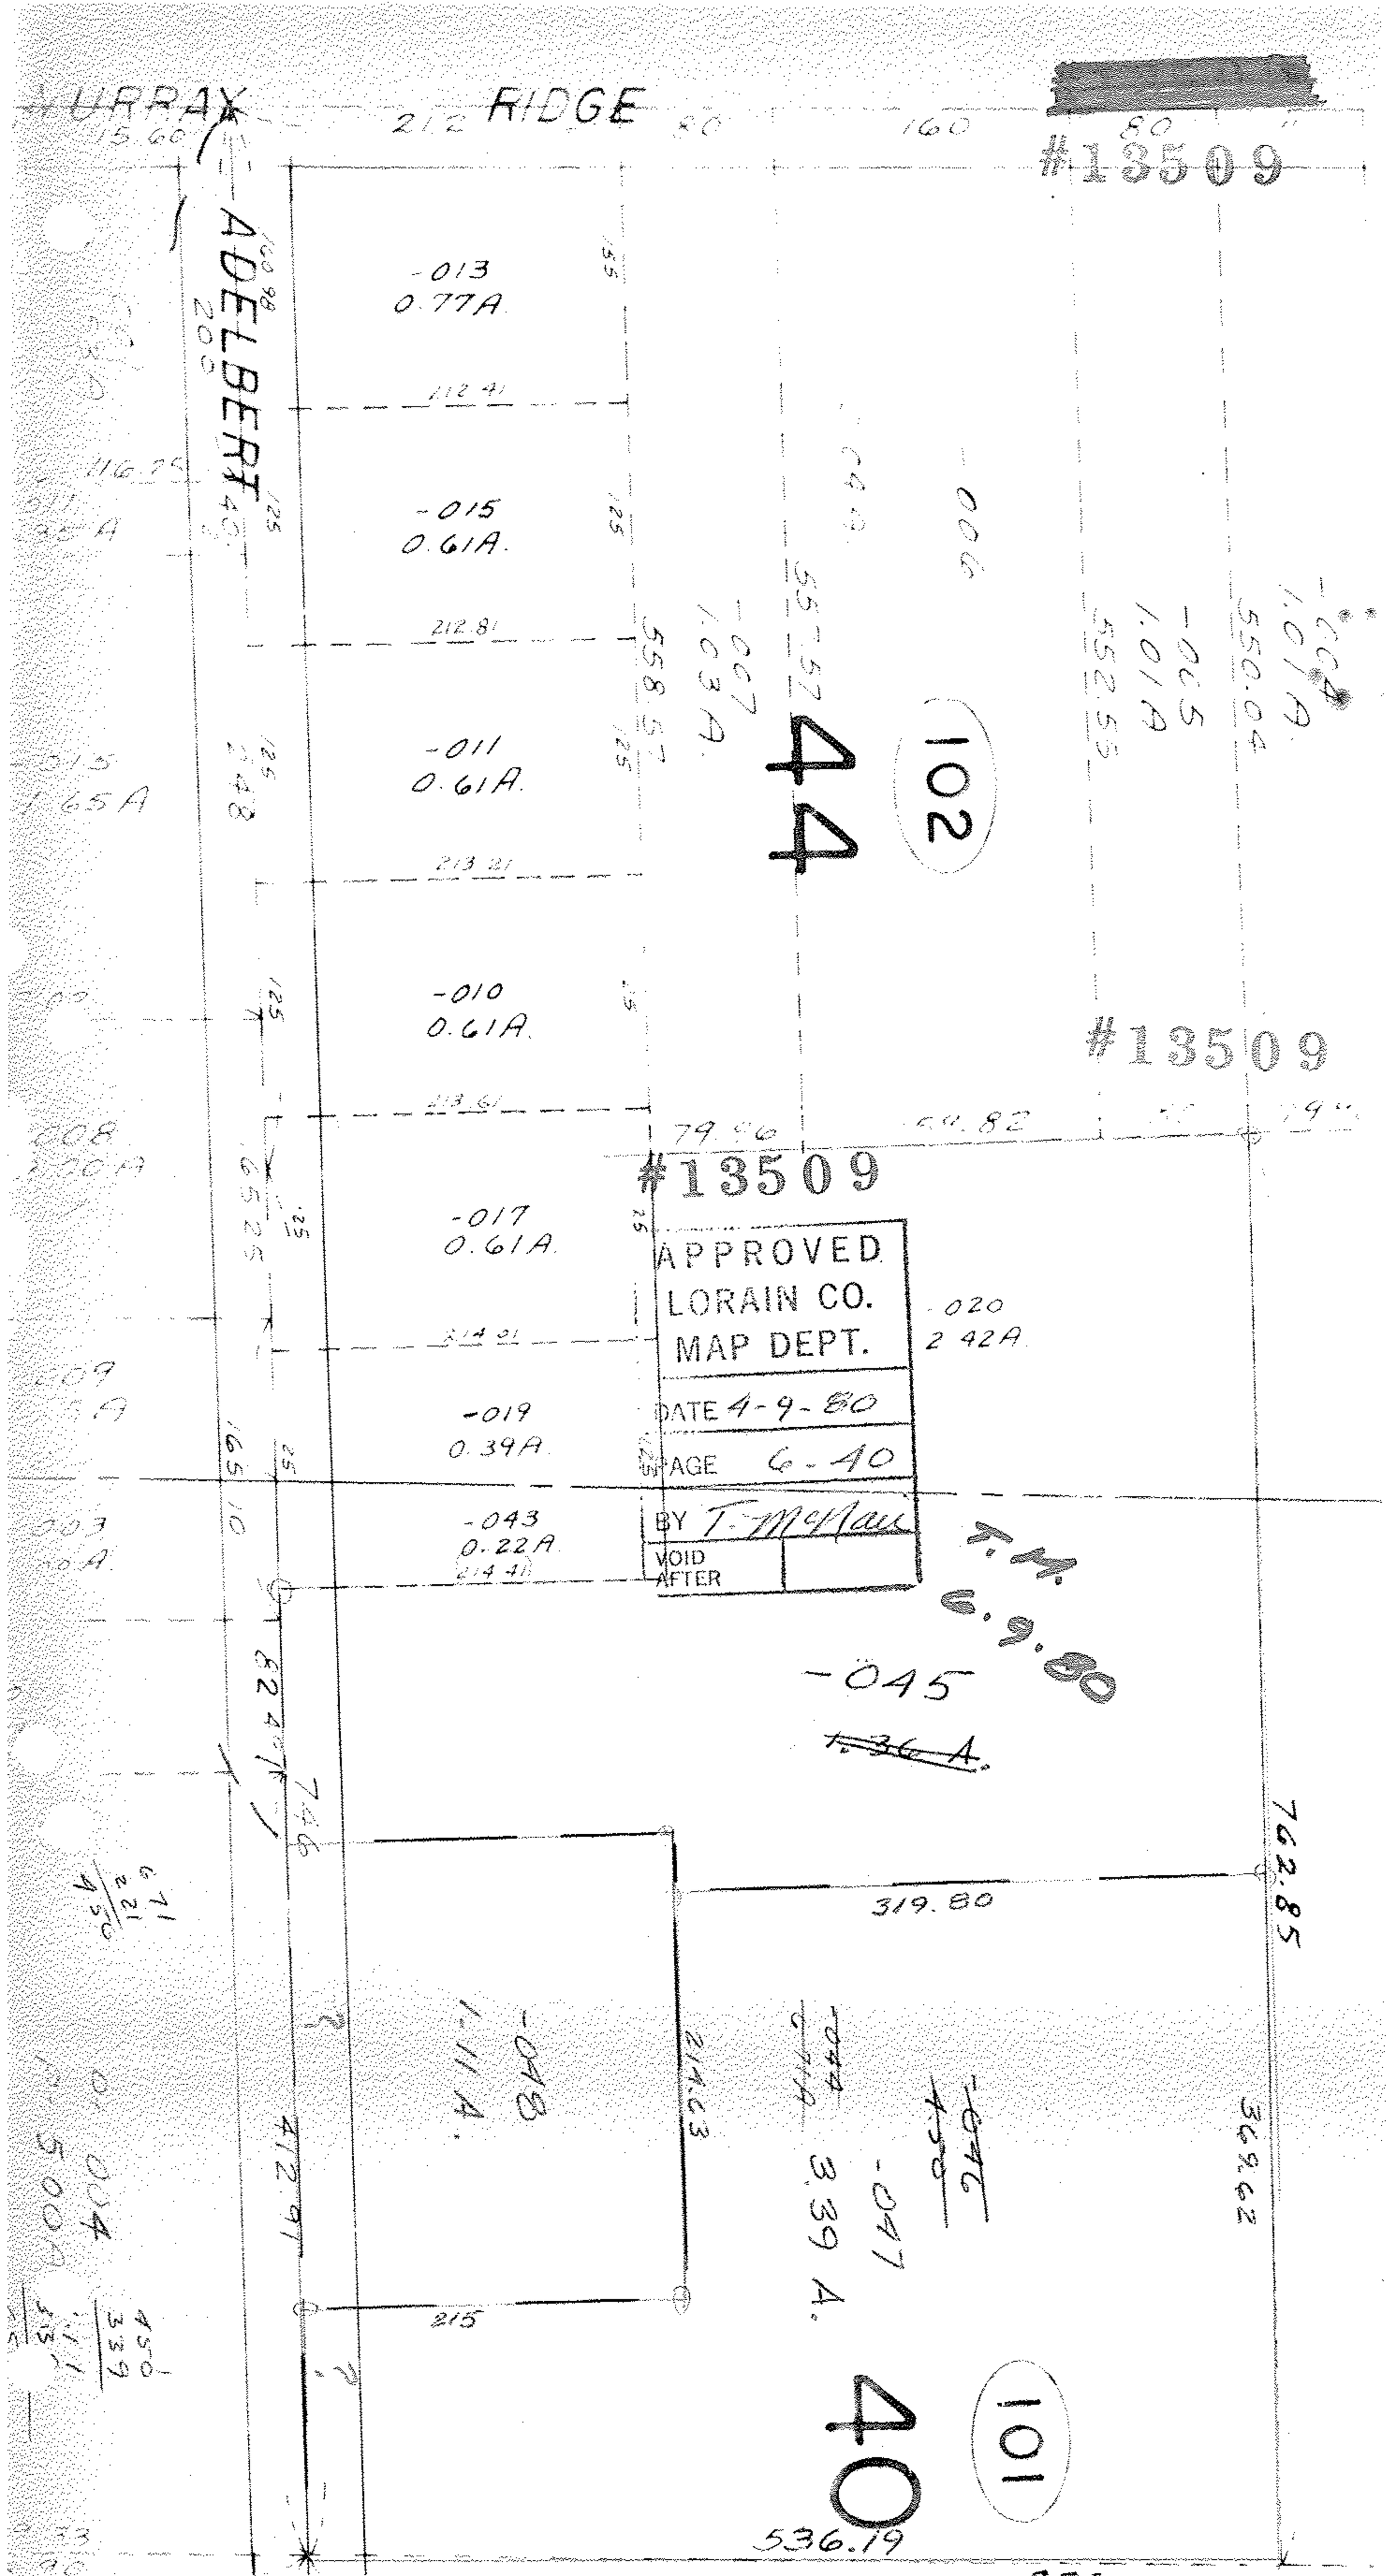

[redacted]
#13509
URRAY RIDGE
ADELBERT
-013
0.77A
-015
0.61A
-011
0.61A
-010
0.61A
-017
0.61A
-019
0.39A
-043
0.22A
-020
2.42A
-045
~~1.36 A.~~
-048
1.11 A.
-047
3.39 A.
44
102
40
101
#13509
#13509
APPROVED
LORAIN CO.
MAP DEPT.
DATE 4-9-80
PAGE 6-40
BY T. McNair
VOID AFTER
T.M.
6.9.80
319.80
762.85
369.62
536.19