#13515

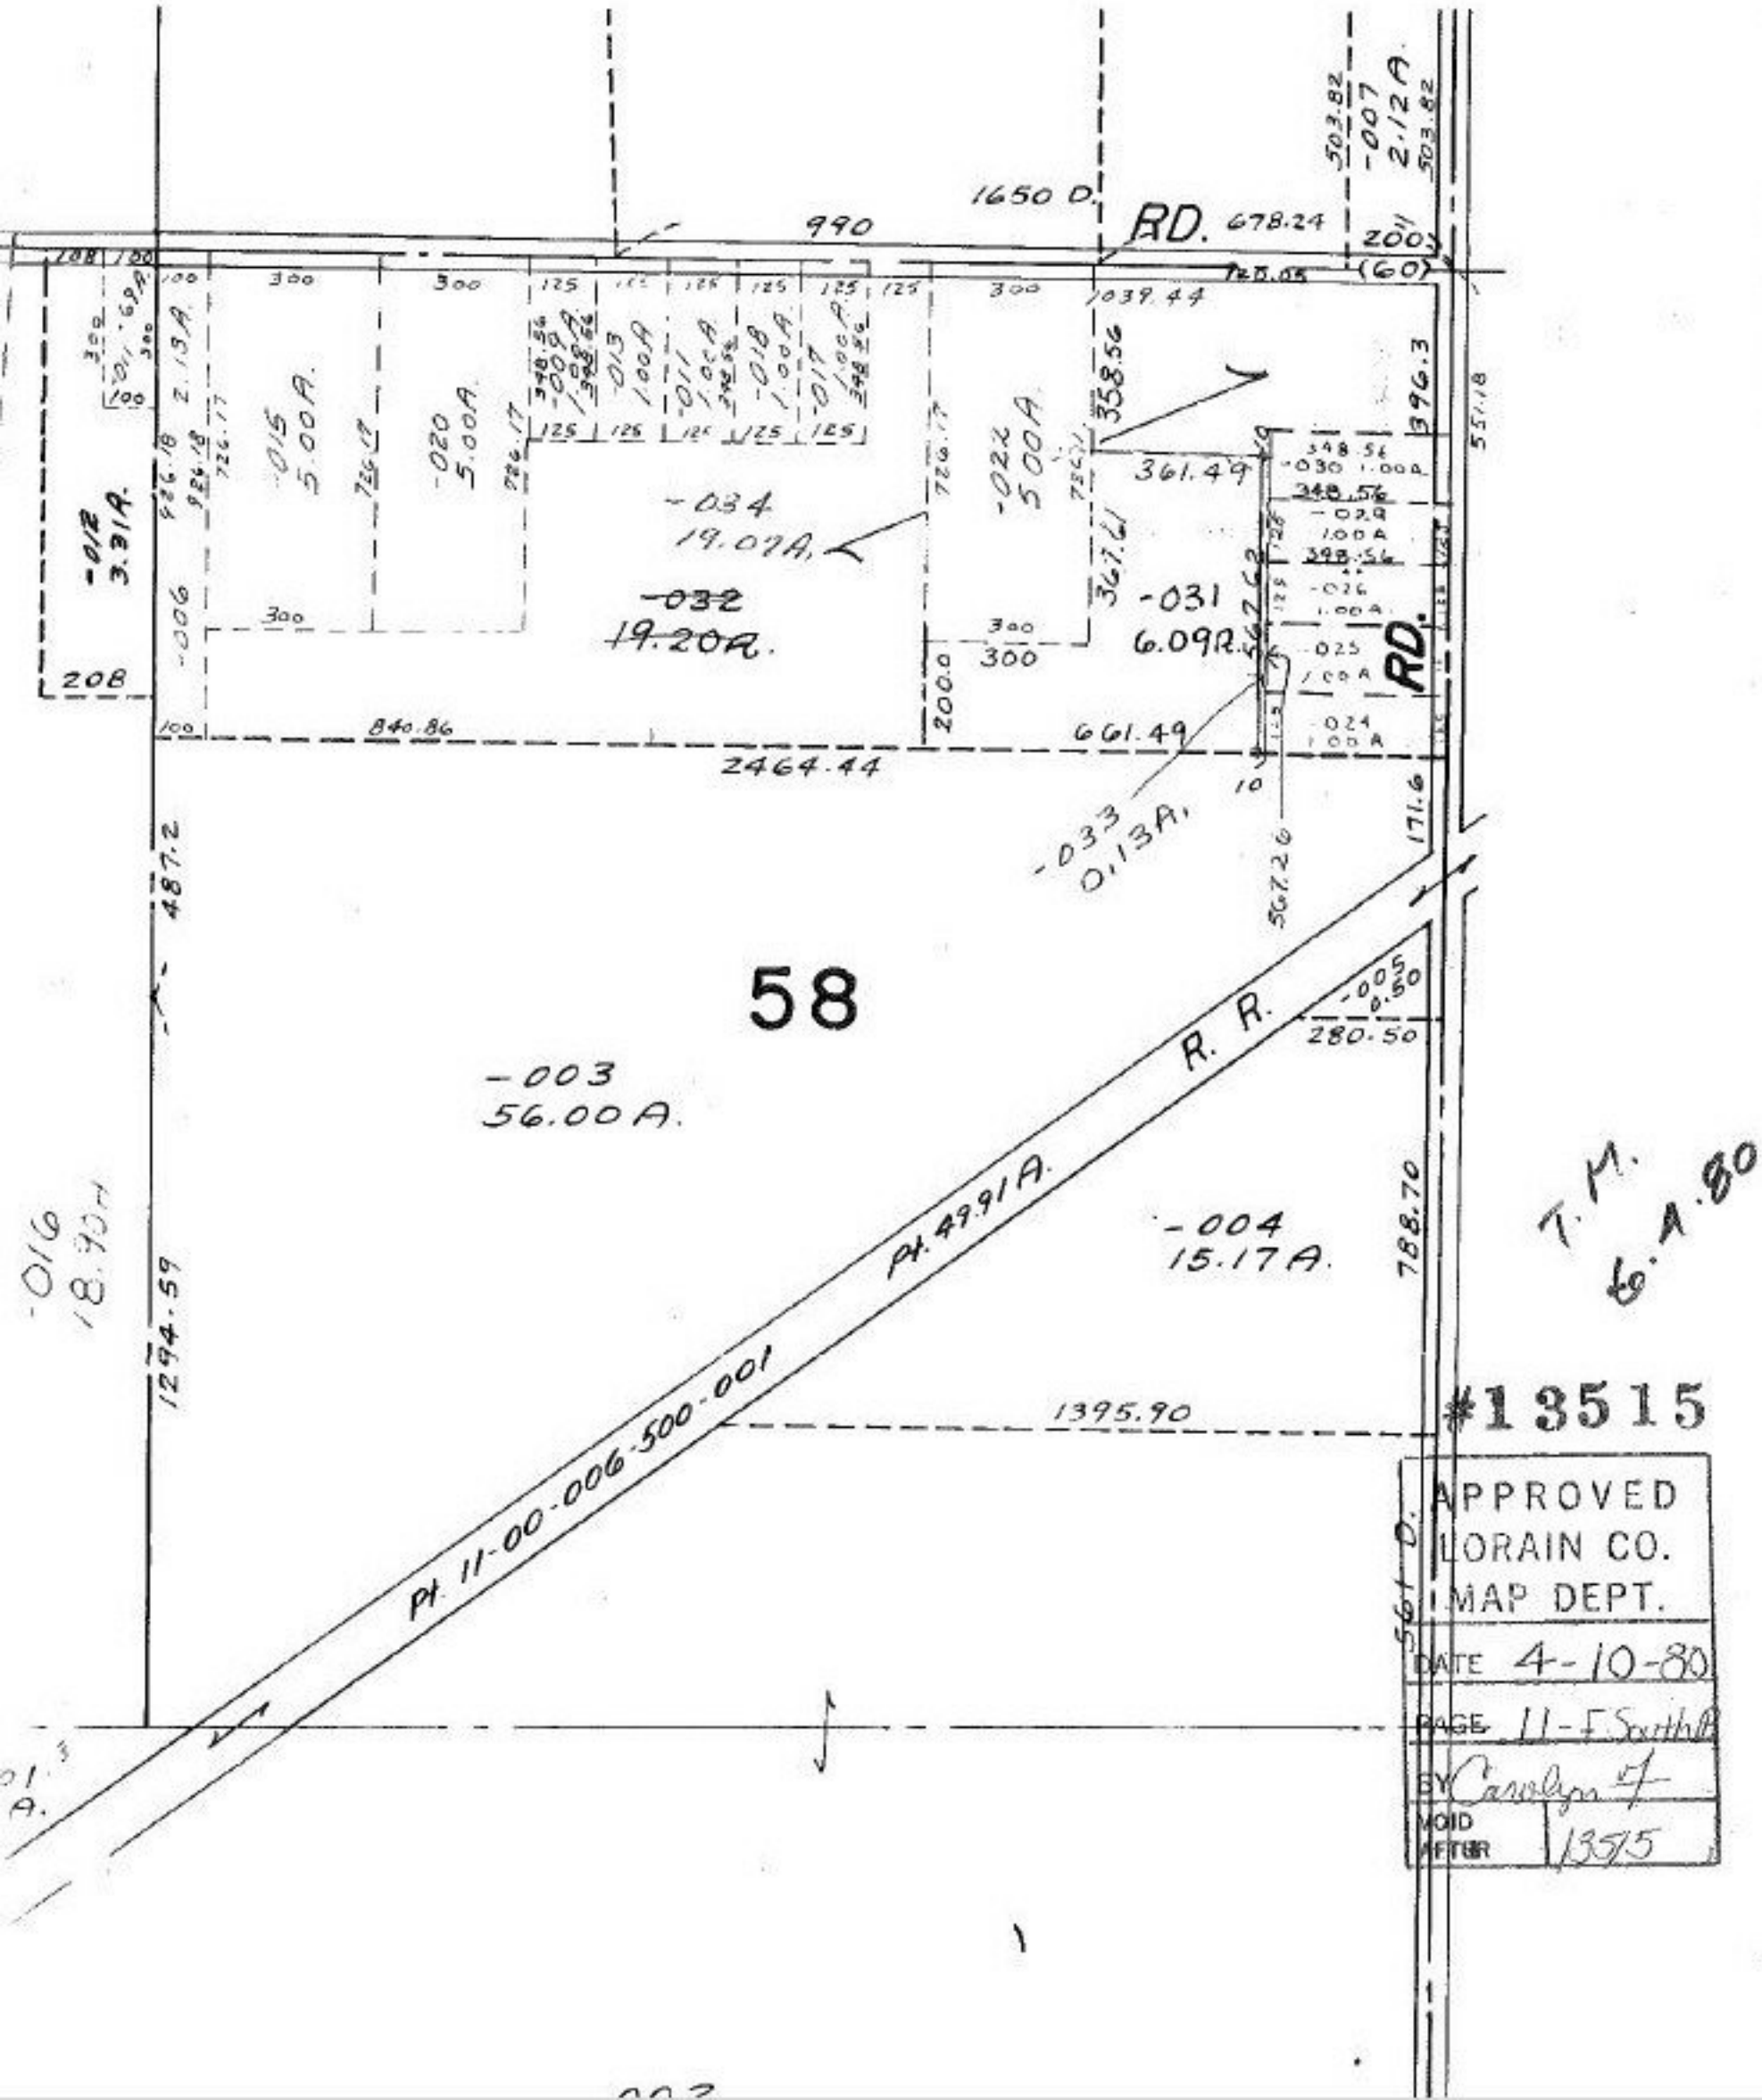

#13515

APPROVED
LORAIN CO.
MAP DEPT.
DATE 4-10-80
PAGE 11-F South A
BY Carolyn F
VOID AFTER 13515