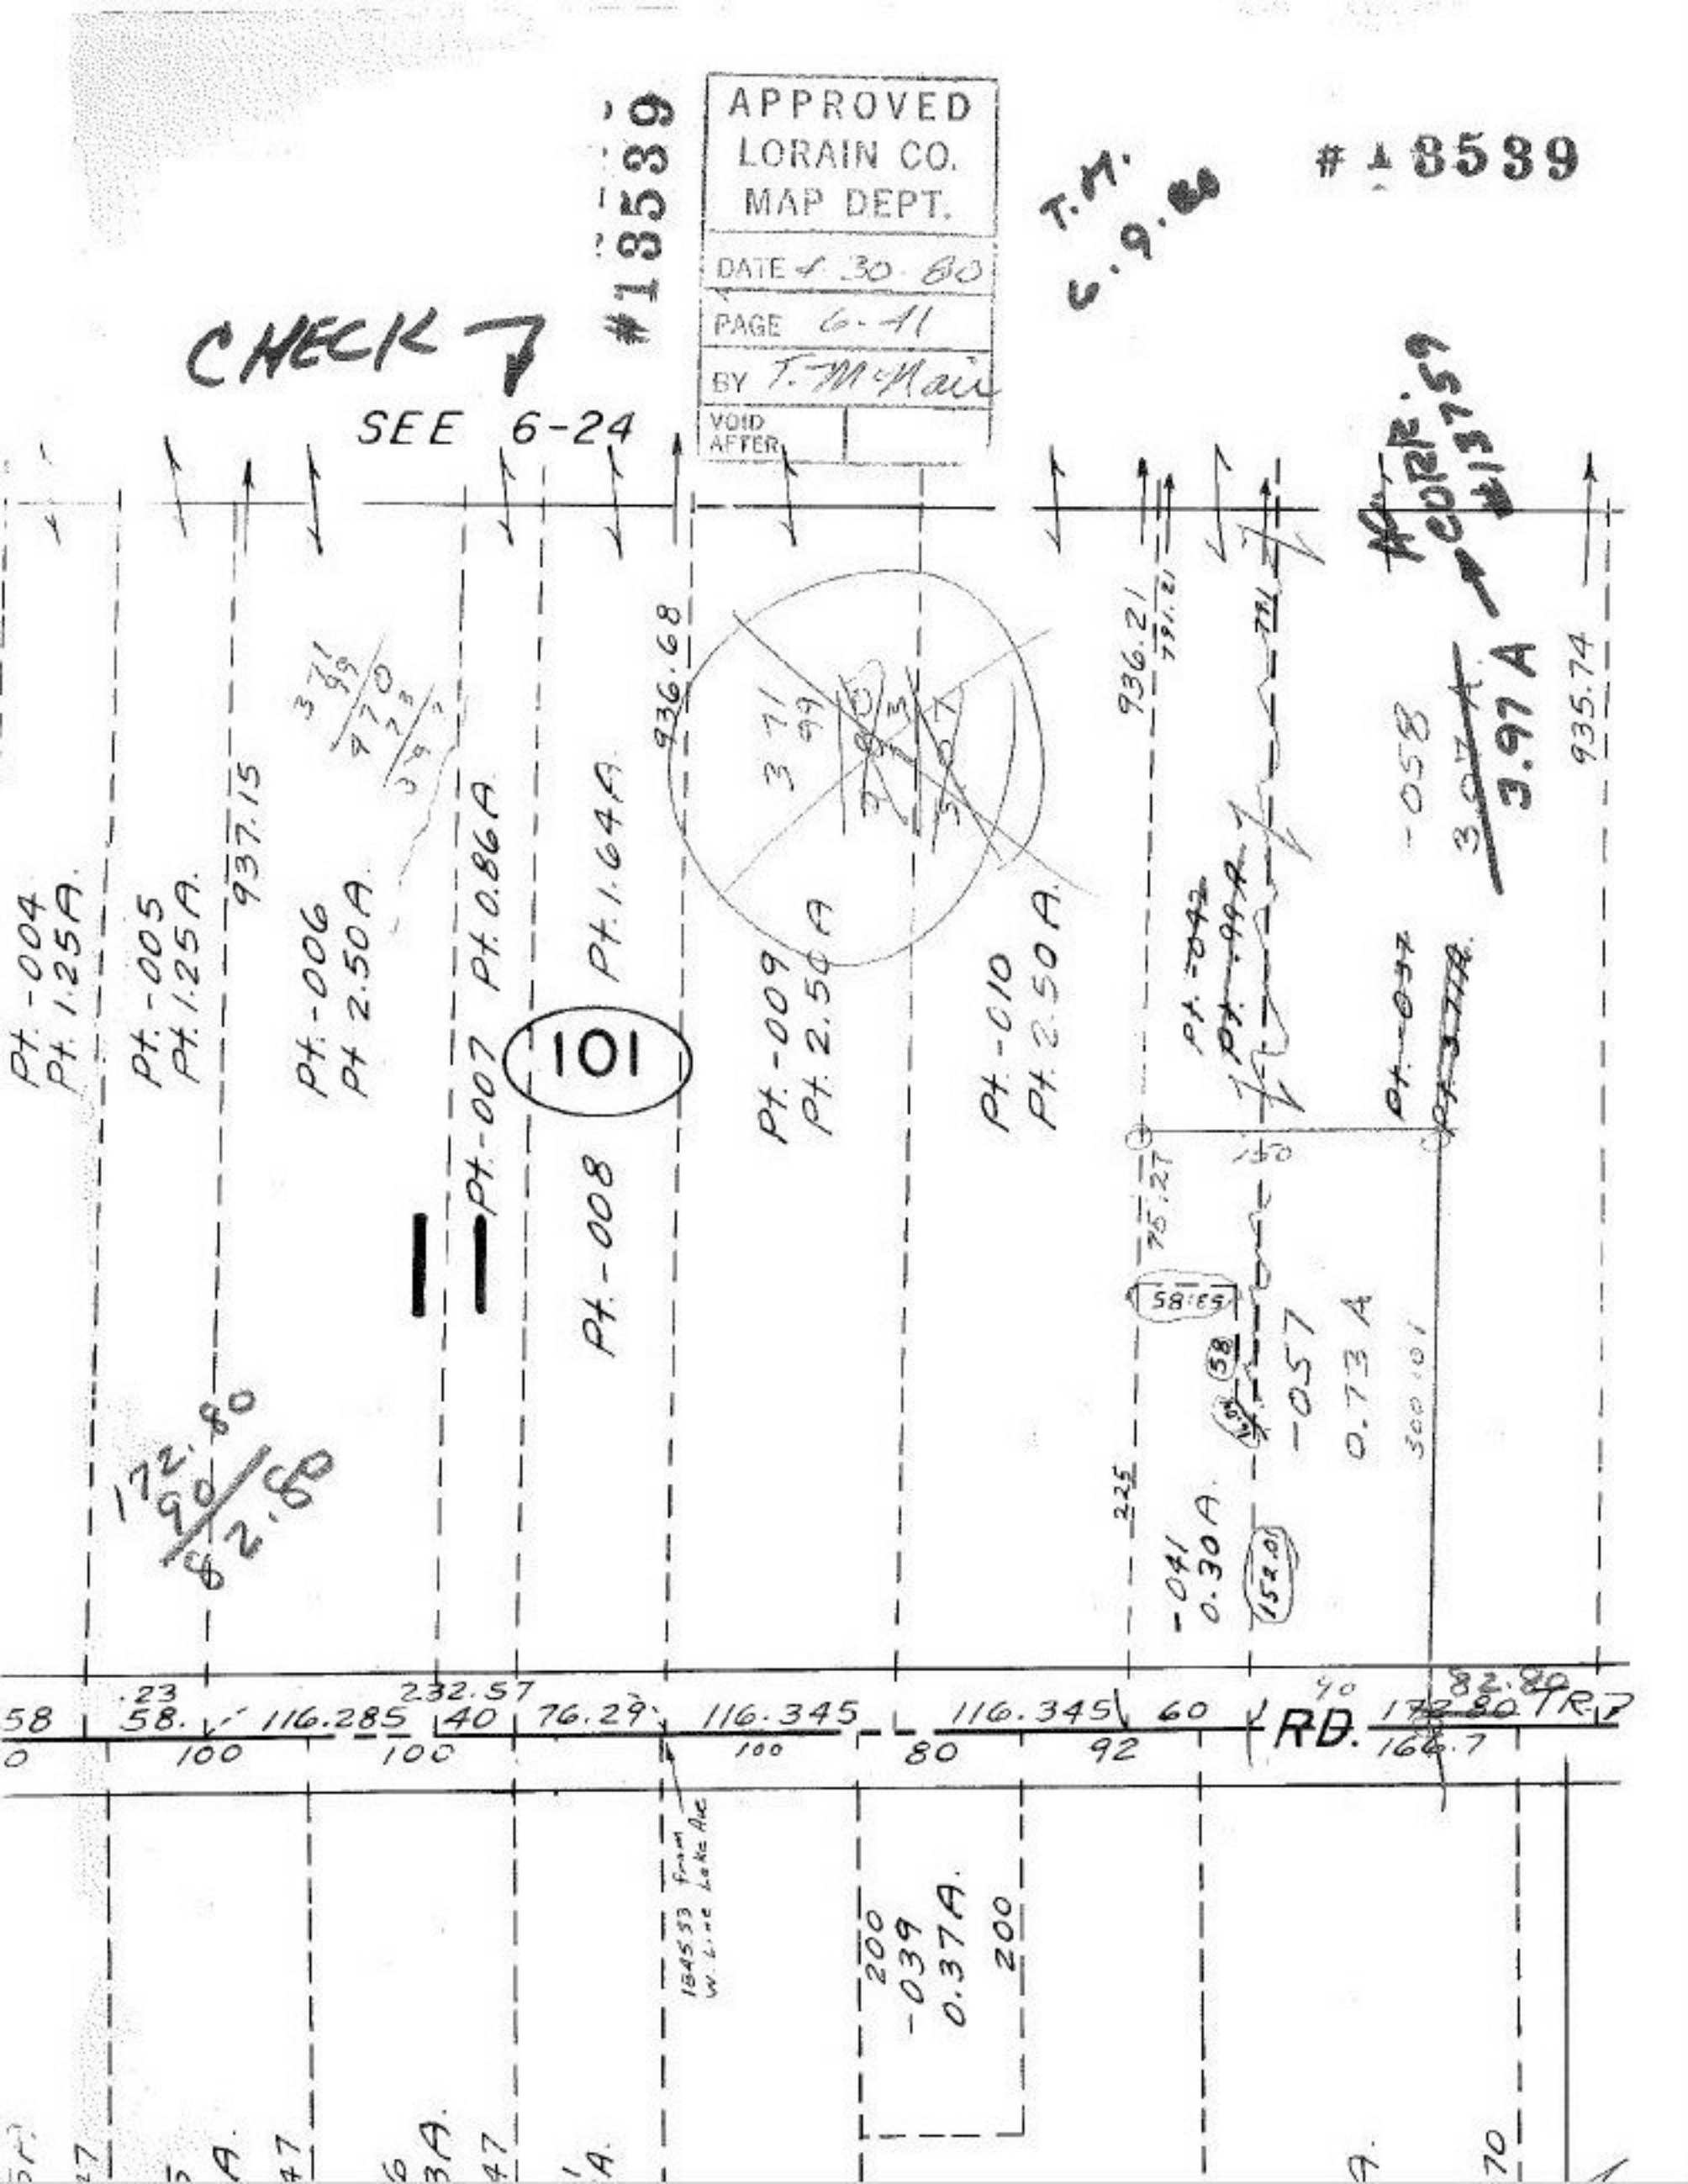

APPROVED
LORAIN CO.
MAP DEPT.
DATE 4-30-80
PAGE 6-41
BY T. McNair
VOID AFTER
#18539
T.M. 6.9.80
CHECK
SEE 6-24
Pt.-004 Pt. 1.25A.
Pt.-005 Pt. 1.25A.
Pt.-006 Pt. 2.50A.
Pt.-007 Pt. 0.86A.
Pt.-008 Pt. 1.64A.
Pt.-009 Pt. 2.50A.
Pt.-010 Pt. 2.50A.
101
937.15
936.68
936.21
935.74
-058 3.97 A
-057 0.73 A
-041 0.30 A
-039 0.37 A.
RD.
TR.
116.285
232.57
76.29
116.345
116.345
82.80
166.7