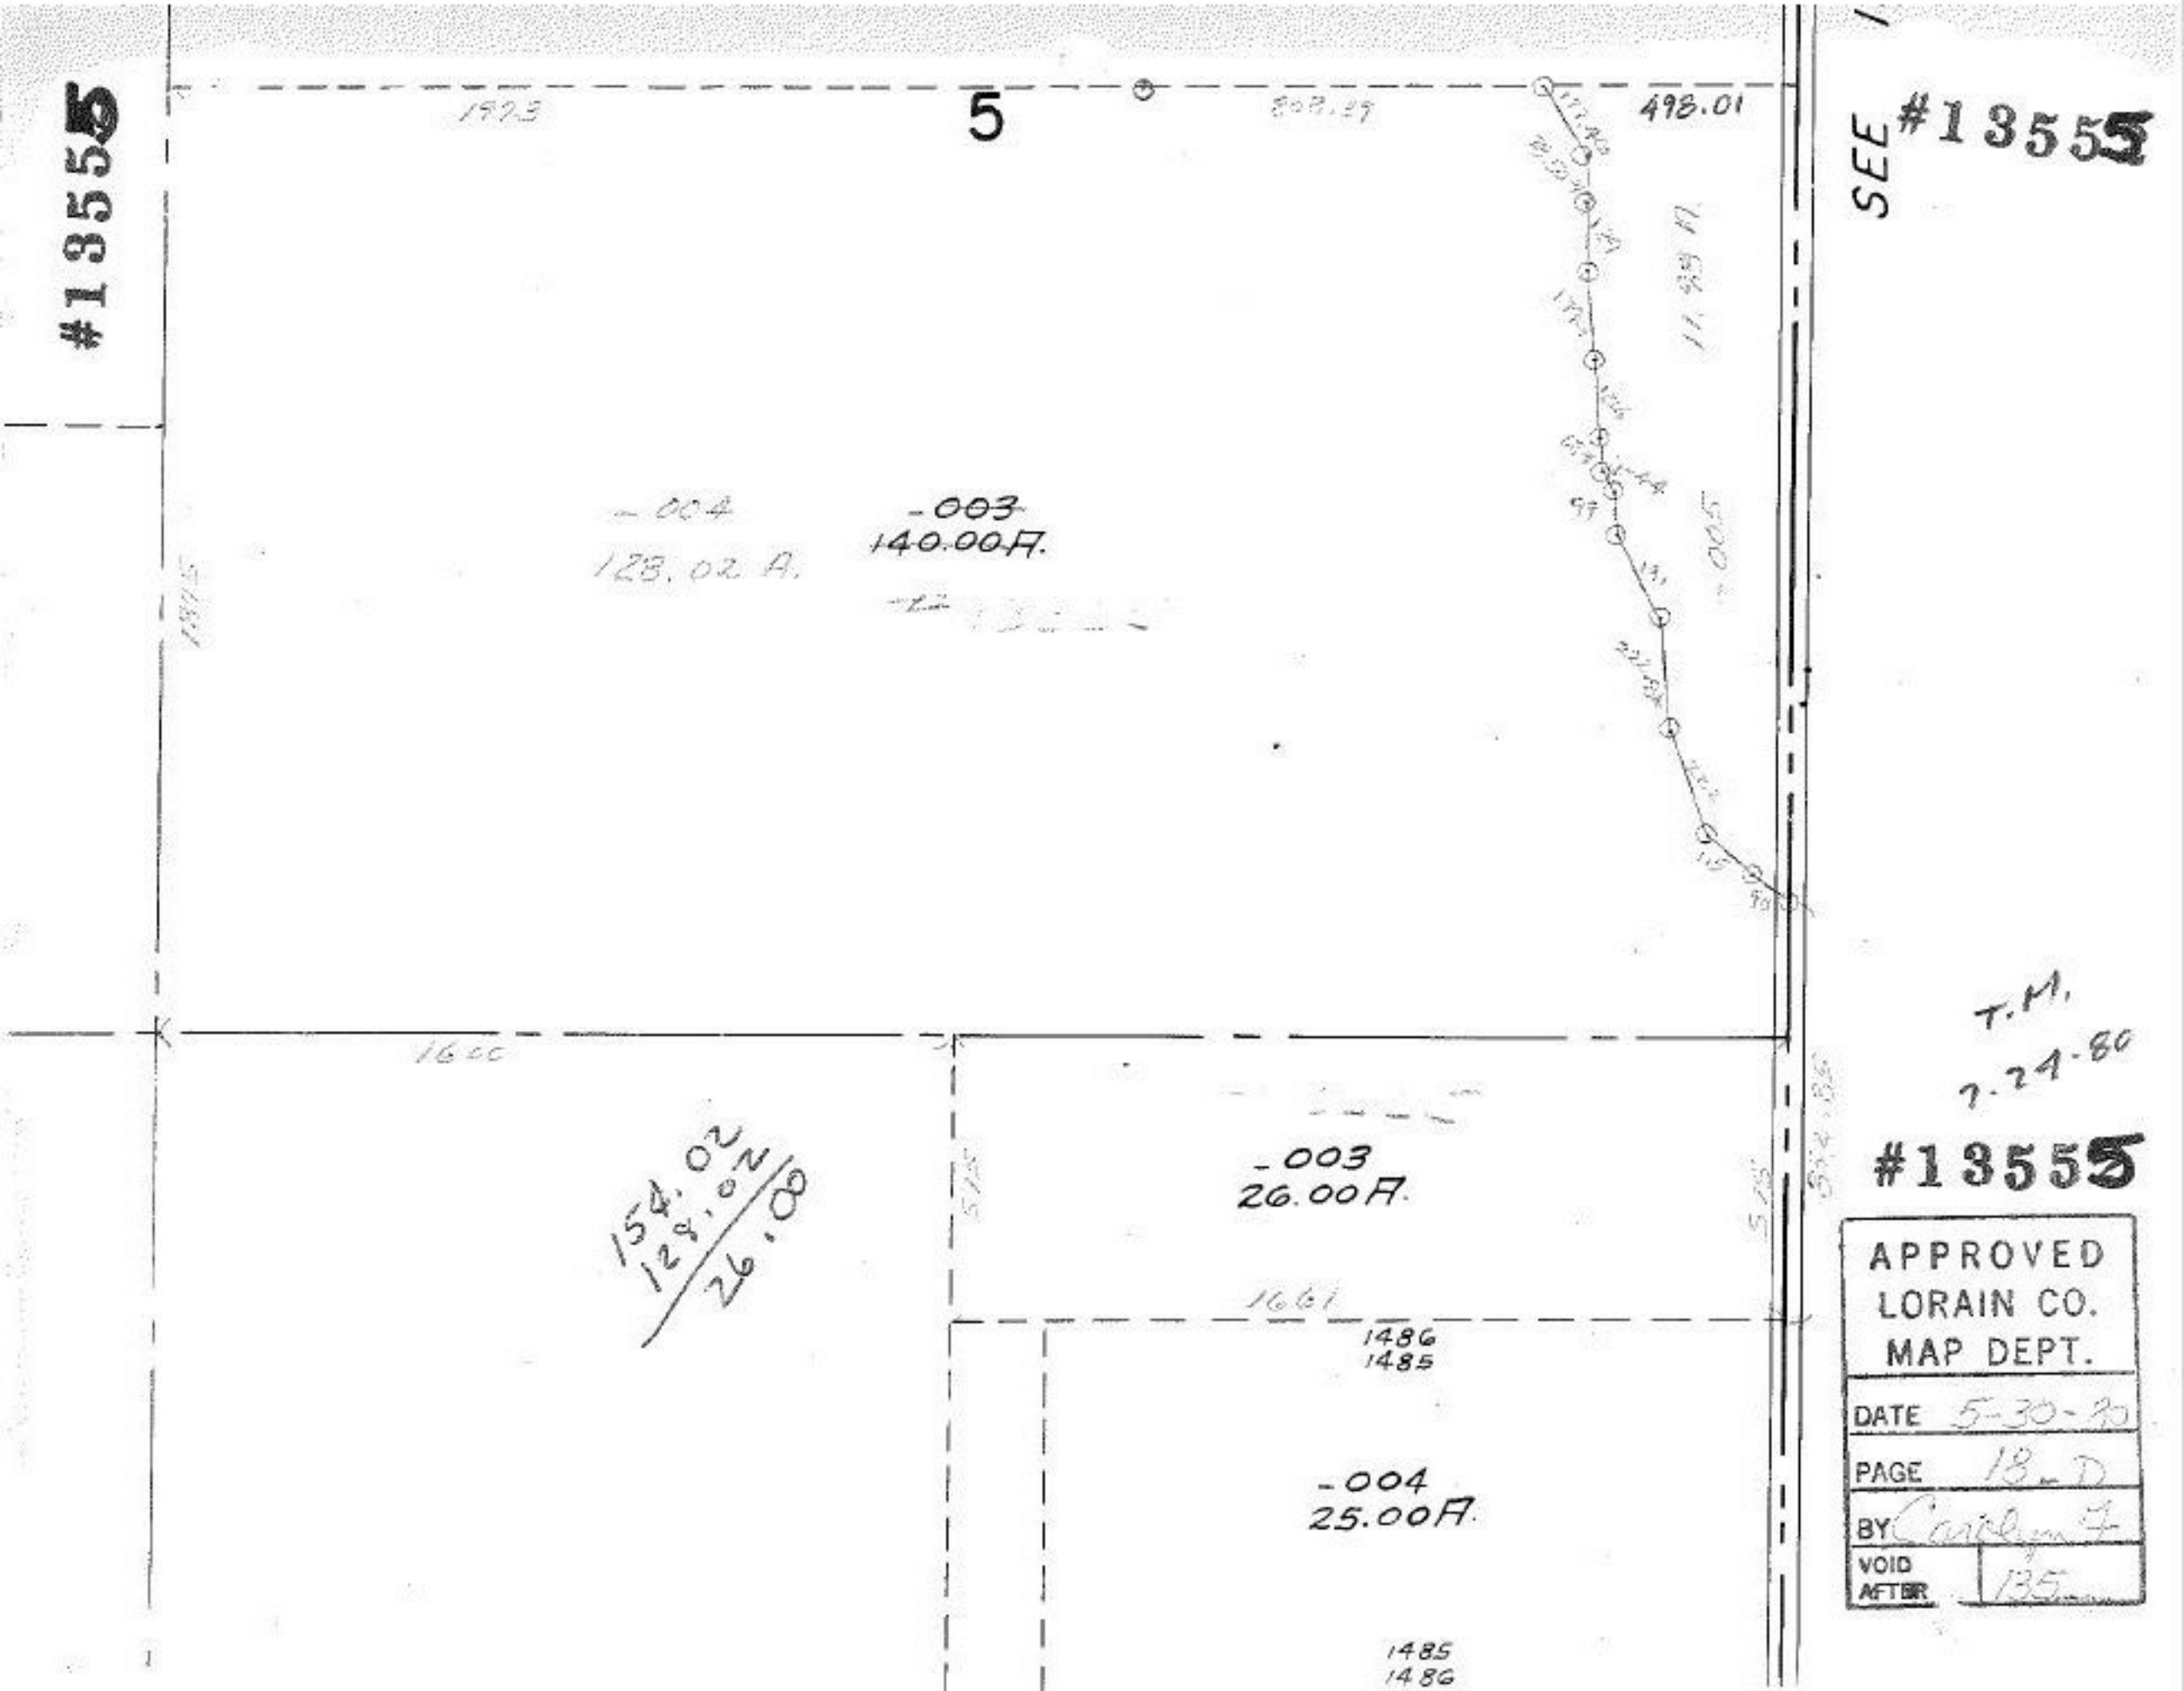

#13555
5
498.01
SEE #13555
-004
128.02 A.
-003
140.00 A.
1600
154.02
128.02
26.00
-003
26.00 A.
1661
1486
1485
-004
25.00 A.
1485
1486
T.M.
7-24-80
#13555
APPROVED
LORAIN CO.
MAP DEPT.
DATE 5-30-80
PAGE 18-D
BY Carolyn F
VOID AFTER 135