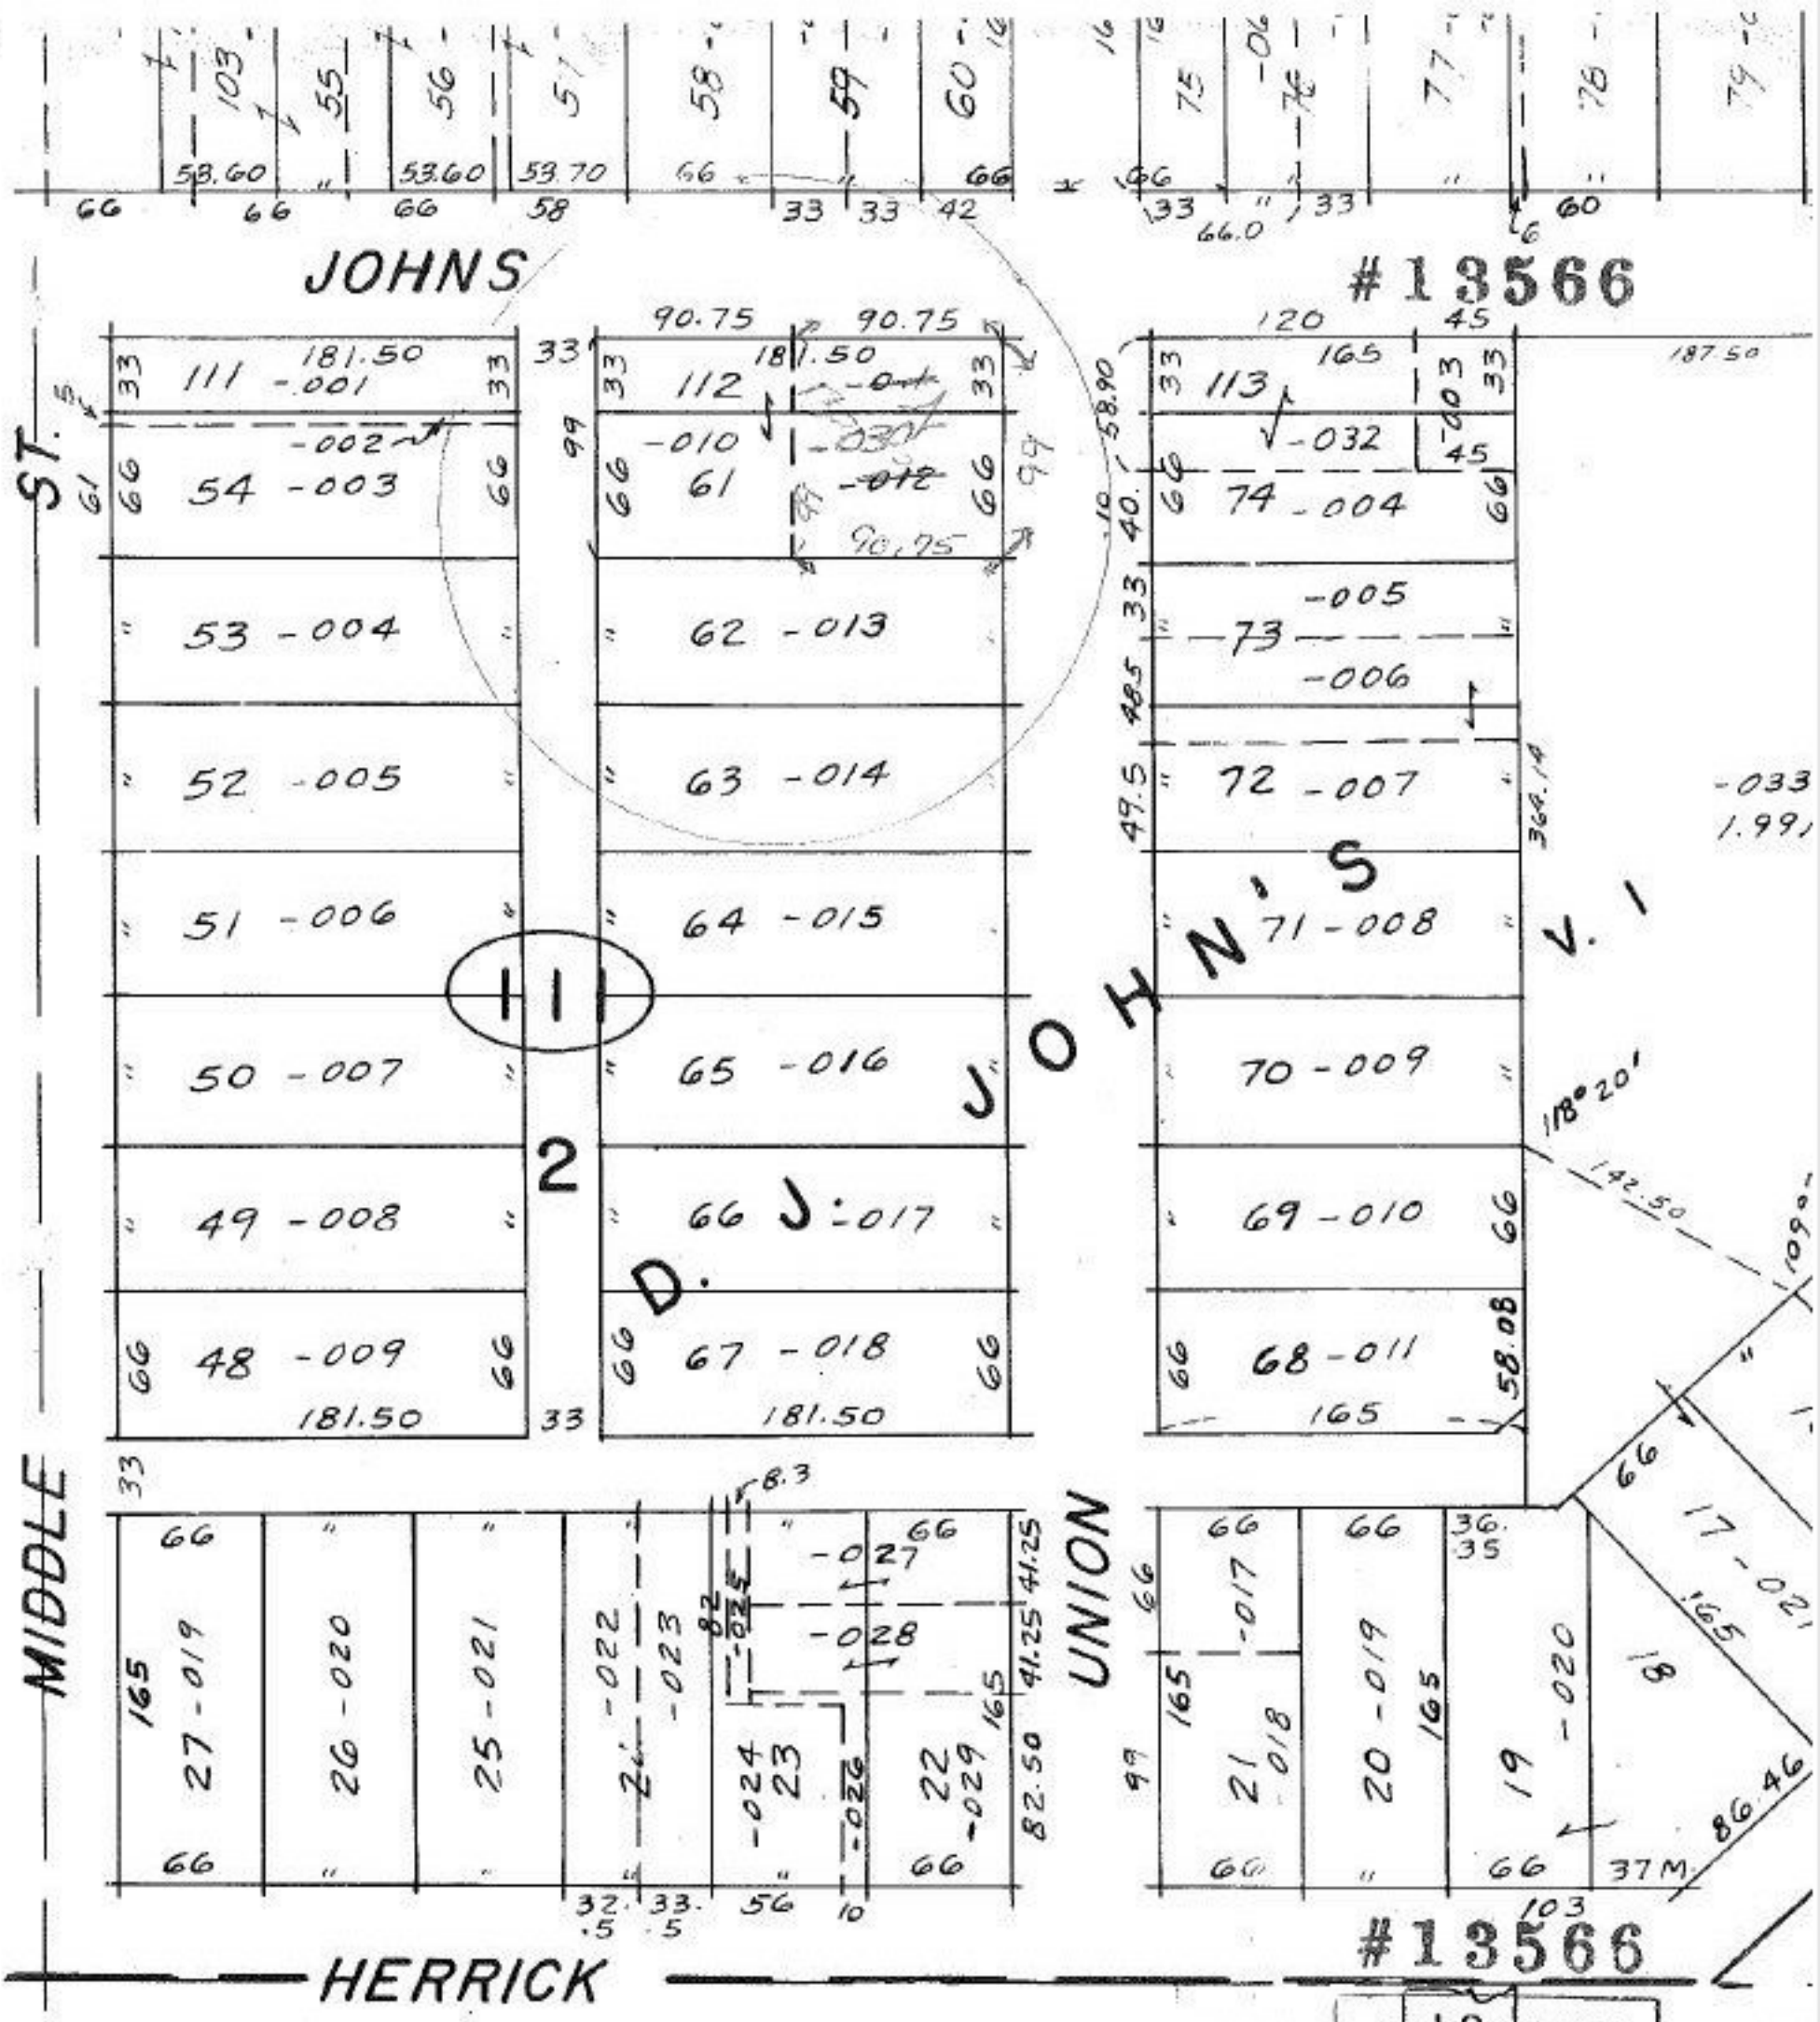

MAY 16 1980

APPROVED
LORAIN CO.
MAP DEPT.

DATE 5-6-80

PAGE 18-00-028-D

BY Carolyn E. Francis

VOID AFTER 13566