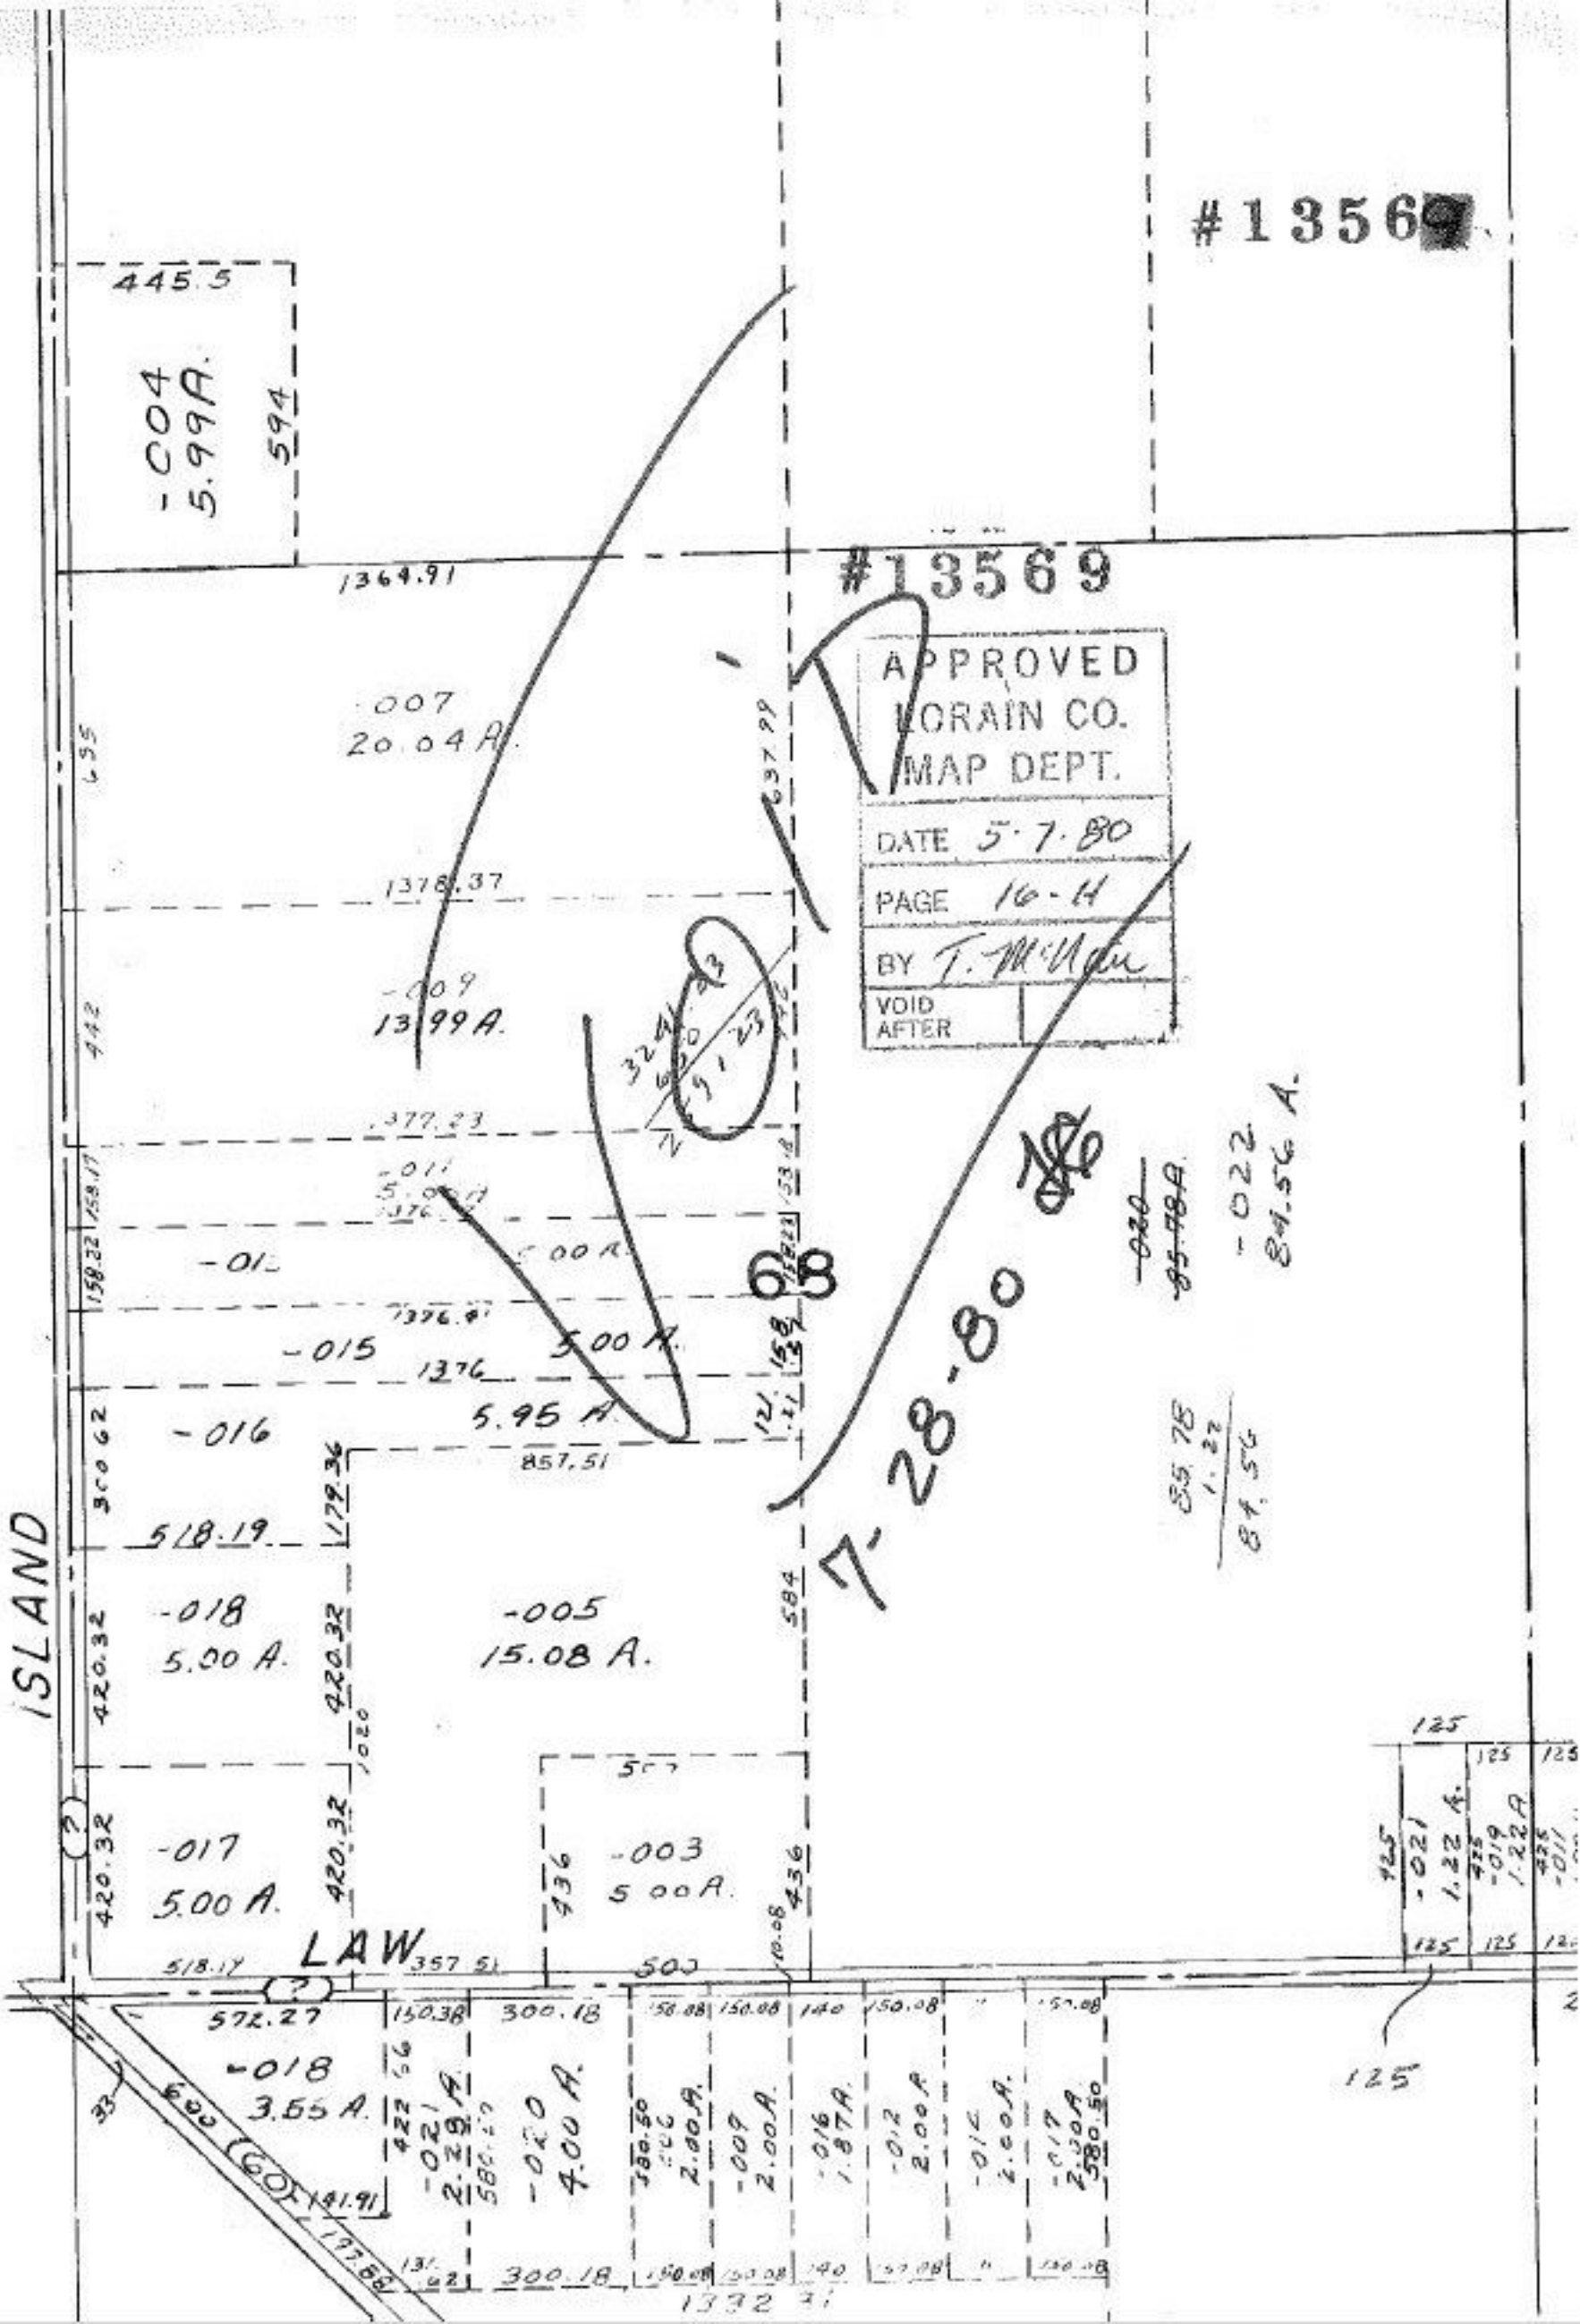

#13569
#13569
APPROVED
LORAIN CO.
MAP DEPT.
DATE 5·7·80
PAGE 16-H
BY T. McNair
VOID AFTER
7-28-80
ISLAND
LAW
-004
5.99A.
-007
20.04 A.
-009
13.99 A.
-011
5.00 A.
-015
5.00 A.
-016
5.95 A.
-018
5.00 A.
-005
15.08 A.
-017
5.00 A.
-003
5.00 A.
-018
3.55 A.
-020
4.00 A.
-022
84.56 A.
-021
1.22 A.
-019
1.22 A.