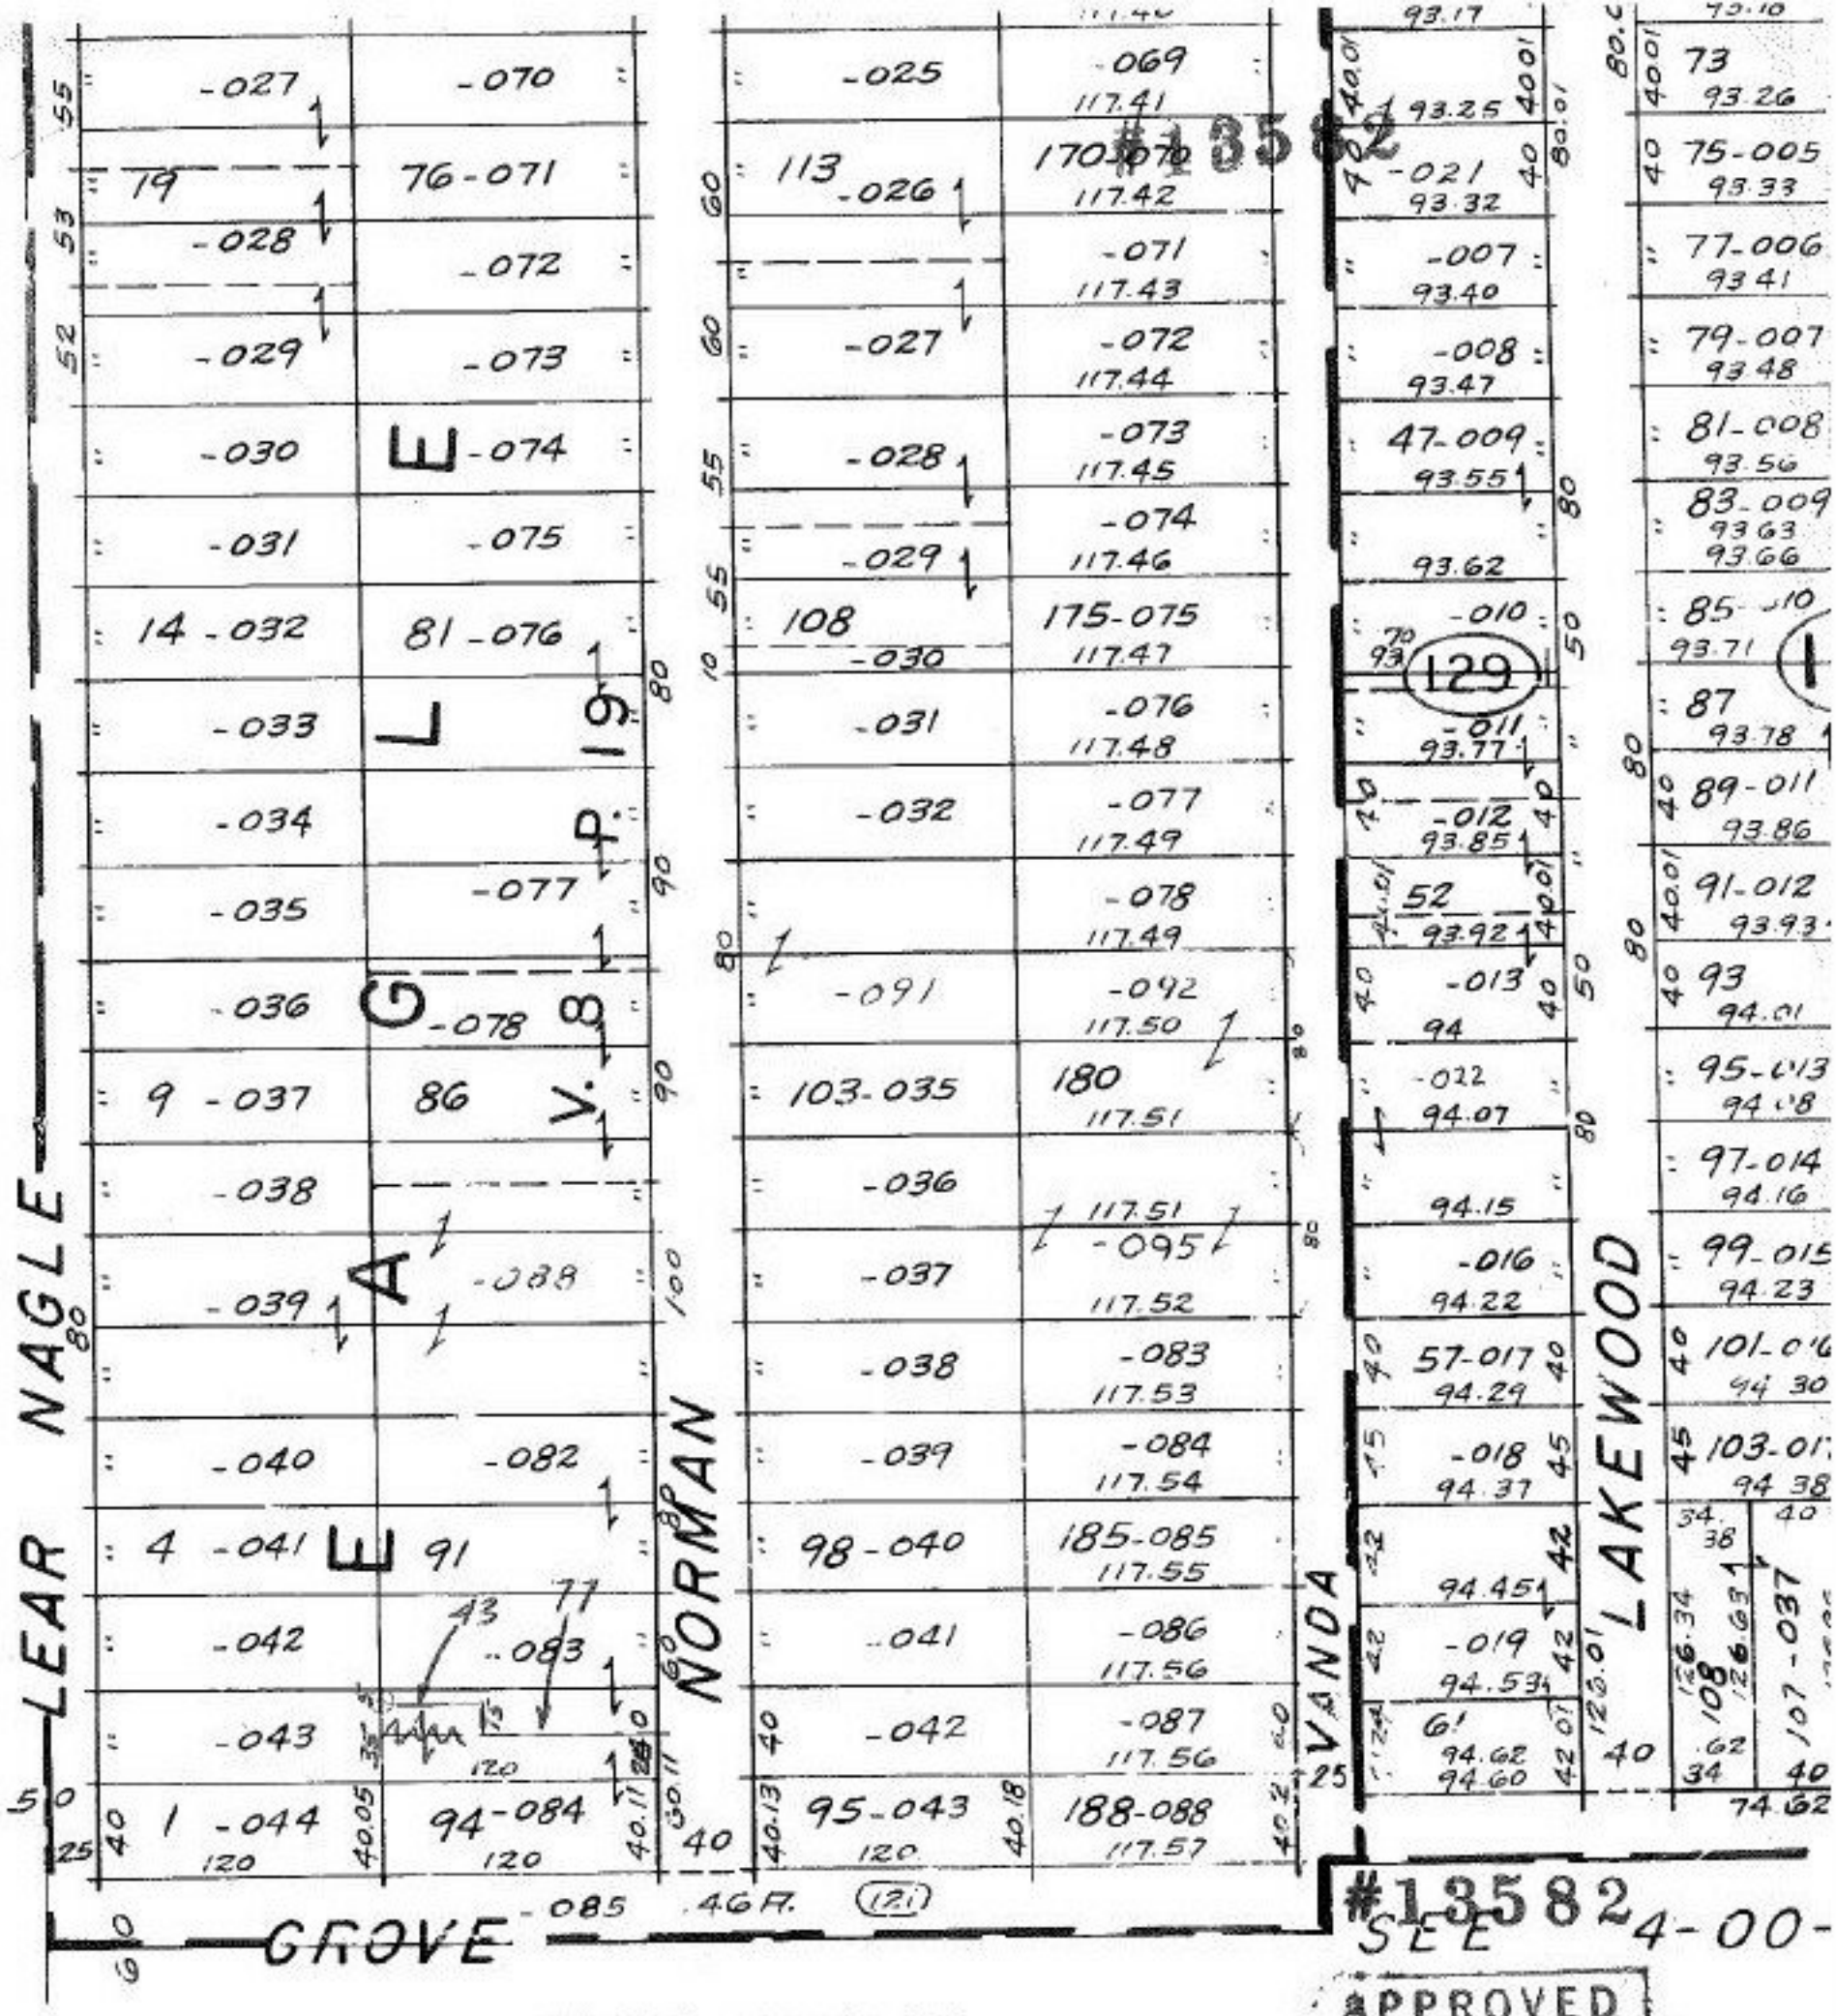

CORRECTION - MAP ONLY

PER VOL. 1235 PG. 211

REDRAW - 084

T.M.
5.22-80

APPROVED
LORAIN CO.
MAP DEPT.
DATE 5-13-80
PAGE 4-00-030-A
BY T. McNair
VOID AFTER