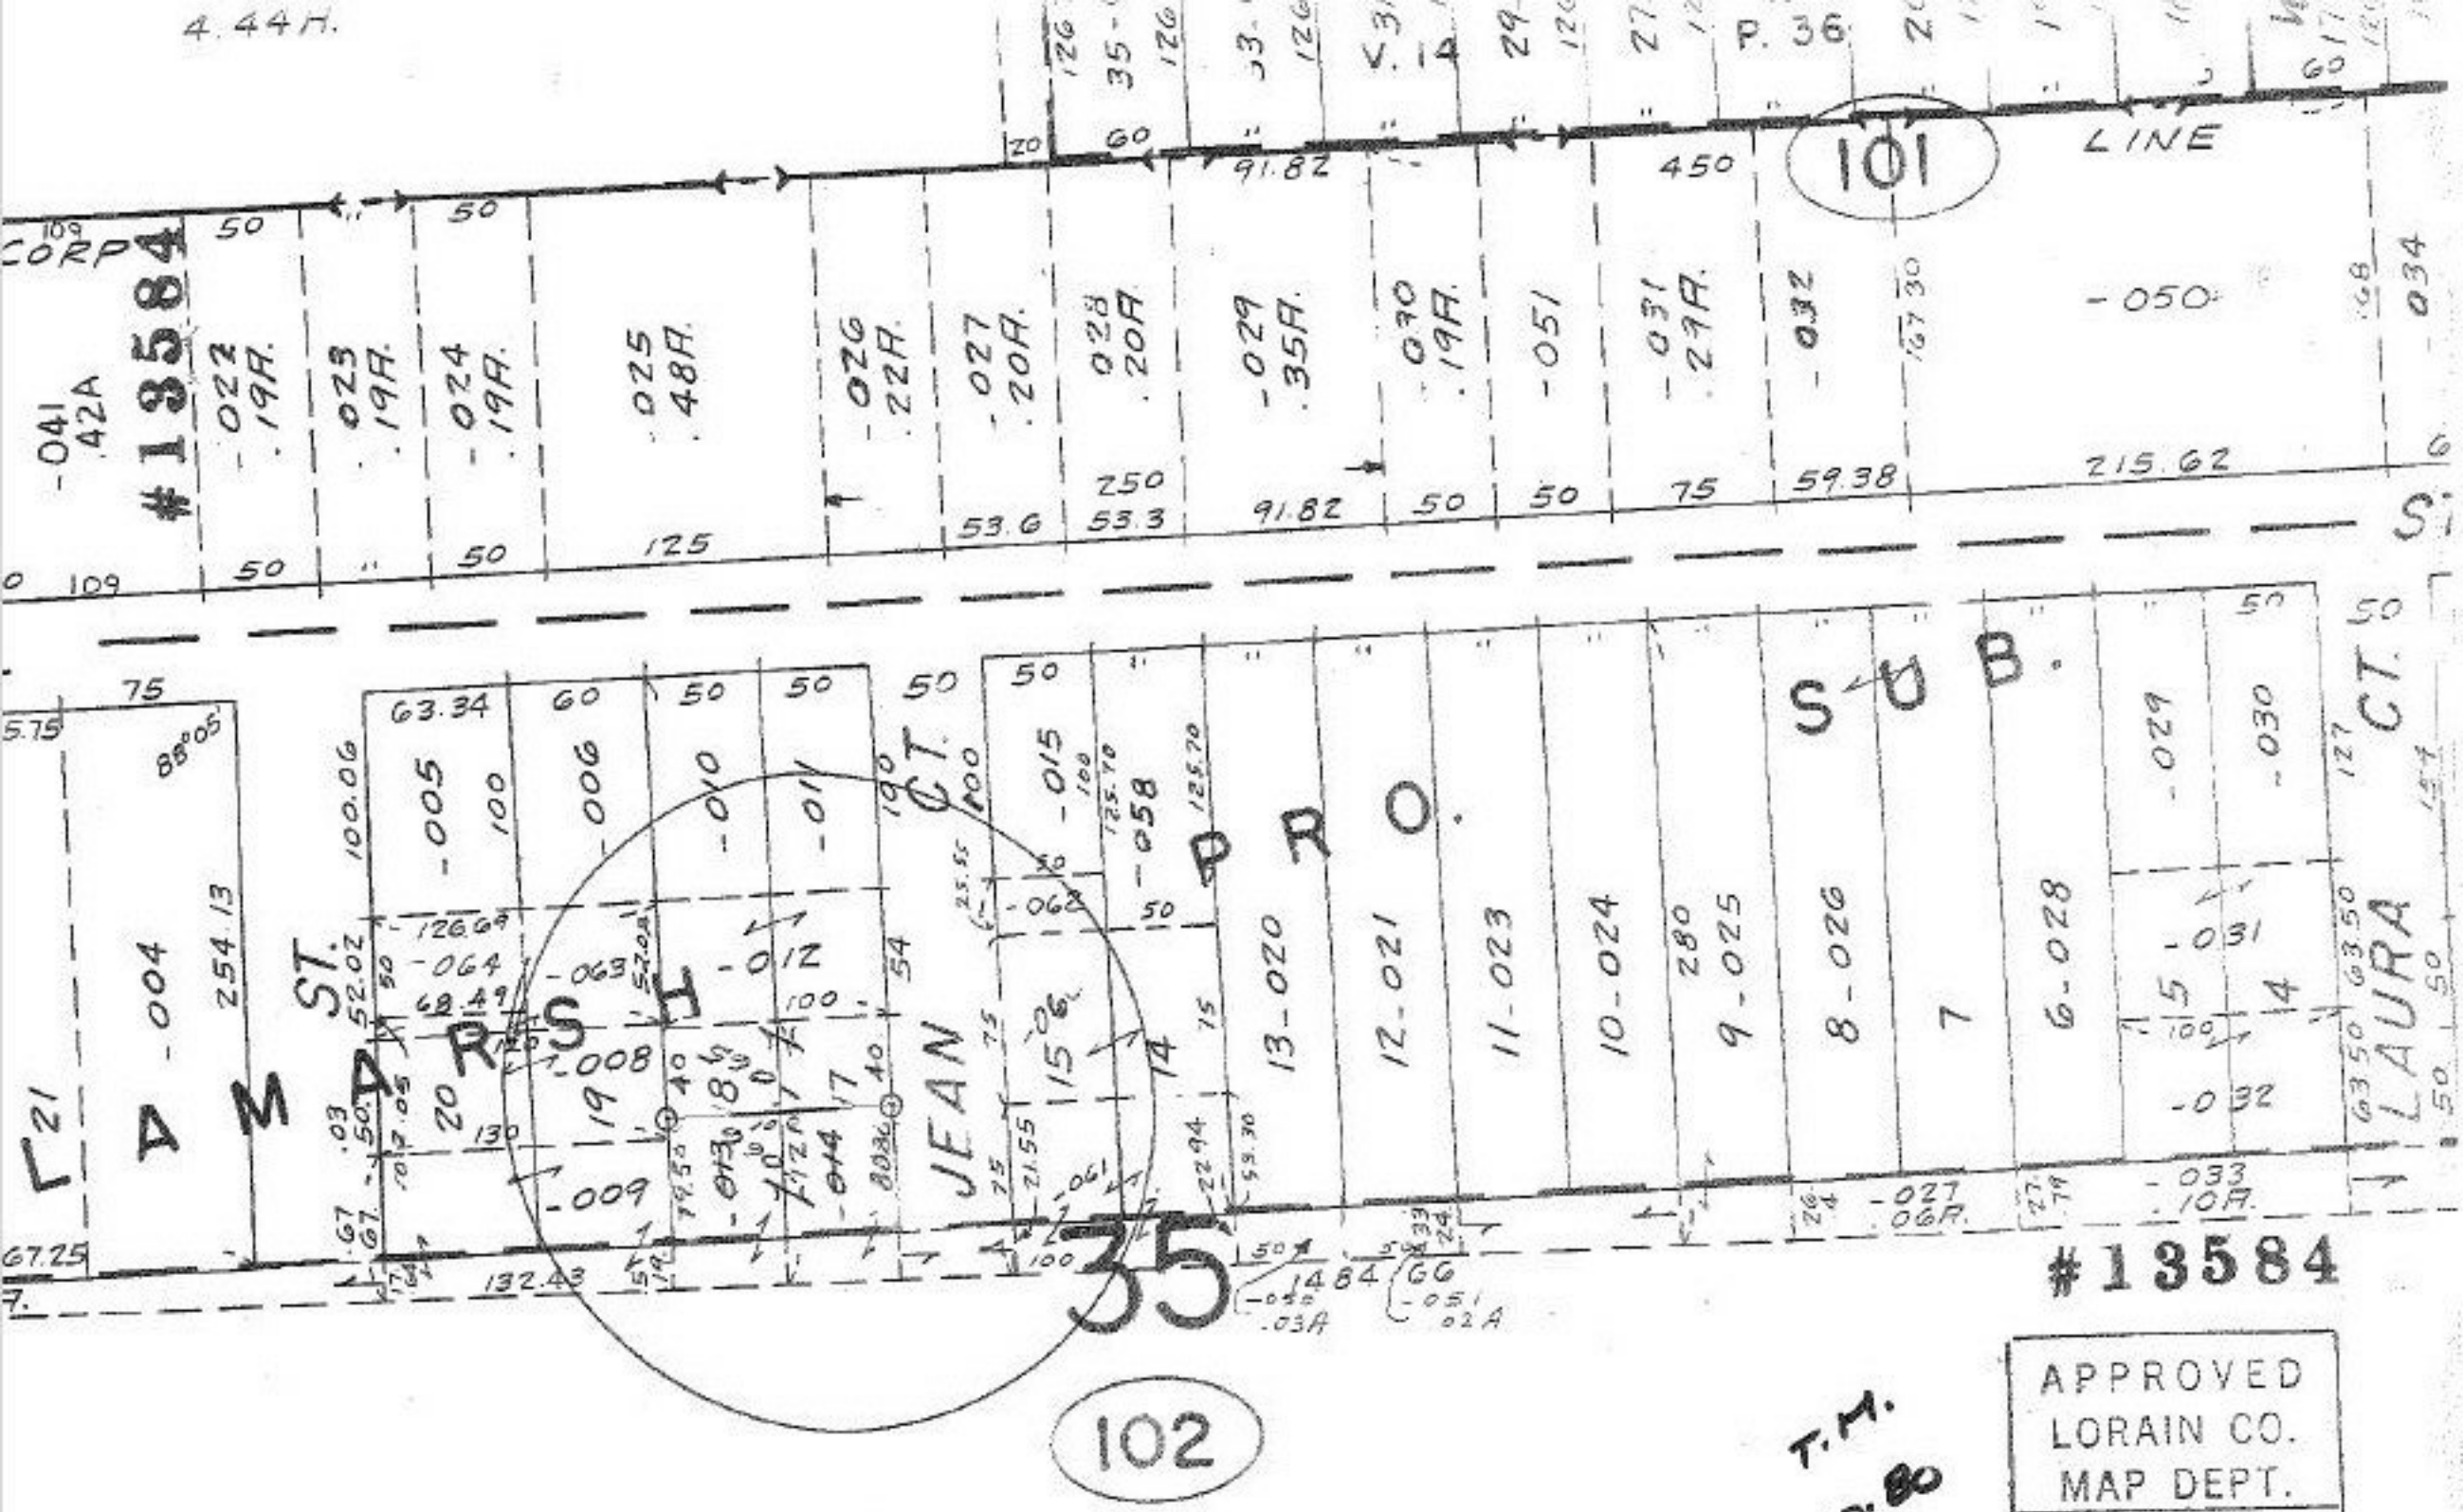

T.M.
6.10.80

APPROVED
LORAIN CO.
MAP DEPT.

DATE 5-14-80

PAGE 6-60

BY Carolyn F

VOID AFTER 13584

pt. -055