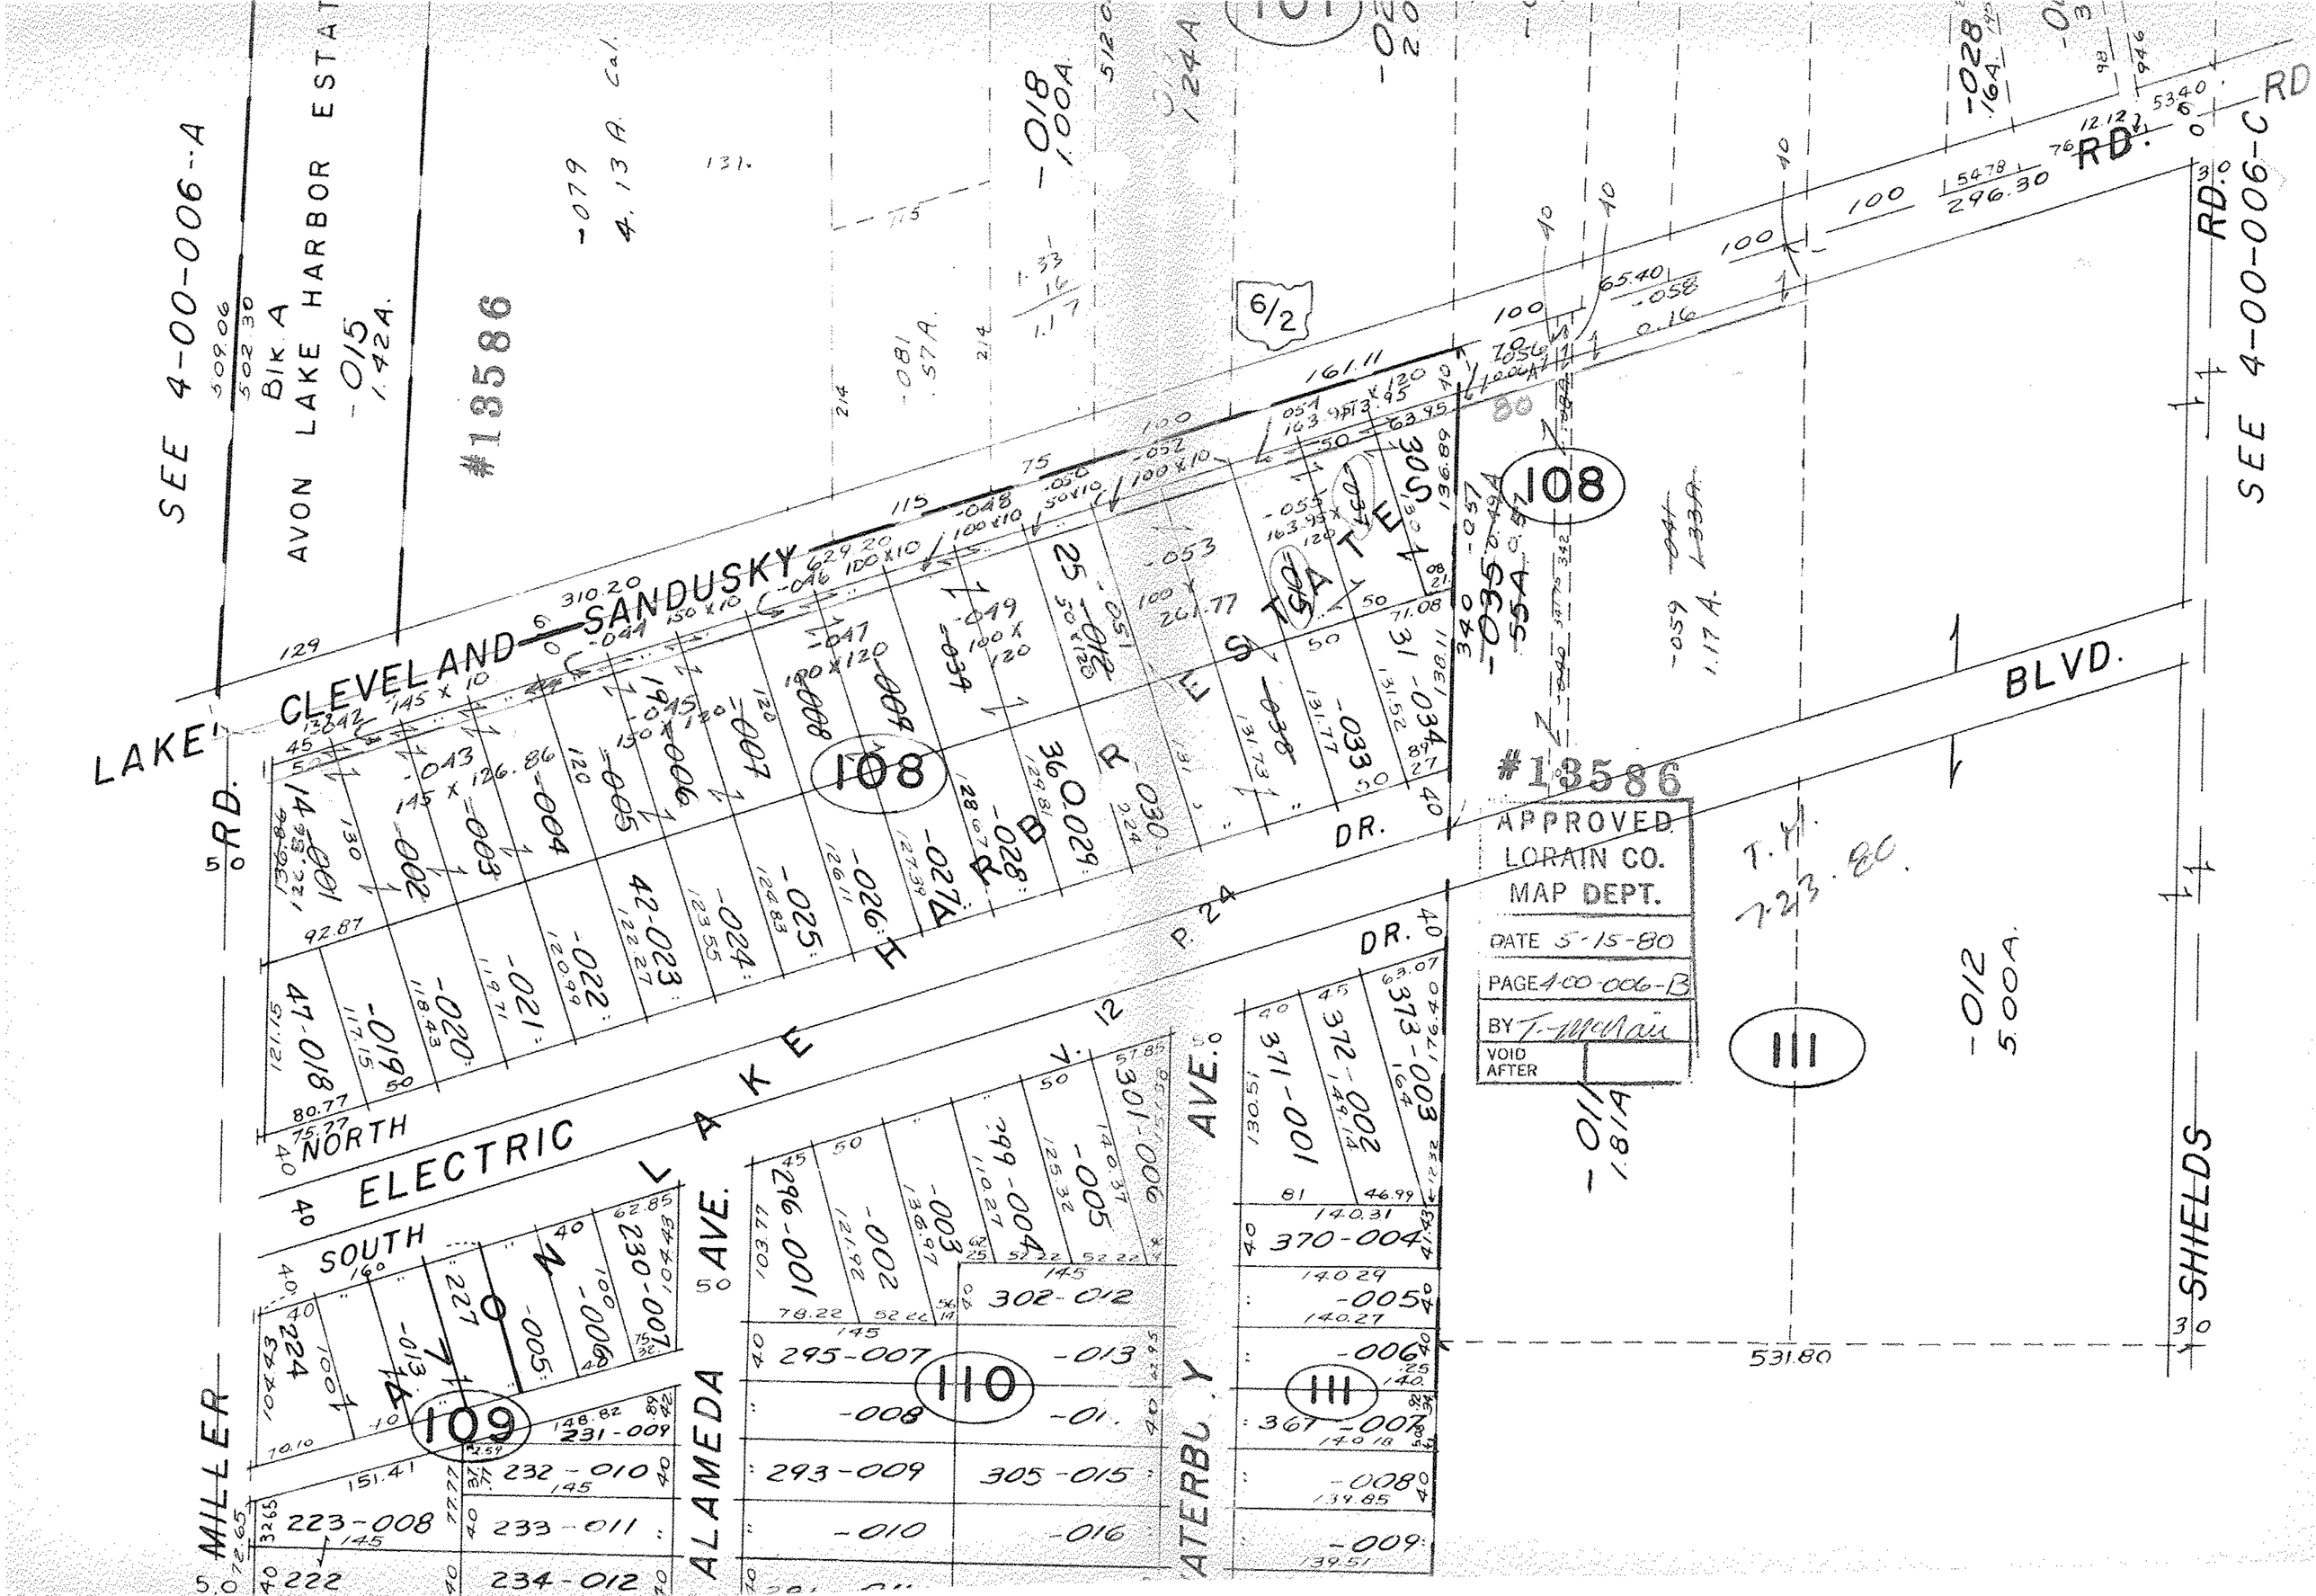

SEE 4-00-006-A
BLK A
AVON LAKE HARBOR ESTATES
#13586
LAKE CLEVELAND—SANDUSKY
NORTH
SOUTH
ELECTRIC
LAKE HARBOR ESTATES
DR.
BLVD.
RD.
SHIELDS
MILLER
ALAMEDA
AVE.
ATERBURY
AVE.
SEE 4-00-006-C
#13586
APPROVED
LORAIN CO.
MAP DEPT.
DATE 5-15-80
PAGE 4-00-006-B
BY T. McNair
VOID AFTER
T.M.
7-23-80
108
109
110
111
6/2
531.80