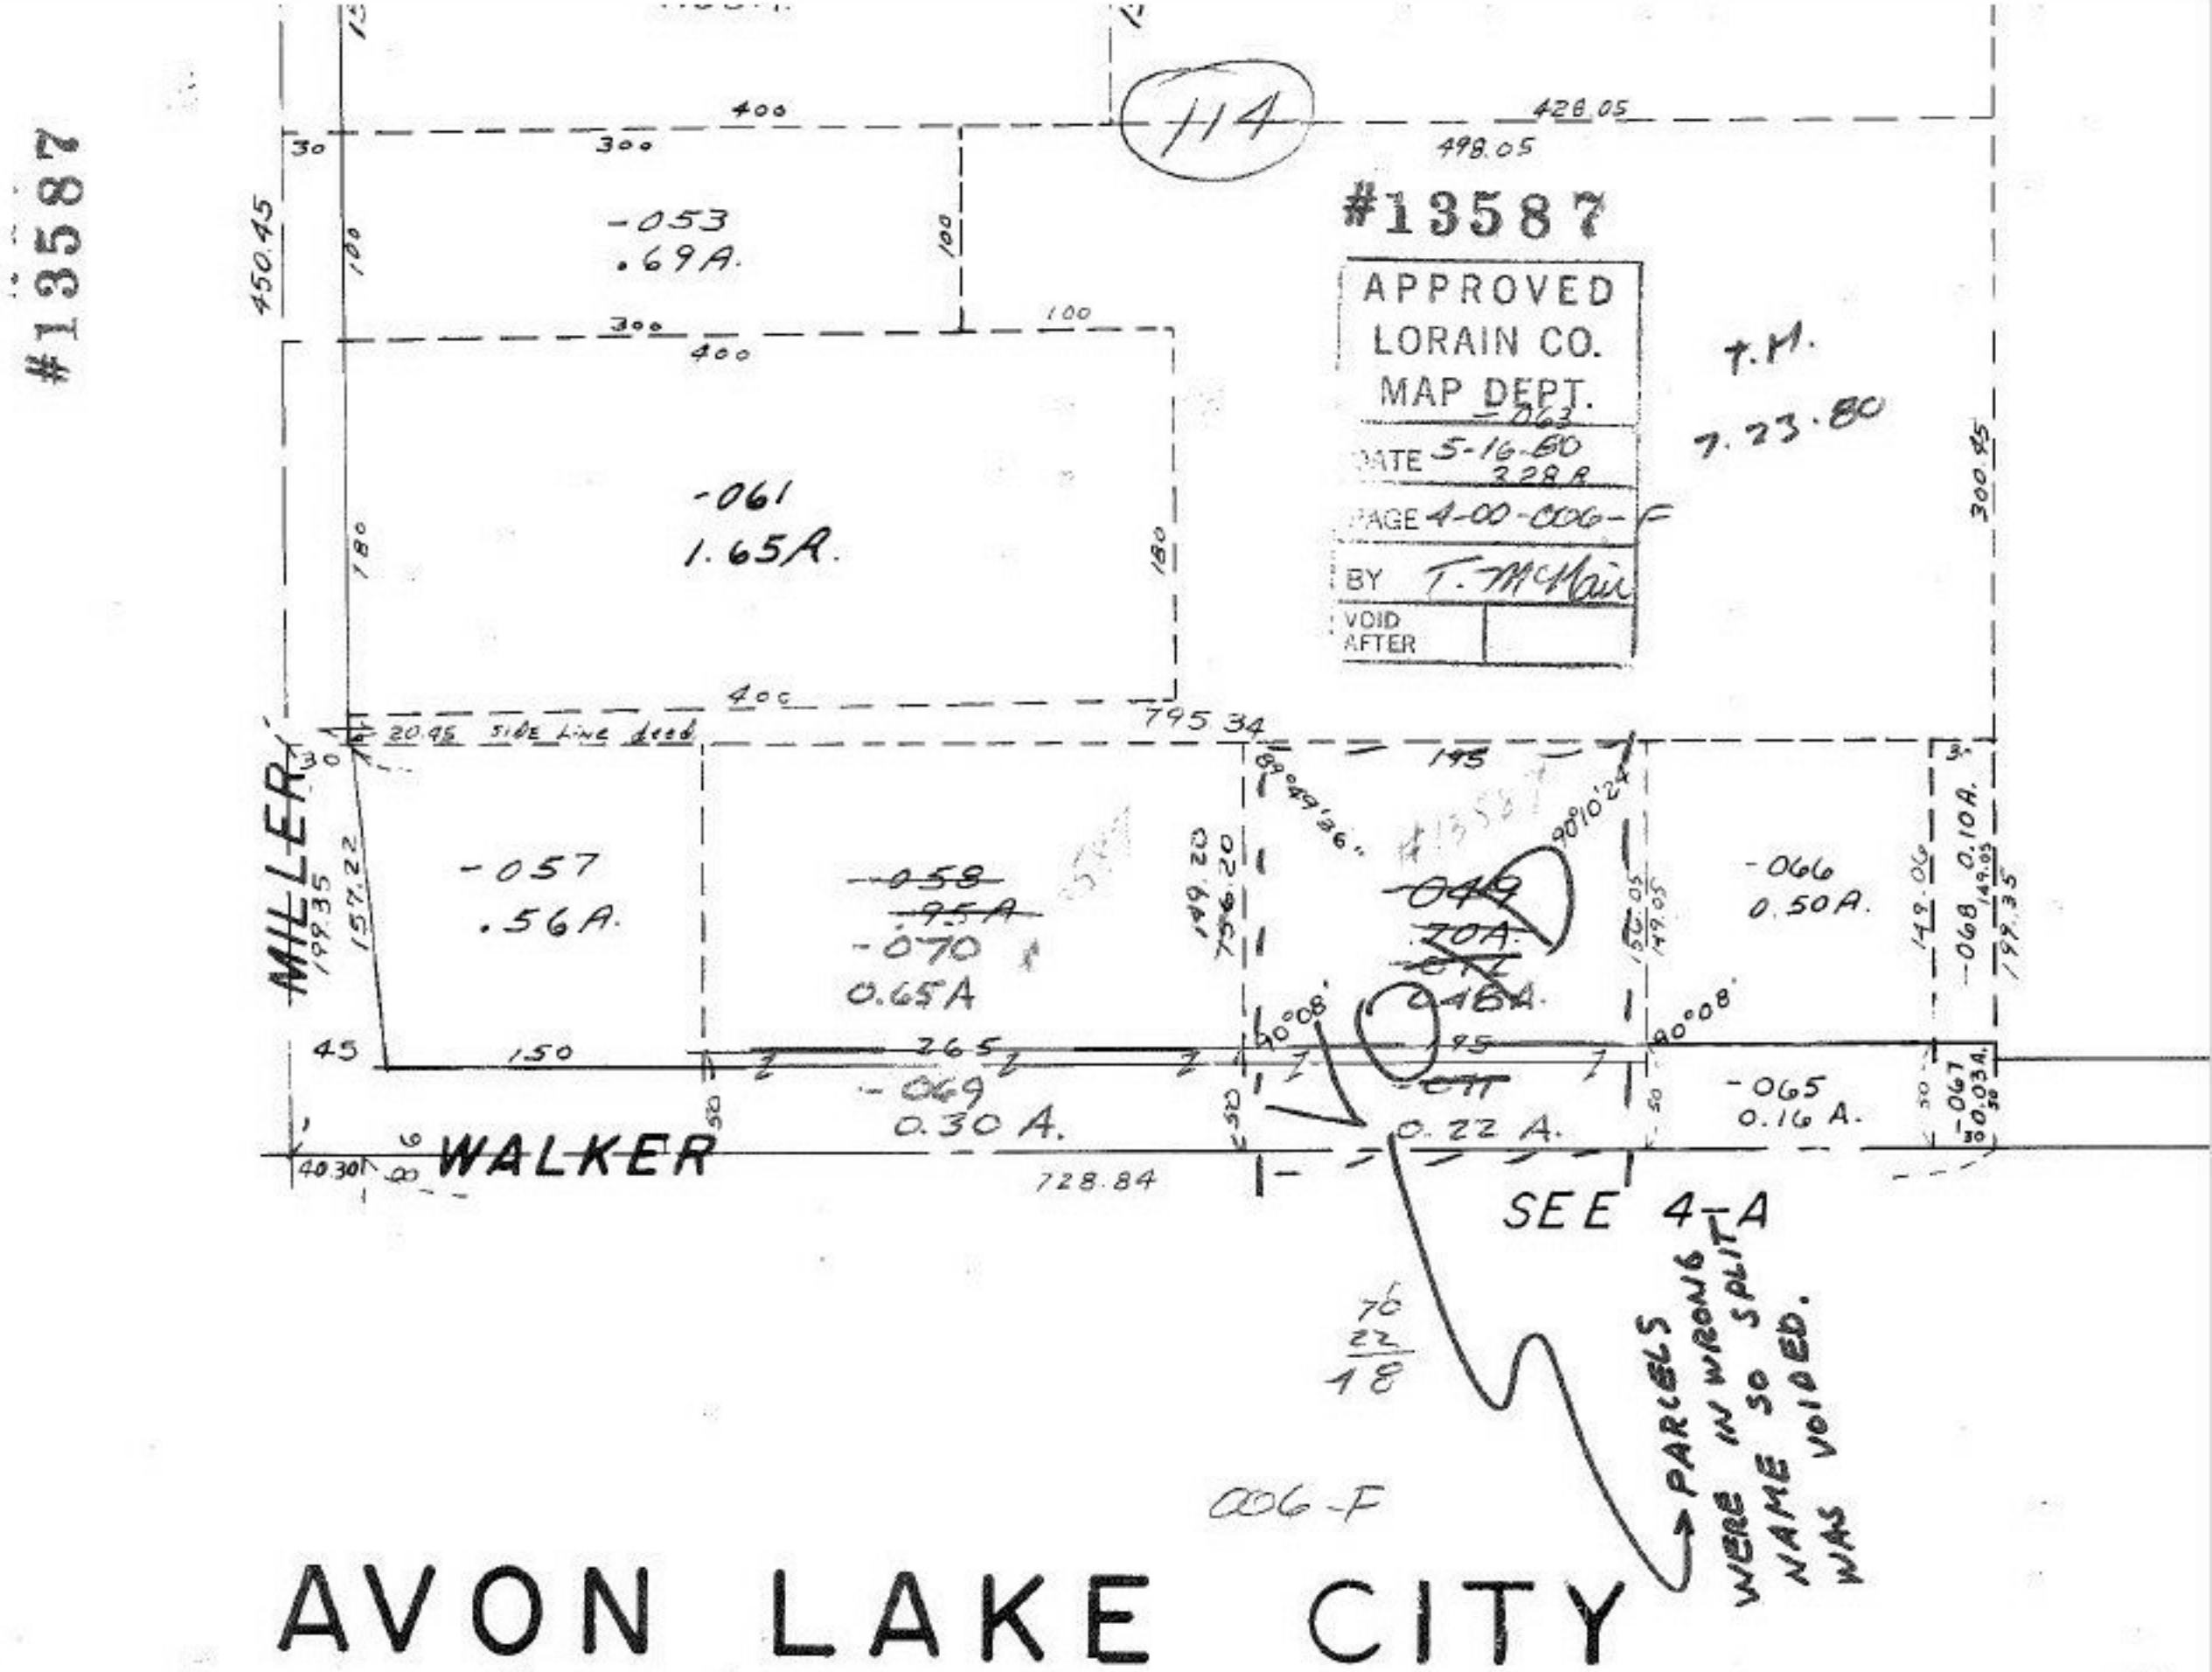
#13587
114
#13587
APPROVED
LORAIN CO.
MAP DEPT.
DATE 5-16-80
PAGE 4-00-006-F
BY T. McNair
VOID AFTER
T.M.
7.23.80
-053
.69A.
-061
1.65A.
-057
.56A.
-058
.95A
-070
0.65A
-049
.70A.
-066
0.50A.
-069
0.30 A.
-065
0.16 A.
0.22 A.
MILLER
WALKER
SEE 4-A
PARCELS WERE IN WRONG NAME SO SPLIT WAS VOIDED.
006-F
AVON LAKE CITY
SCALE: 1" = 100'
E