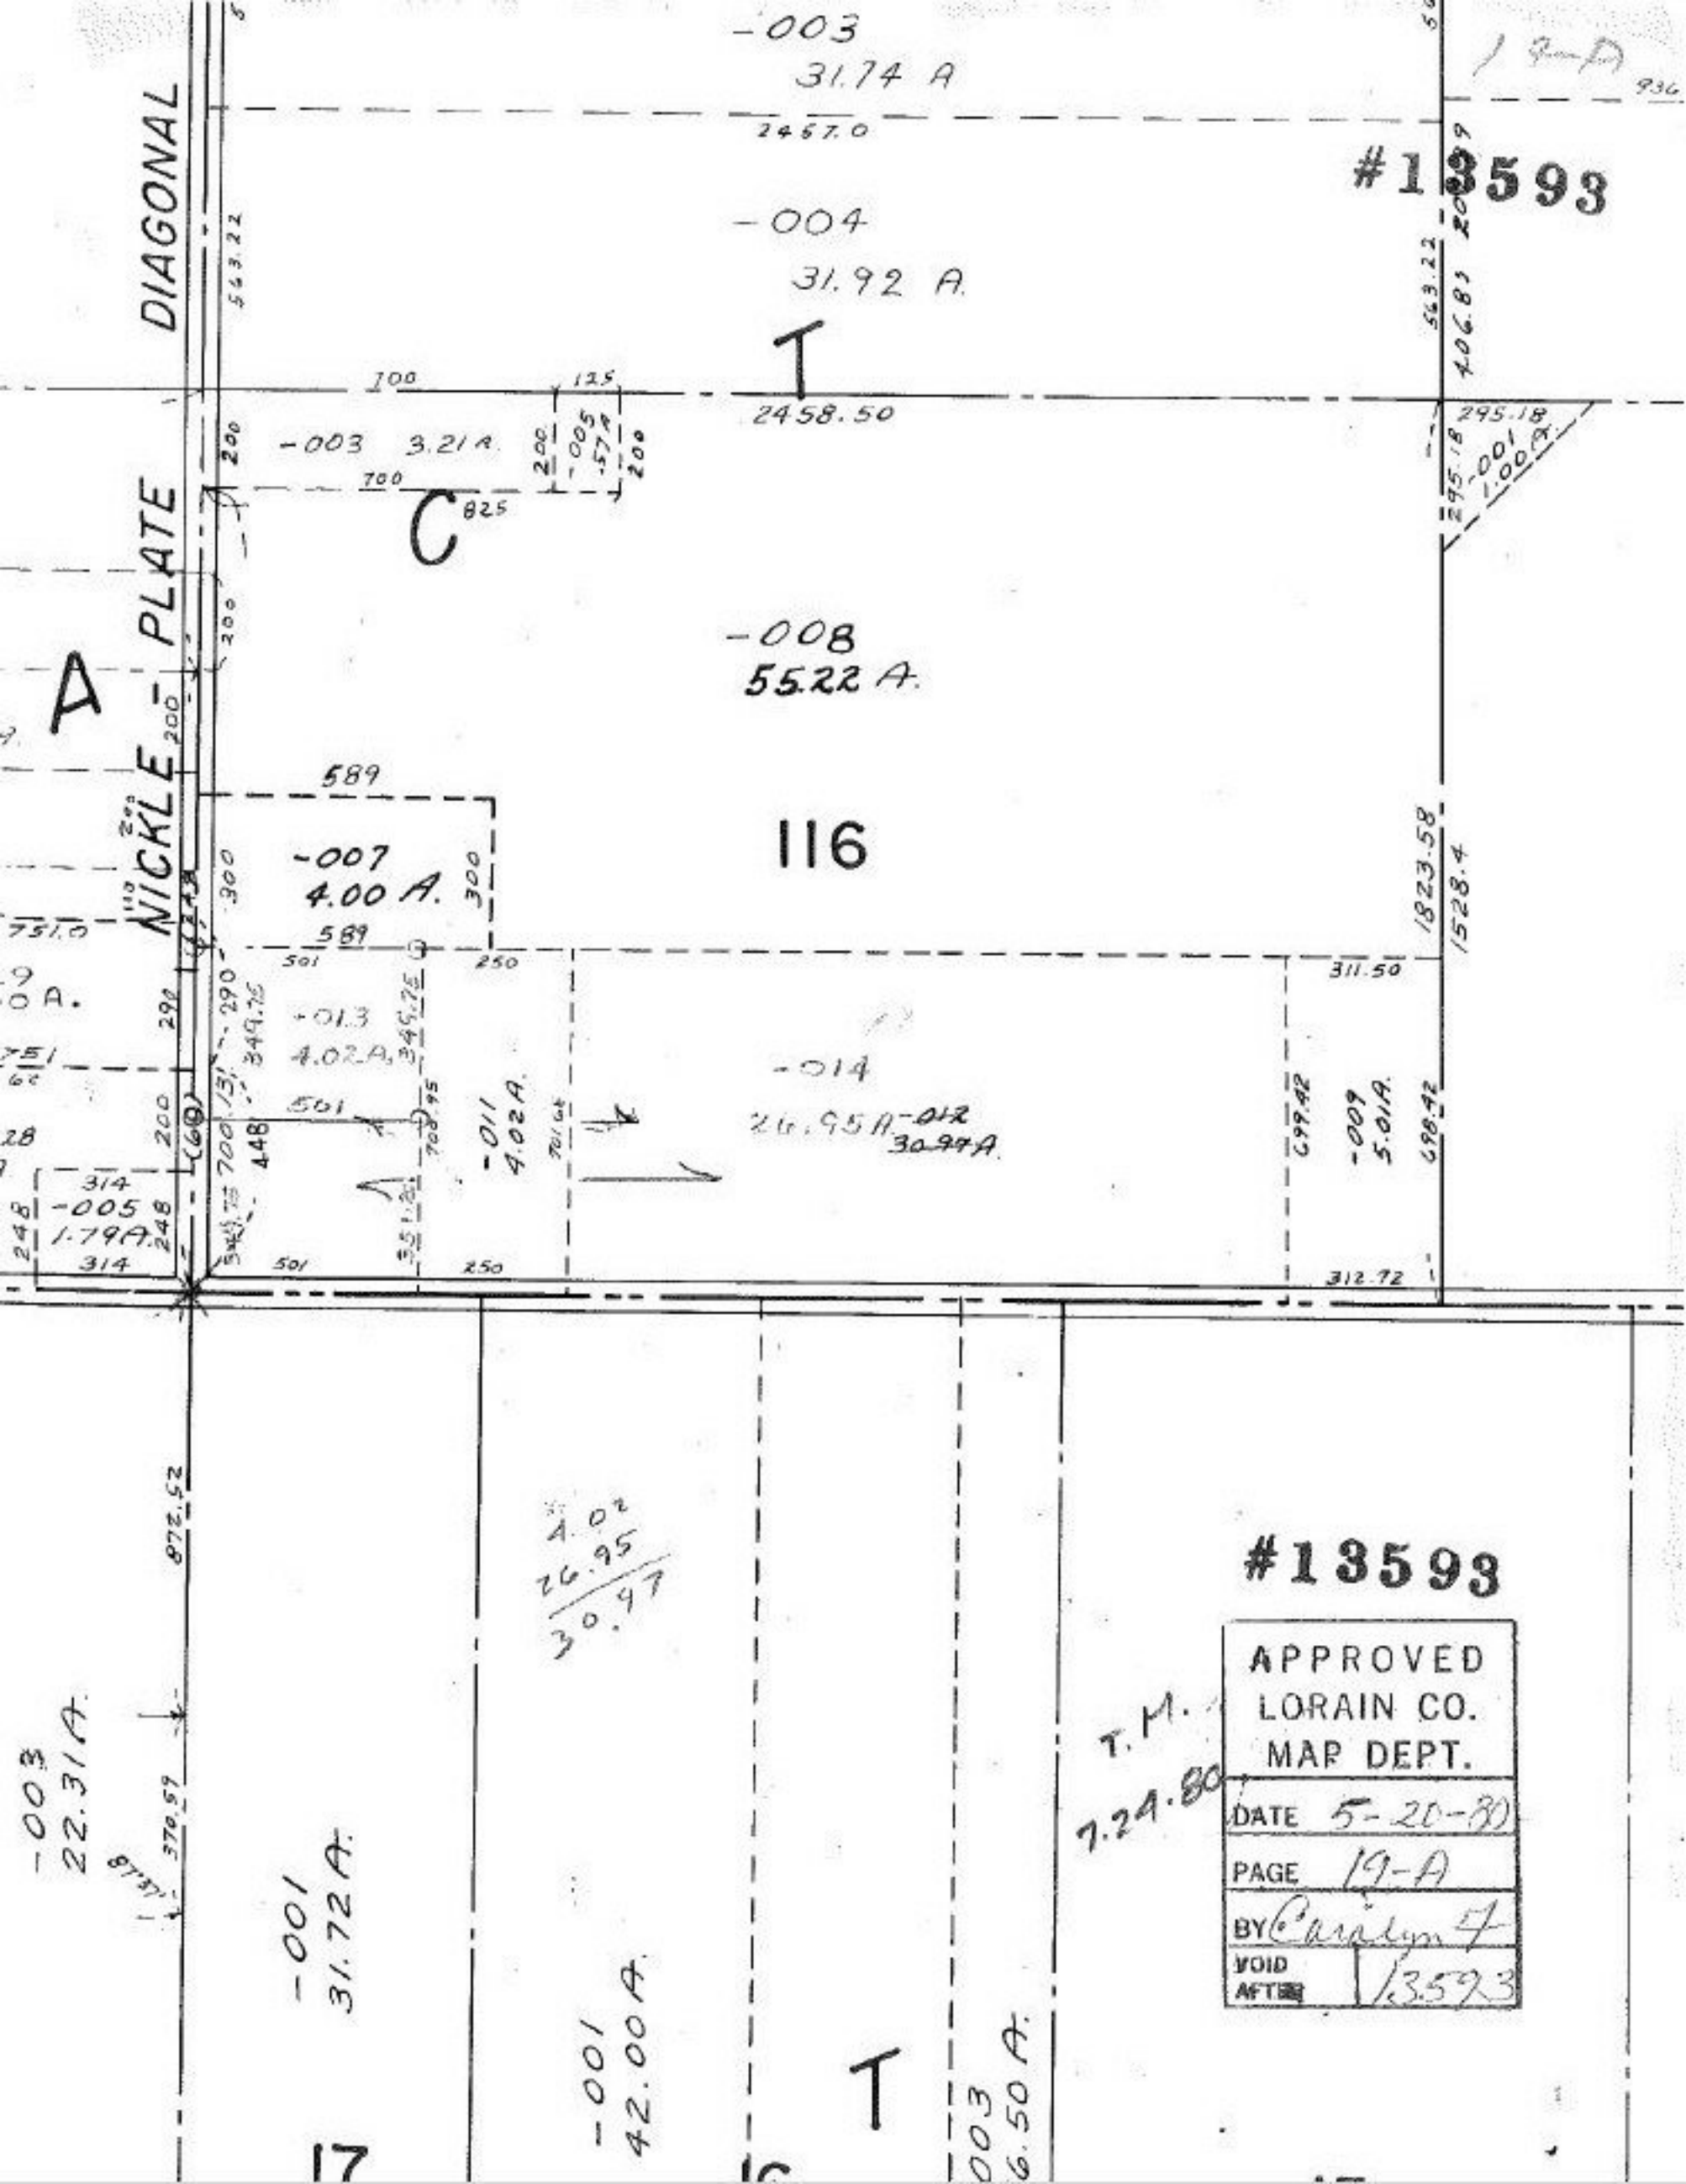

#13593

APPROVED
LORAIN CO.
MAP DEPT.

DATE 5-20-80
PAGE 19-A
BY Carolyn F
VOID AFTER 13593

T.M.
7.24.80