3-00 098-B

#13594
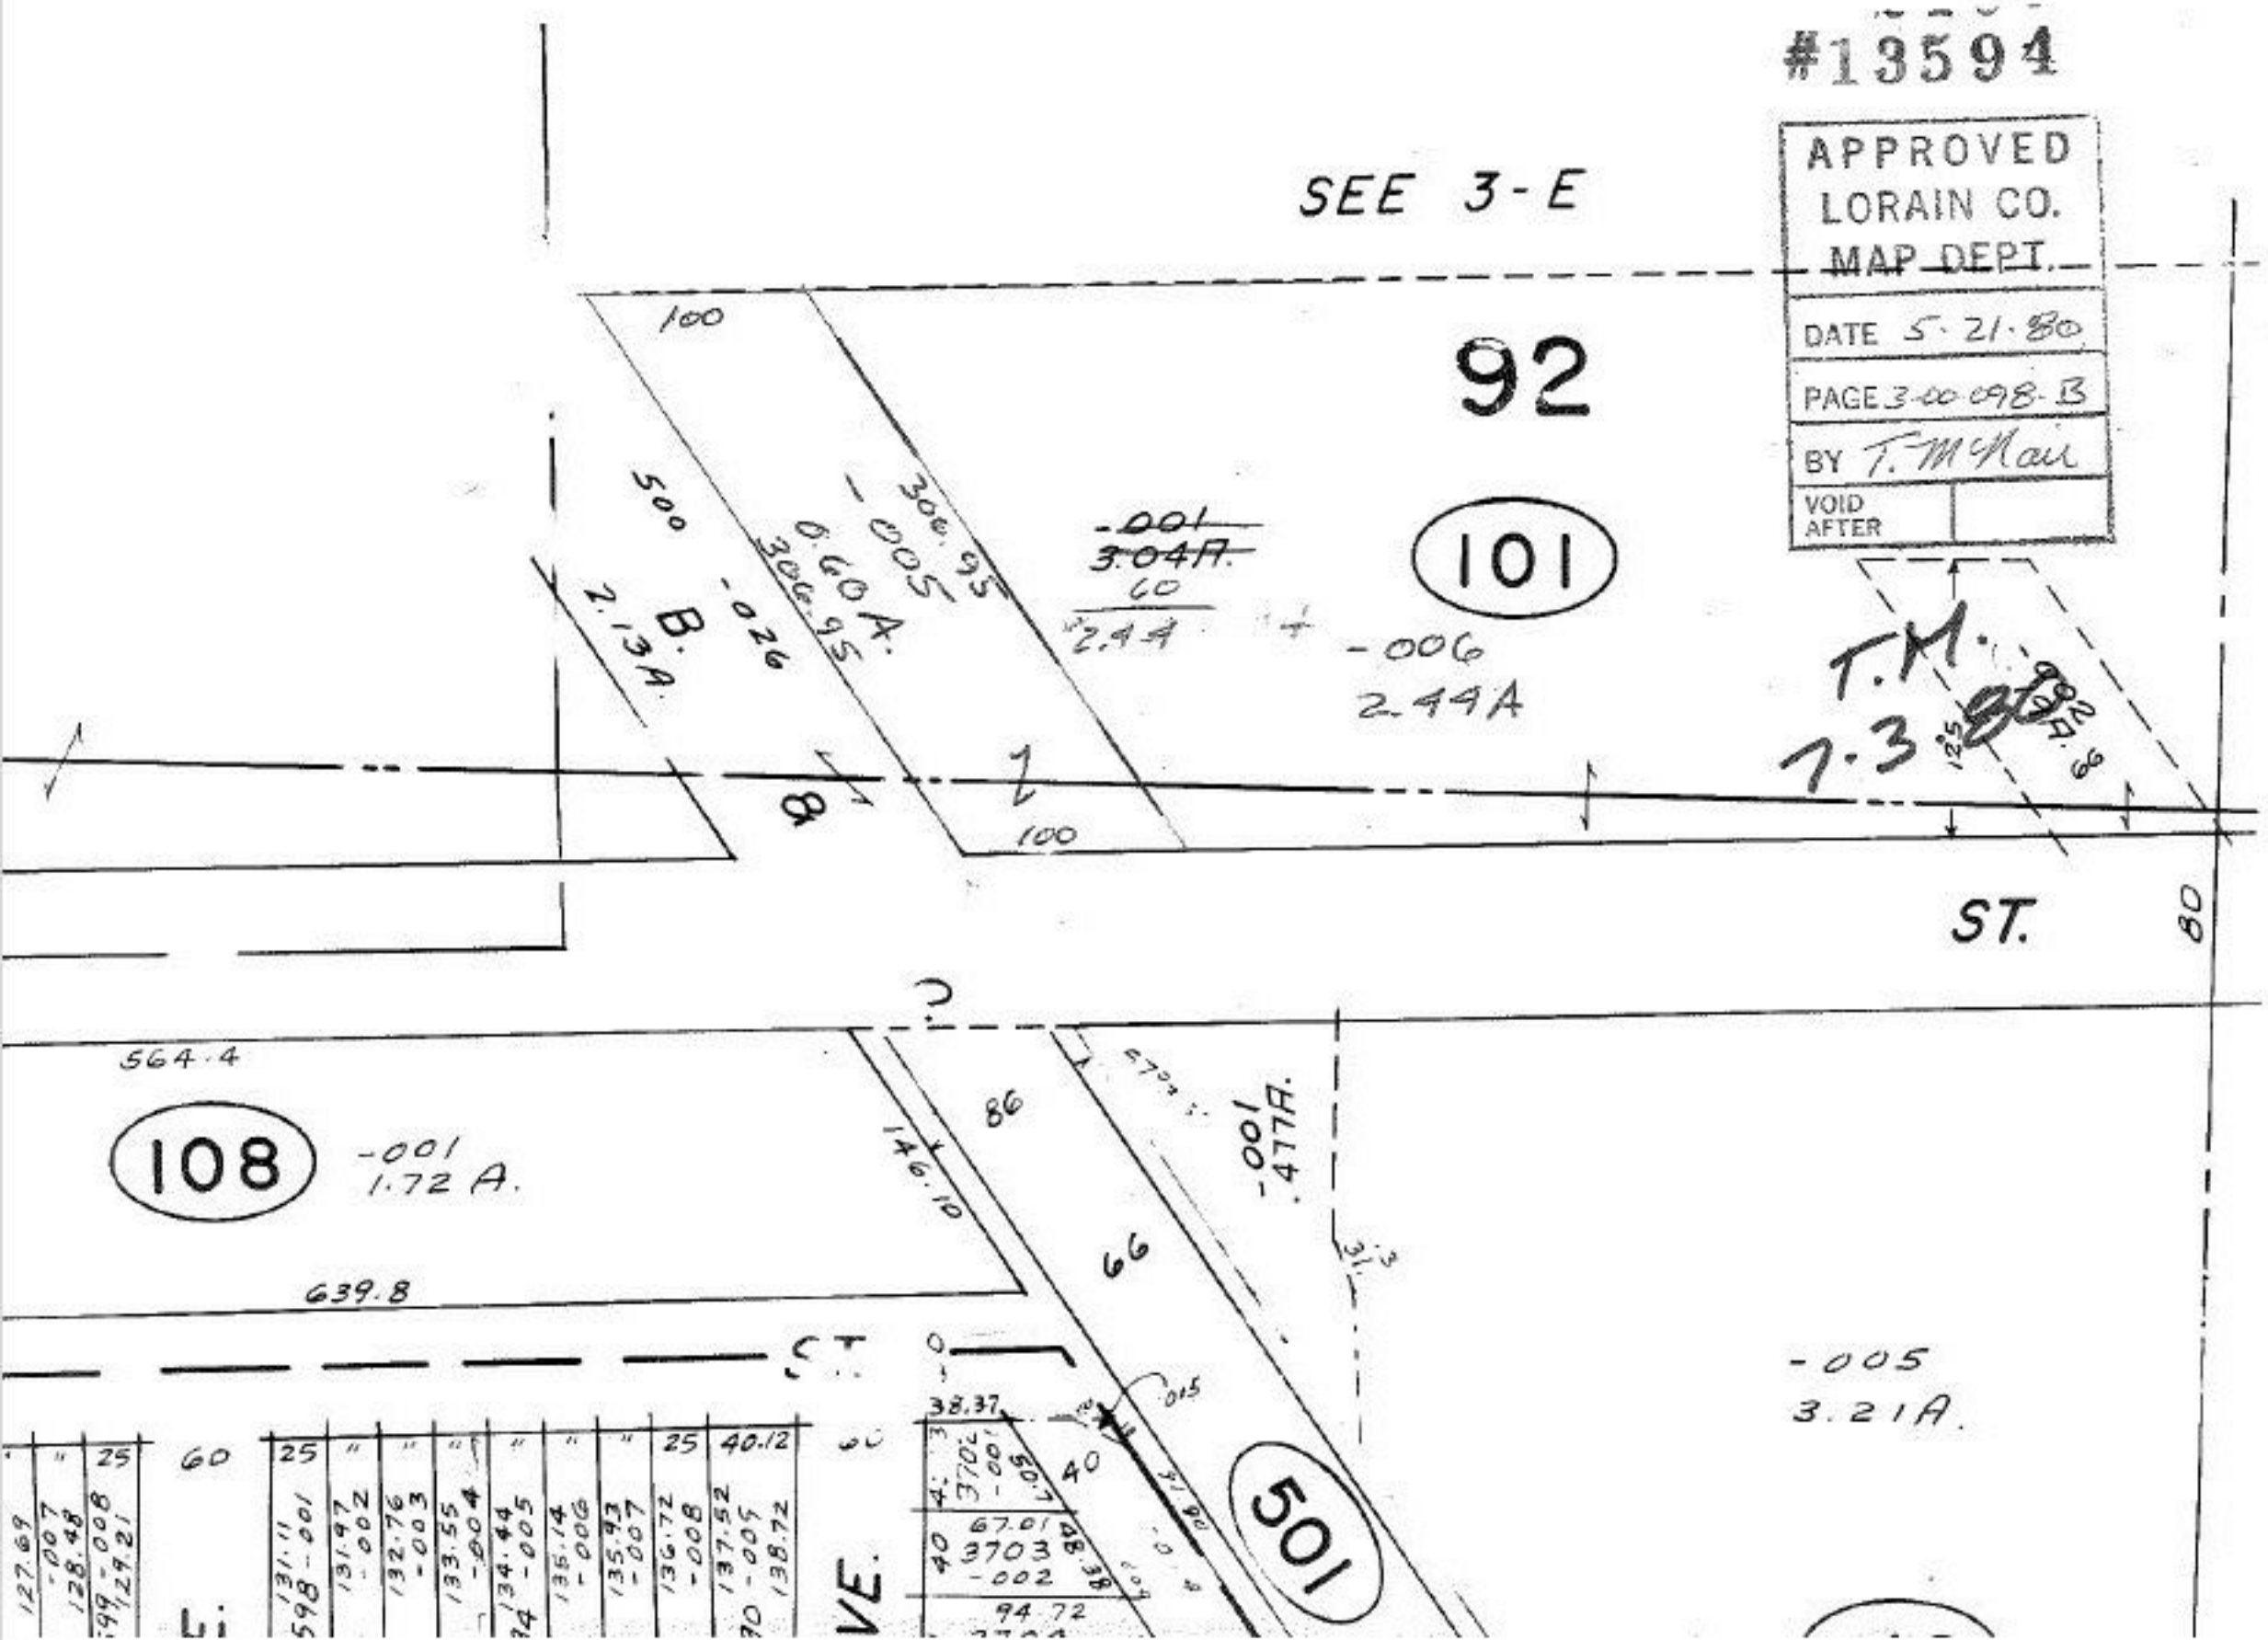
APPROVED
LORAIN CO.
MAP DEPT.
DATE 5-21-80
PAGE 3-00 098-B
BY T. McNair
VOID AFTER