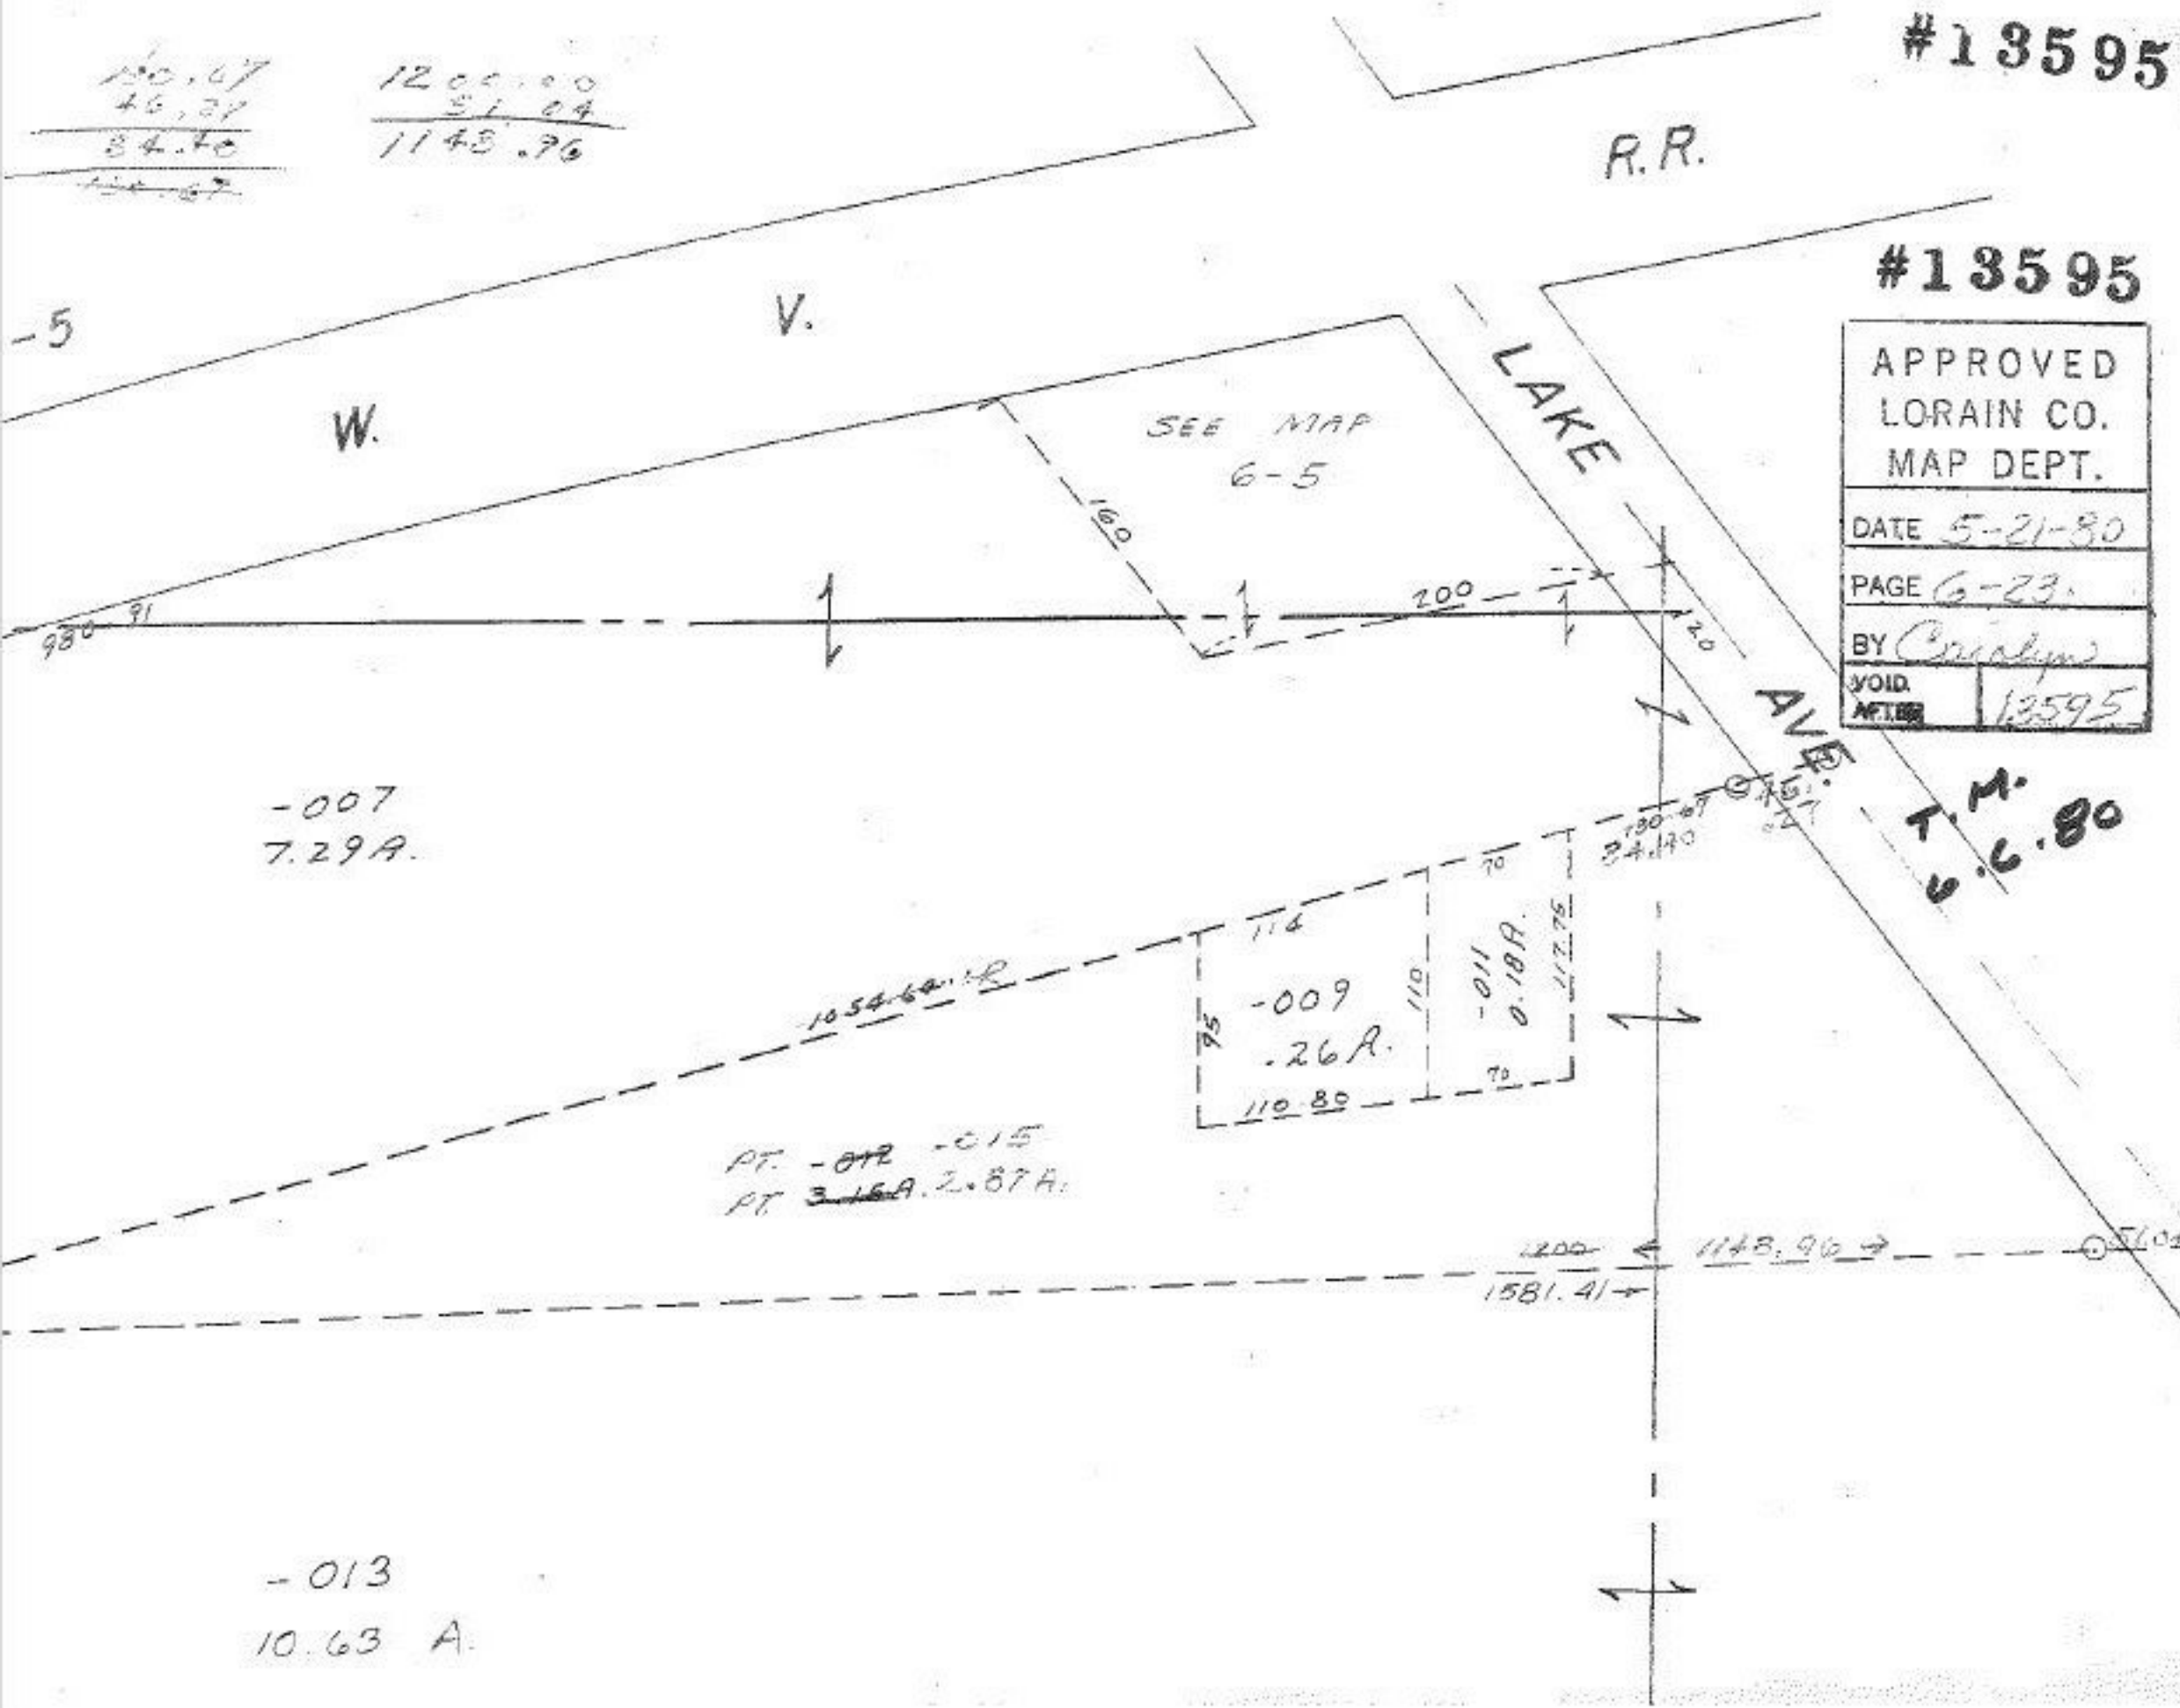
#13595
#13595
APPROVED
LORAIN CO.
MAP DEPT.
DATE 5-21-80
PAGE 6-23
BY Carolyn
VOID AFTER 13595
R.R.
V.
W.
-5
LAKE
AVE.
SEE MAP
6-5
160
200
120
980
91
-007
7.29A.
T.M.
6.6.80
-009
.26A.
-011
0.18A.
110
110.80
117.75
114
95
70
PT. -012 -015
PT. 3.16A. 2.87A.
1200
1148.96
1581.41
-013
10.63 A.