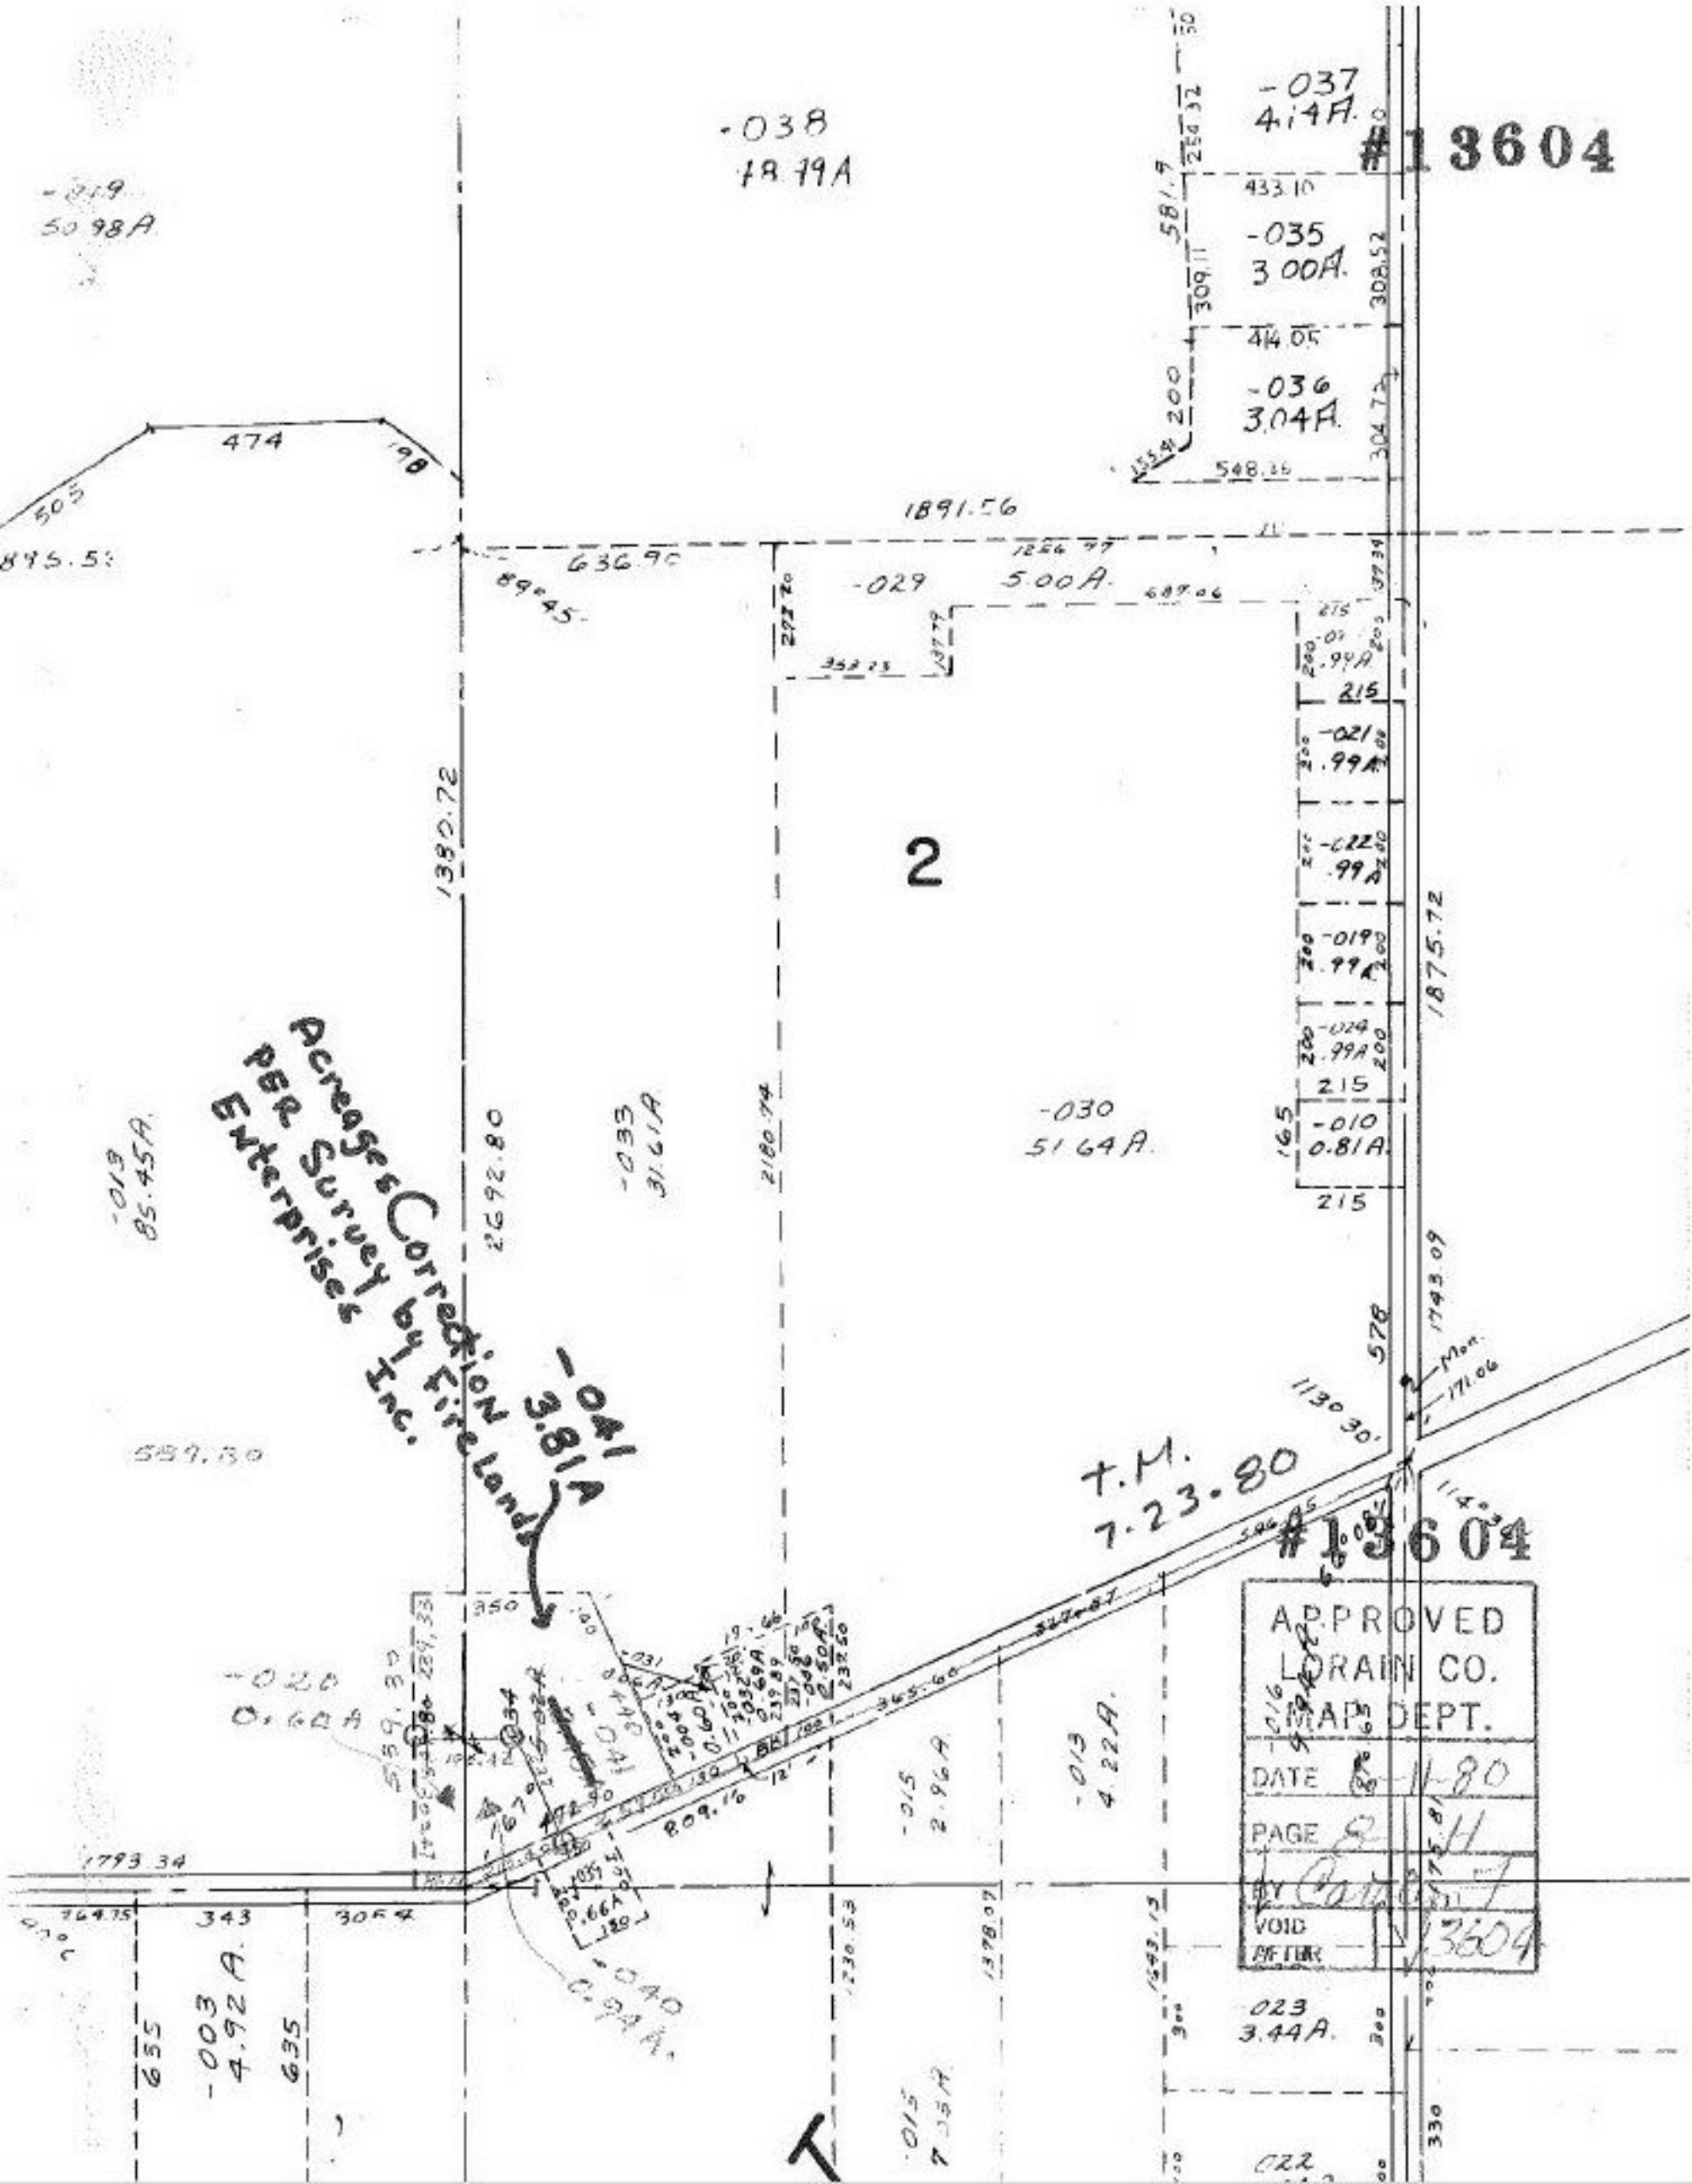

#13604
-038
18.79A
-037
4.14A
-035
3.00A
-036
3.04A
-019
50.98A
474
198
505
1891.56
636.90
-029
5.00A
1380.72
2
1875.72
-021
.99A
-022
.99A
-019
.99A
-024
.99A
-010
0.81A
-030
51.64A
-033
31.61A
-013
85.45A
2692.80
2180.74
Acreages Correction
PER Survey by Fire Lands
Enterprises Inc.
-041
3.81A
T.M.
7.23.80
#13604
APPROVED
LORAIN CO.
MAP DEPT.
DATE 8-11-80
PAGE 8-H
BY
VOID
AFTER
-020
0.60A
-015
2.96A
-013
4.22A
-040
0.94A
-003
4.92A
-023
3.44A
-015
7.35A
1793.34