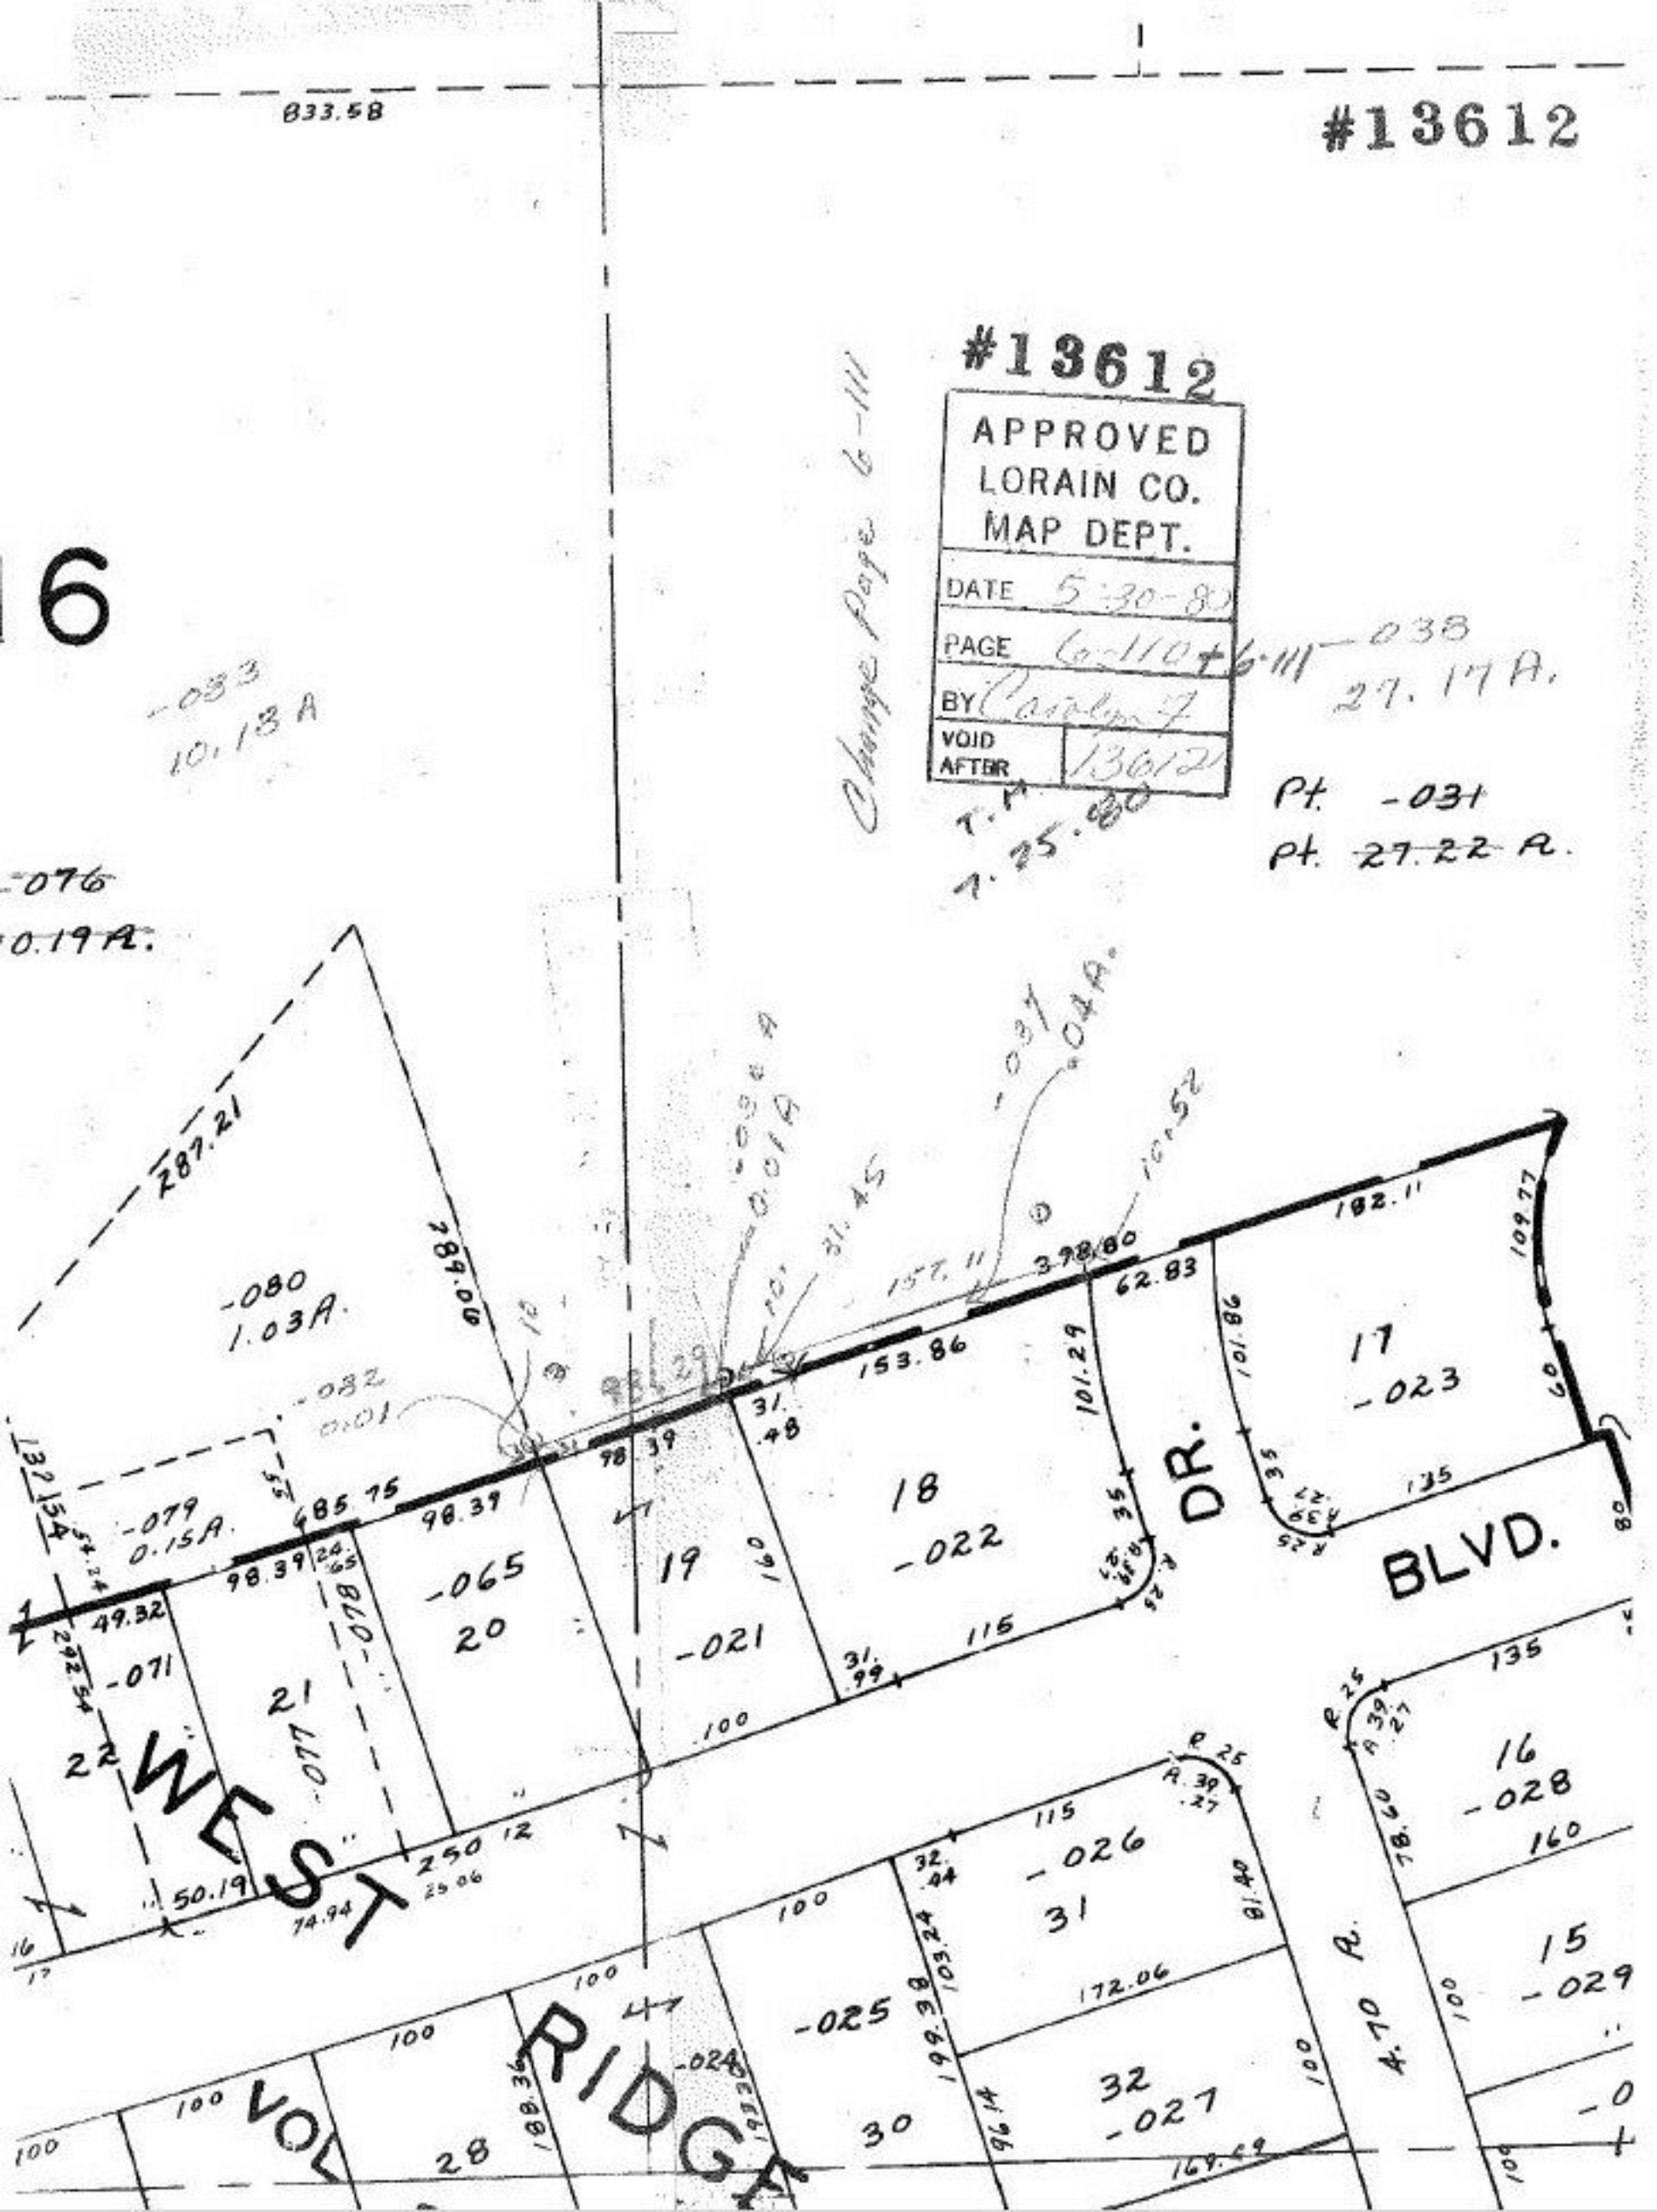

#13612
833.58
#13612
APPROVED
LORAIN CO.
MAP DEPT.
DATE 5-30-80
PAGE 6-110 + 6-111
BY Carolyn F
VOID AFTER 13612
Change Page 6-111
-038
27.17 A.
Pt. -031
Pt. 27.22 A.
16
-083
10.18 A
-076
0.19 A.
287.21
-080
1.03 A.
-082
0.01
-079
0.15 A.
-065
20
19
-021
18
-022
17
-023
DR.
BLVD.
WEST
RIDGE
VOL
-071
21
22
-026
31
-025
30
32
-027
28
16
-028
15
-029
4.70 A.