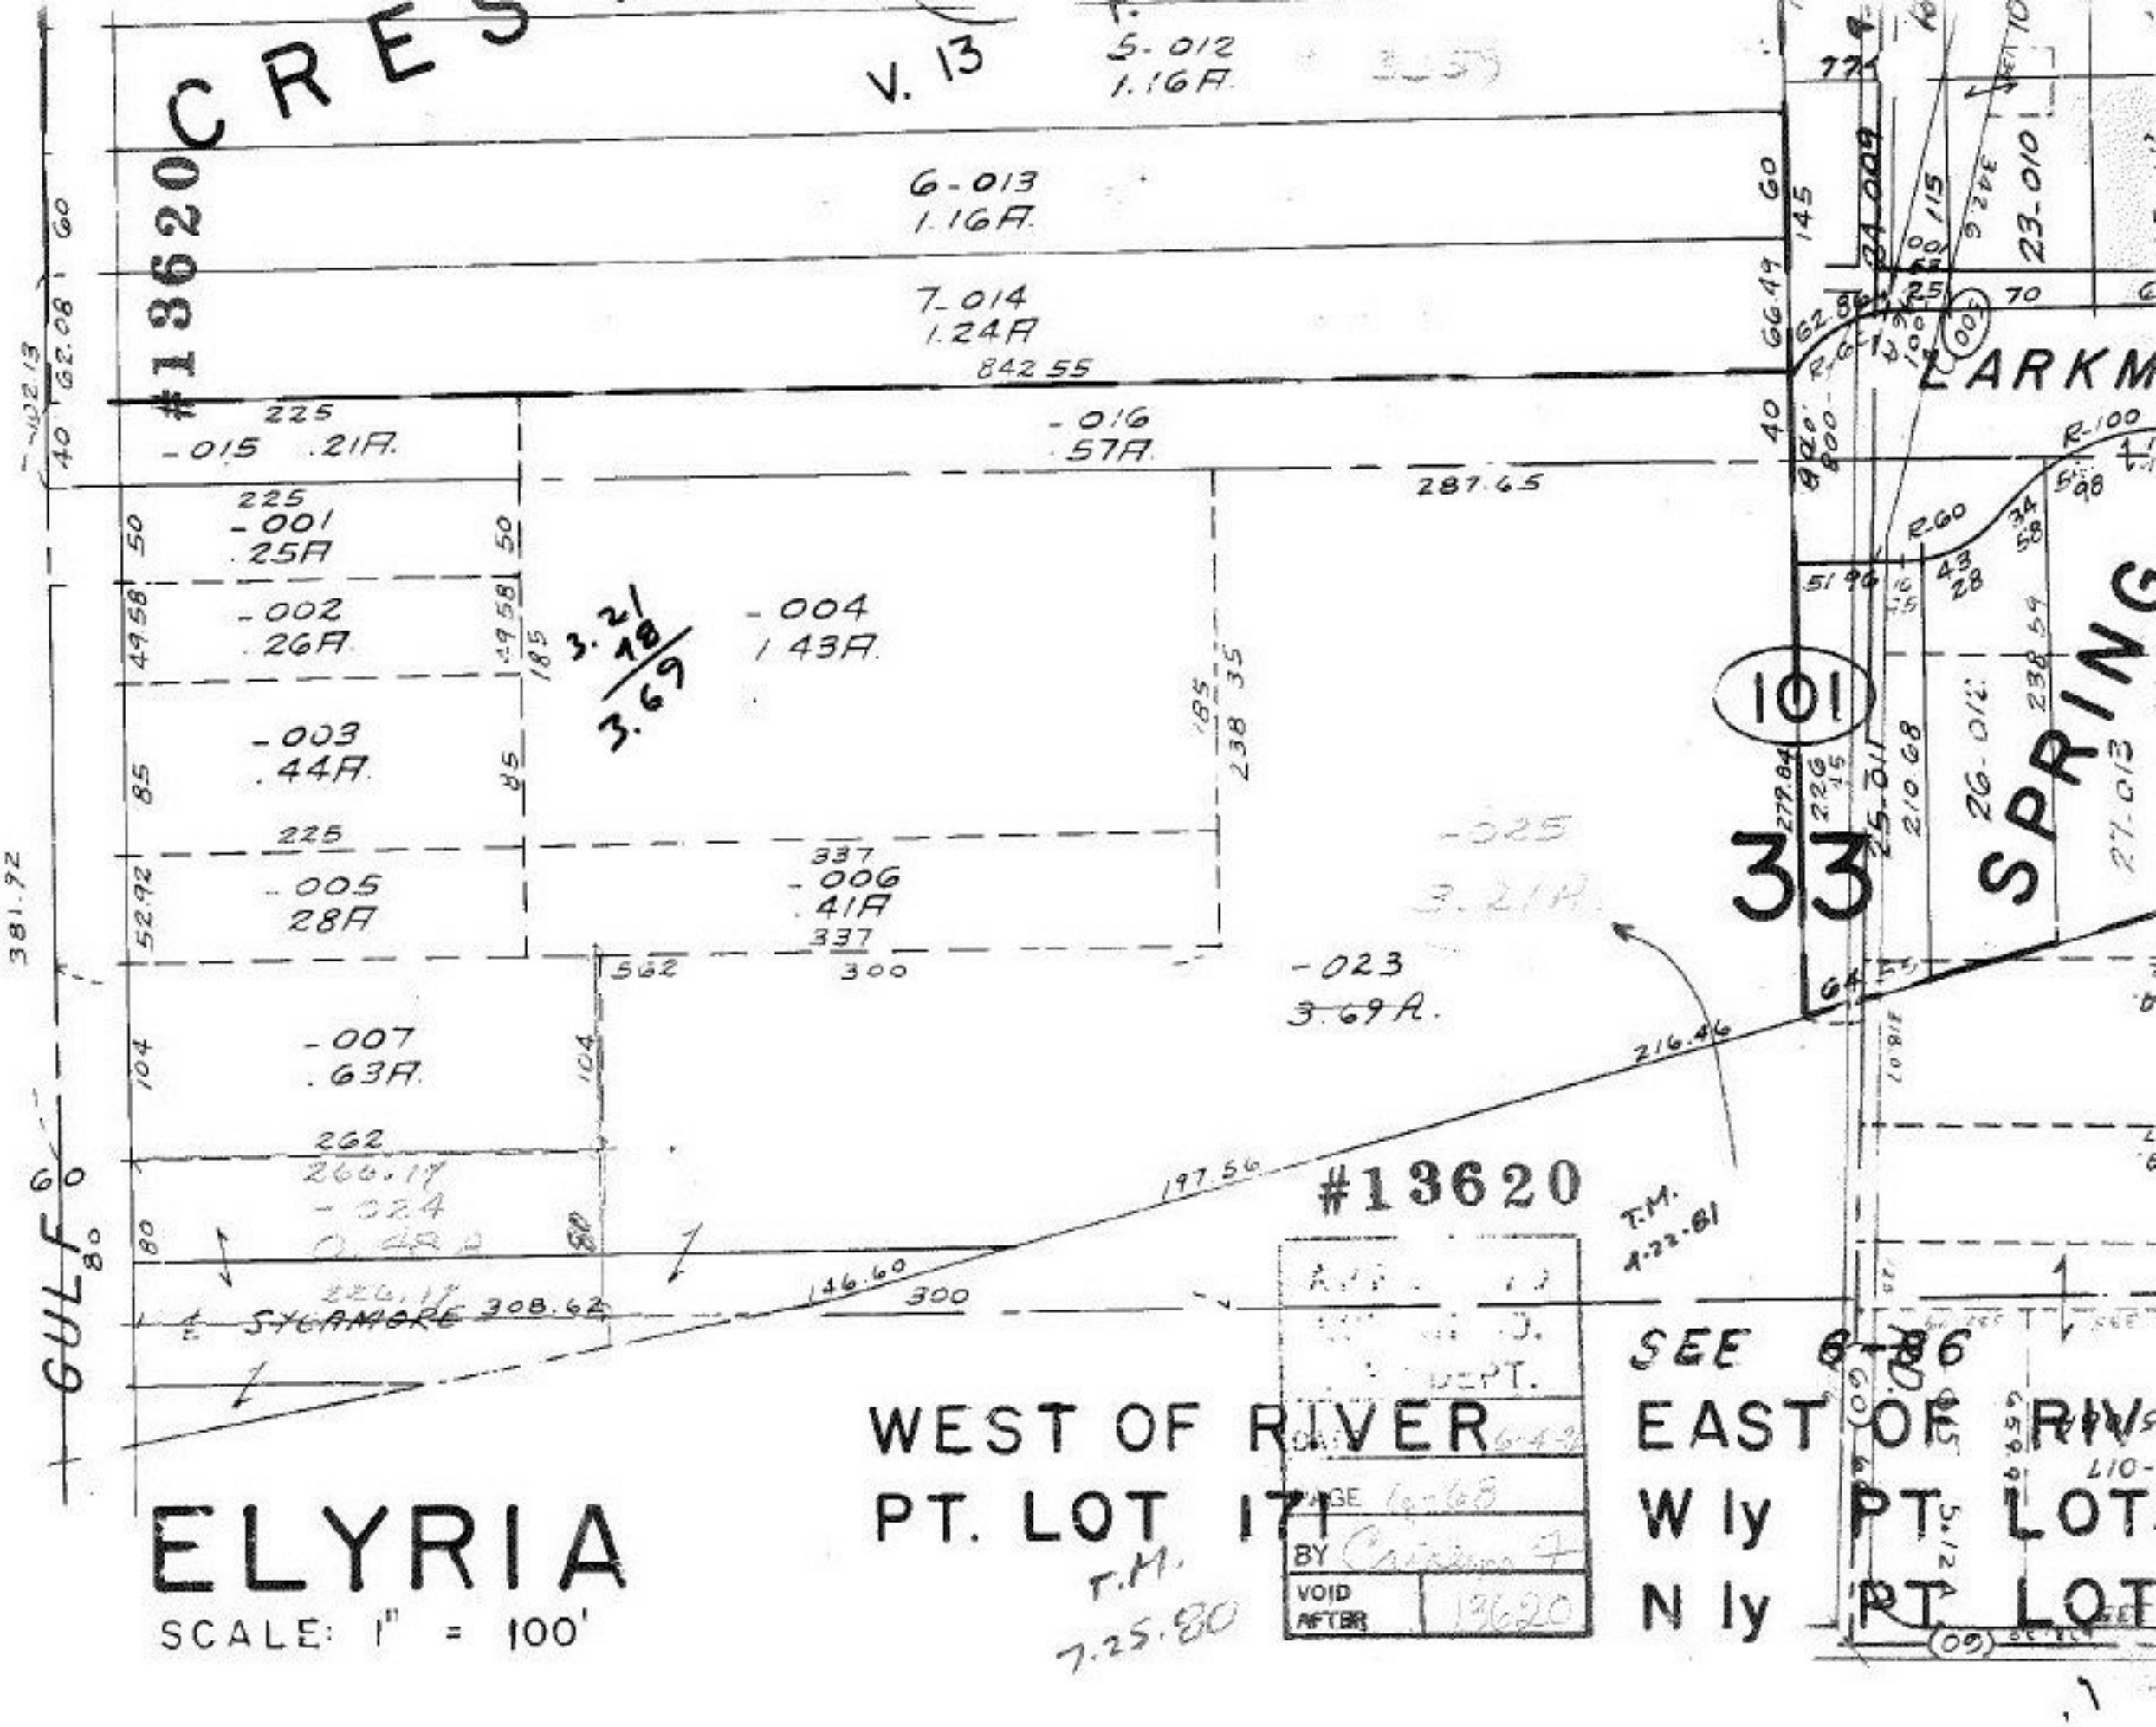

#13620

DEPT.

DATE 6-4-92

PAGE 6-68

BY

VOID AFTER 13620