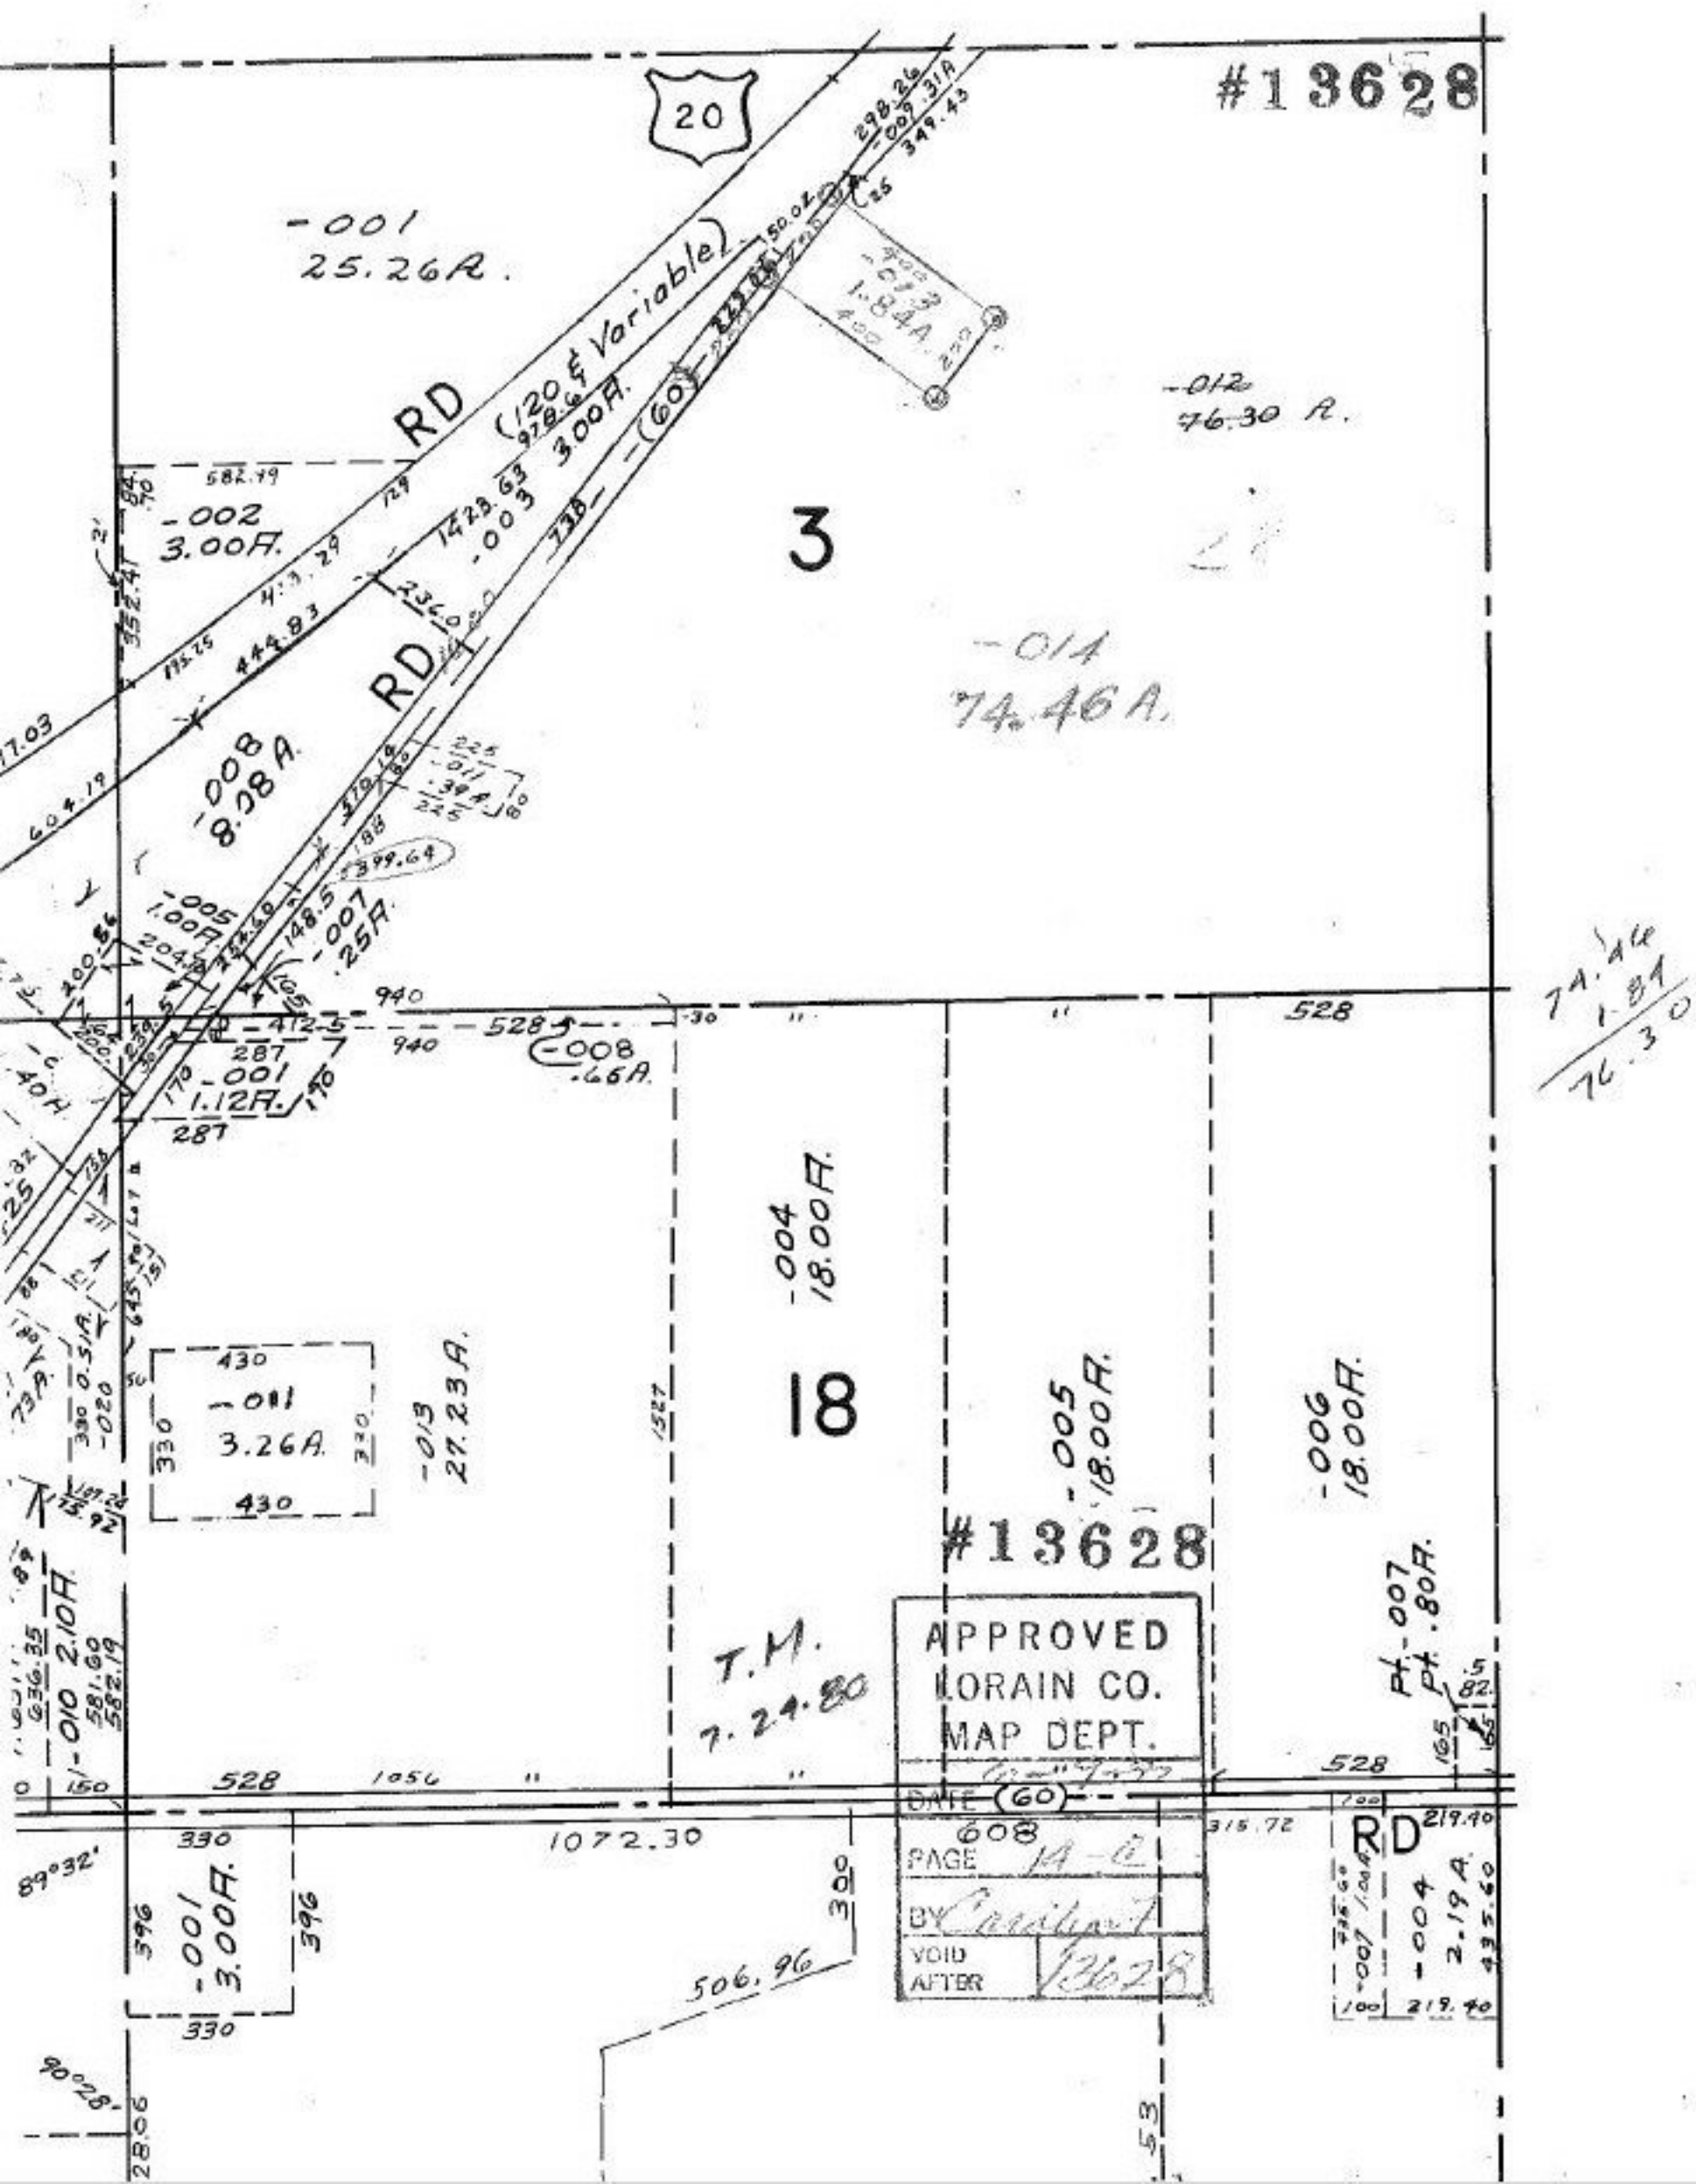
#13628
20
-001
25.26A.
RD
(120 & Variable)
3.00A.
-002
3.00A.
-003
-(60)
-012
76.30 A.
3
-014
74.46 A.
-008
8.08A.
RD
-005
1.00A.
-007
.25A.
-008
.66A.
-001
1.12A.
-004
18.00A.
18
-005
18.00A.
-006
18.00A.
-011
3.26A.
-013
27.23A.
-010 2.10A.
#13628
T.M.
7.24.80
APPROVED
LORAIN CO.
MAP DEPT.
DATE (60)
608
PAGE 14-C
BY
VOID AFTER 13628
-001
3.00A.
RD
-004
2.19A.
1072.30
506.96
528
1056
330
396
300
74.46
1.84
76.30