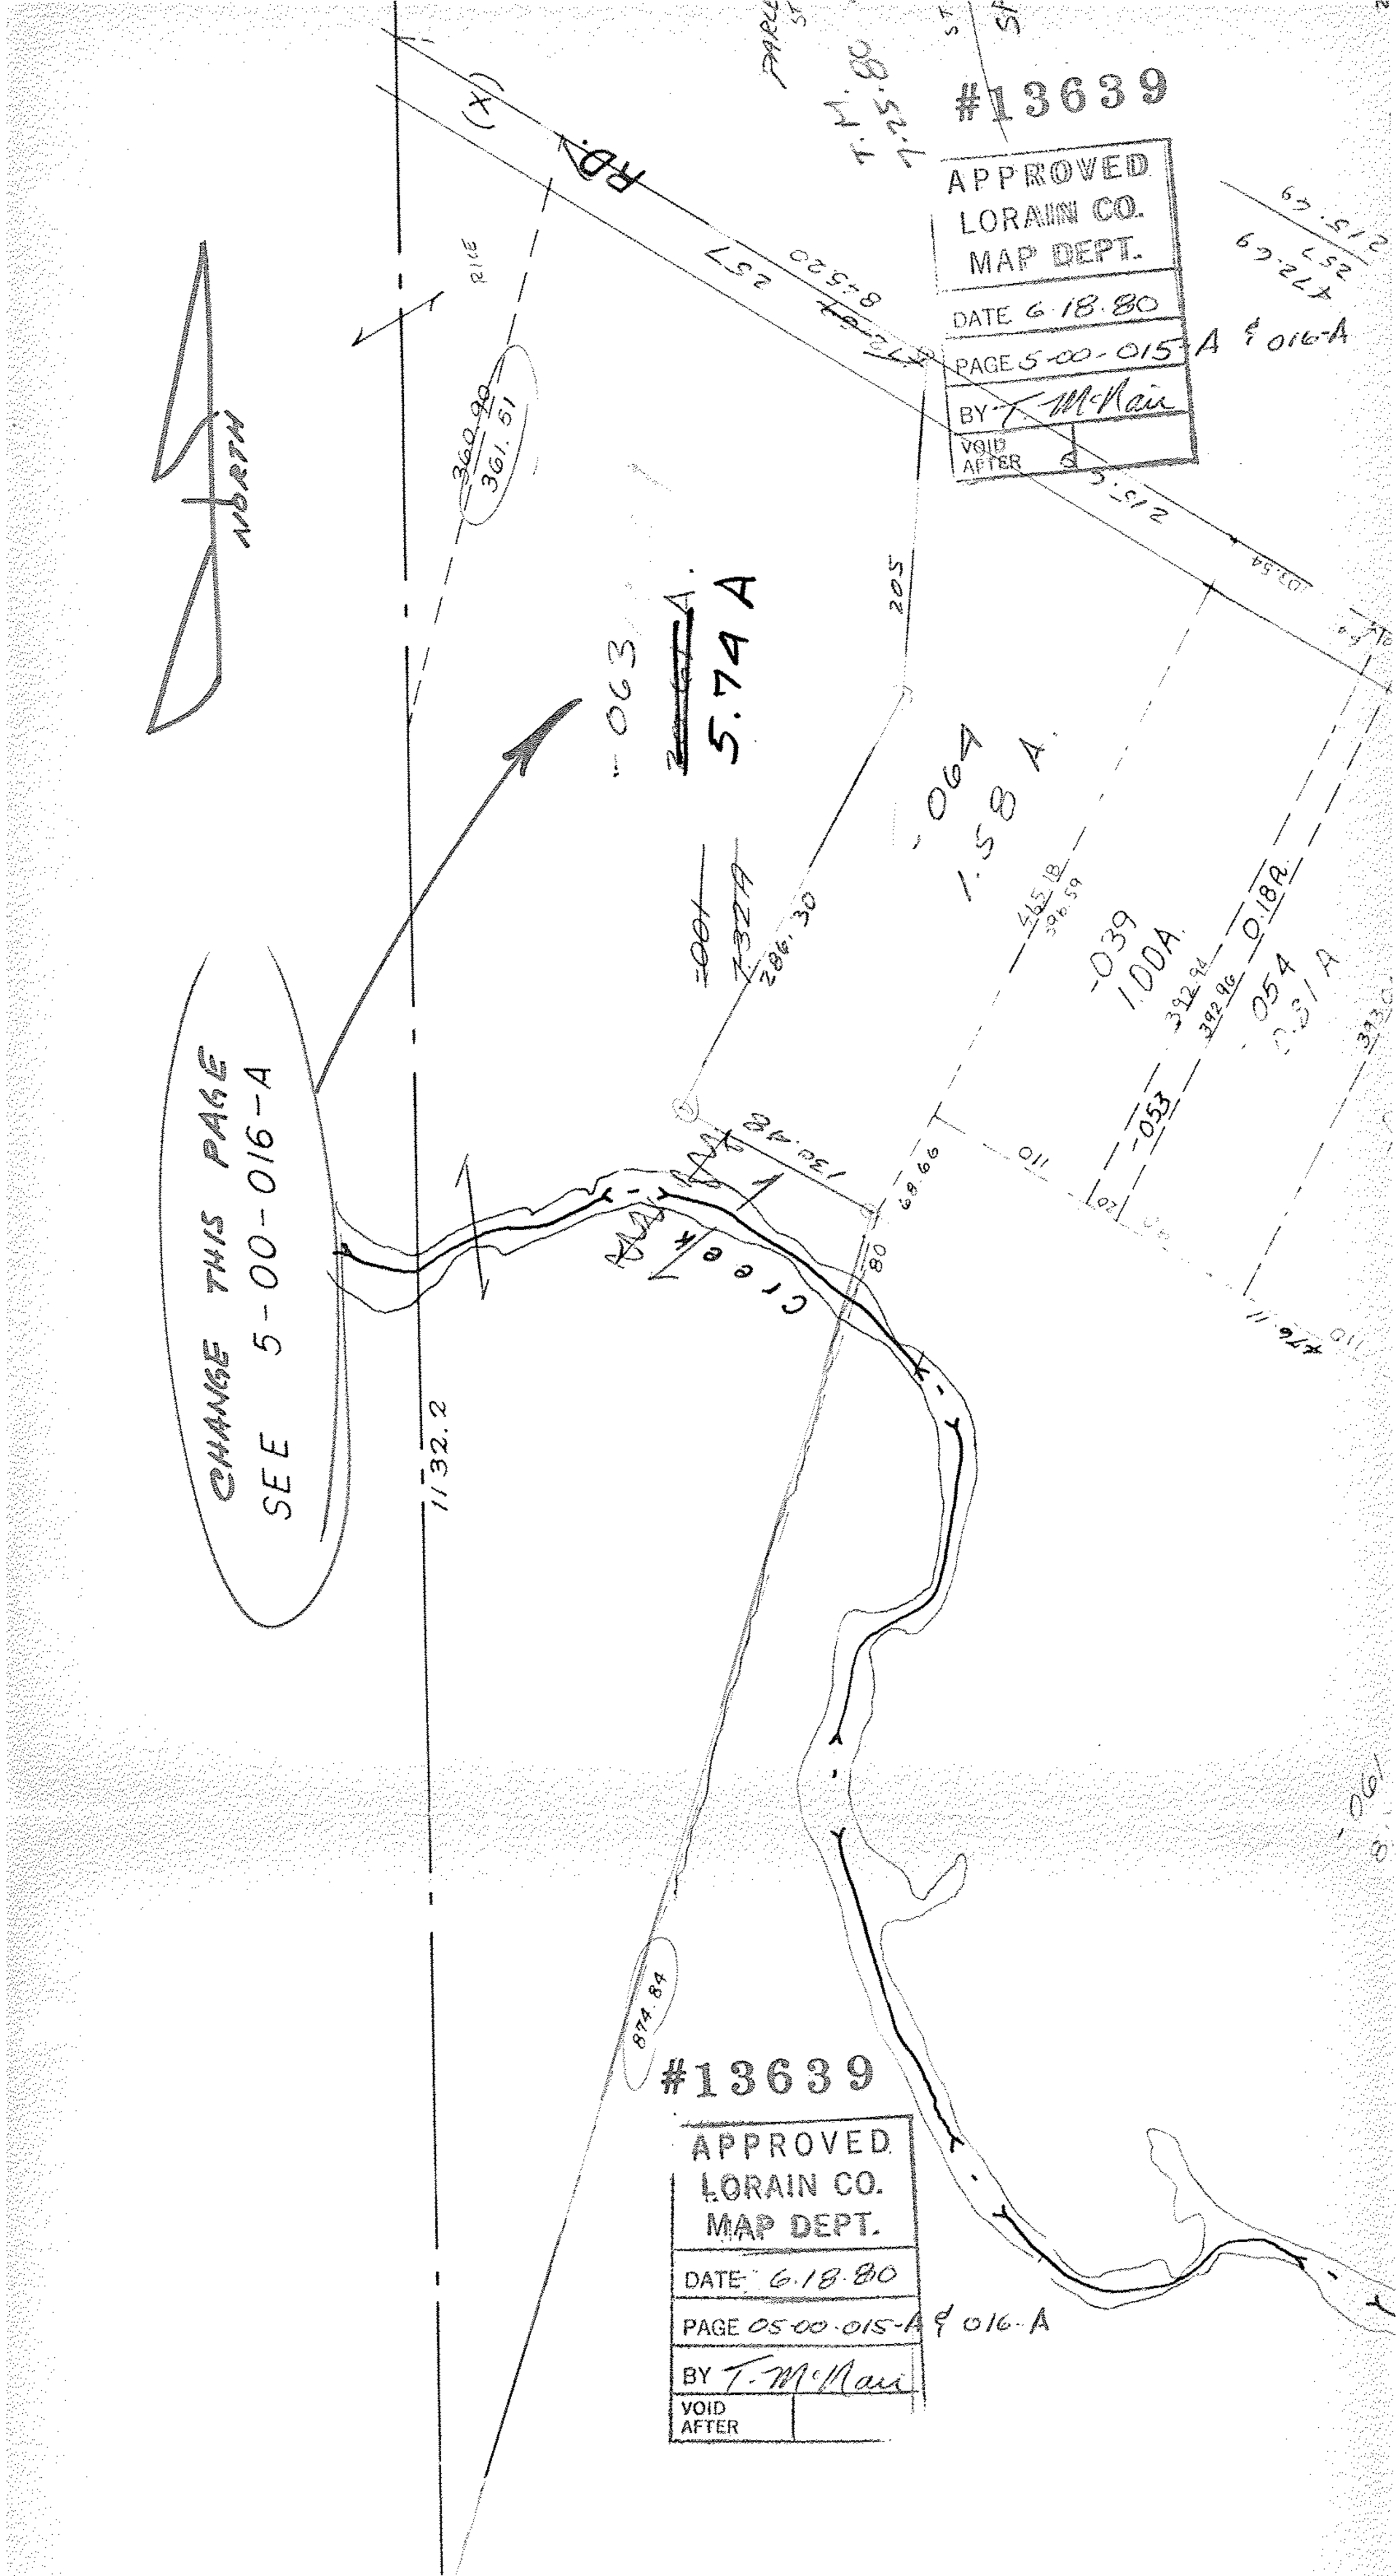
#13639
APPROVED
LORAIN CO.
MAP DEPT.
DATE 6.18.80
PAGE 5-00-015-A & 016-A
BY T. McNair
VOID AFTER
NORTH
RD.
T.M. 7-25-80
RICE
360.90
361.51
-063
5.74 A
205
-064
1.58 A
-039
1.00A
0.18A
-053
-054
0.31 A
-001
7.32A
286.30
130.48
68.66
80
Creek
CHANGE THIS PAGE
SEE 5-00-016-A
1132.2
874.84
#13639
APPROVED
LORAIN CO.
MAP DEPT.
DATE 6.18.80
PAGE 05-00-015-A & 016-A
BY T. McNair
VOID AFTER