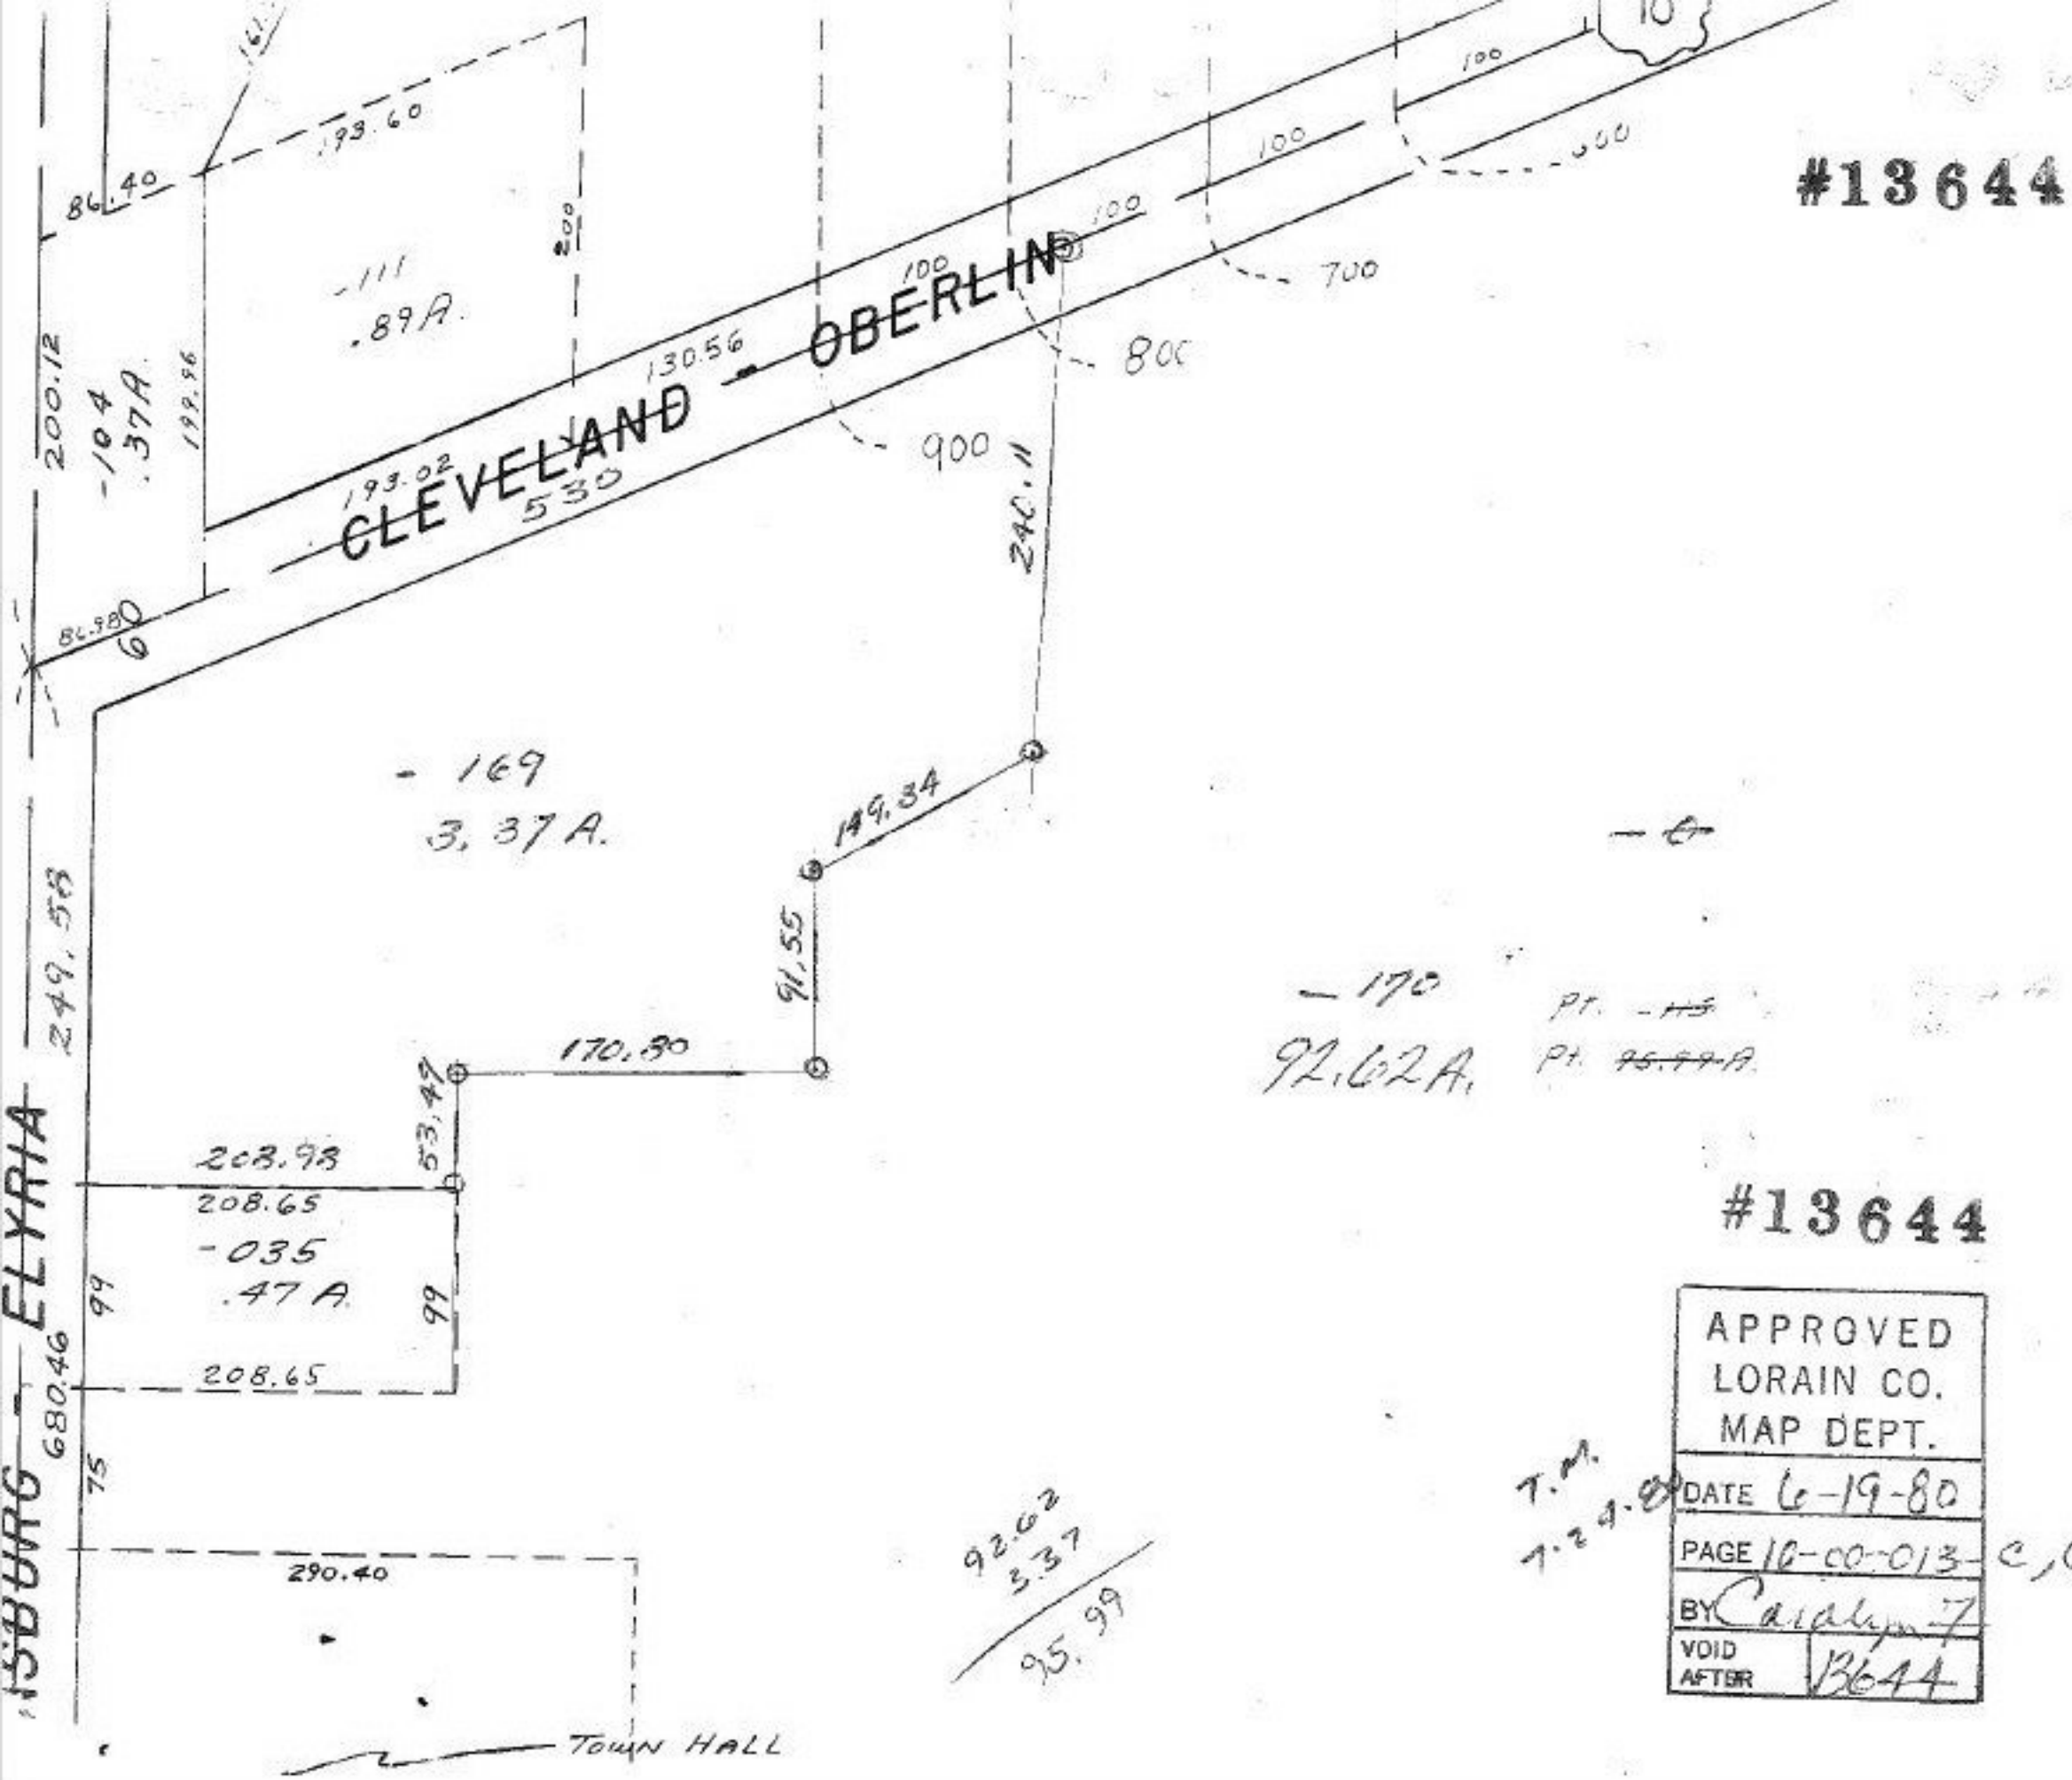

#13644

APPROVED
LORAIN CO.
MAP DEPT.

DATE 6-19-80

PAGE 10-00-013- C, G, H

BY Carolyn T

VOID AFTER 13644