#13650

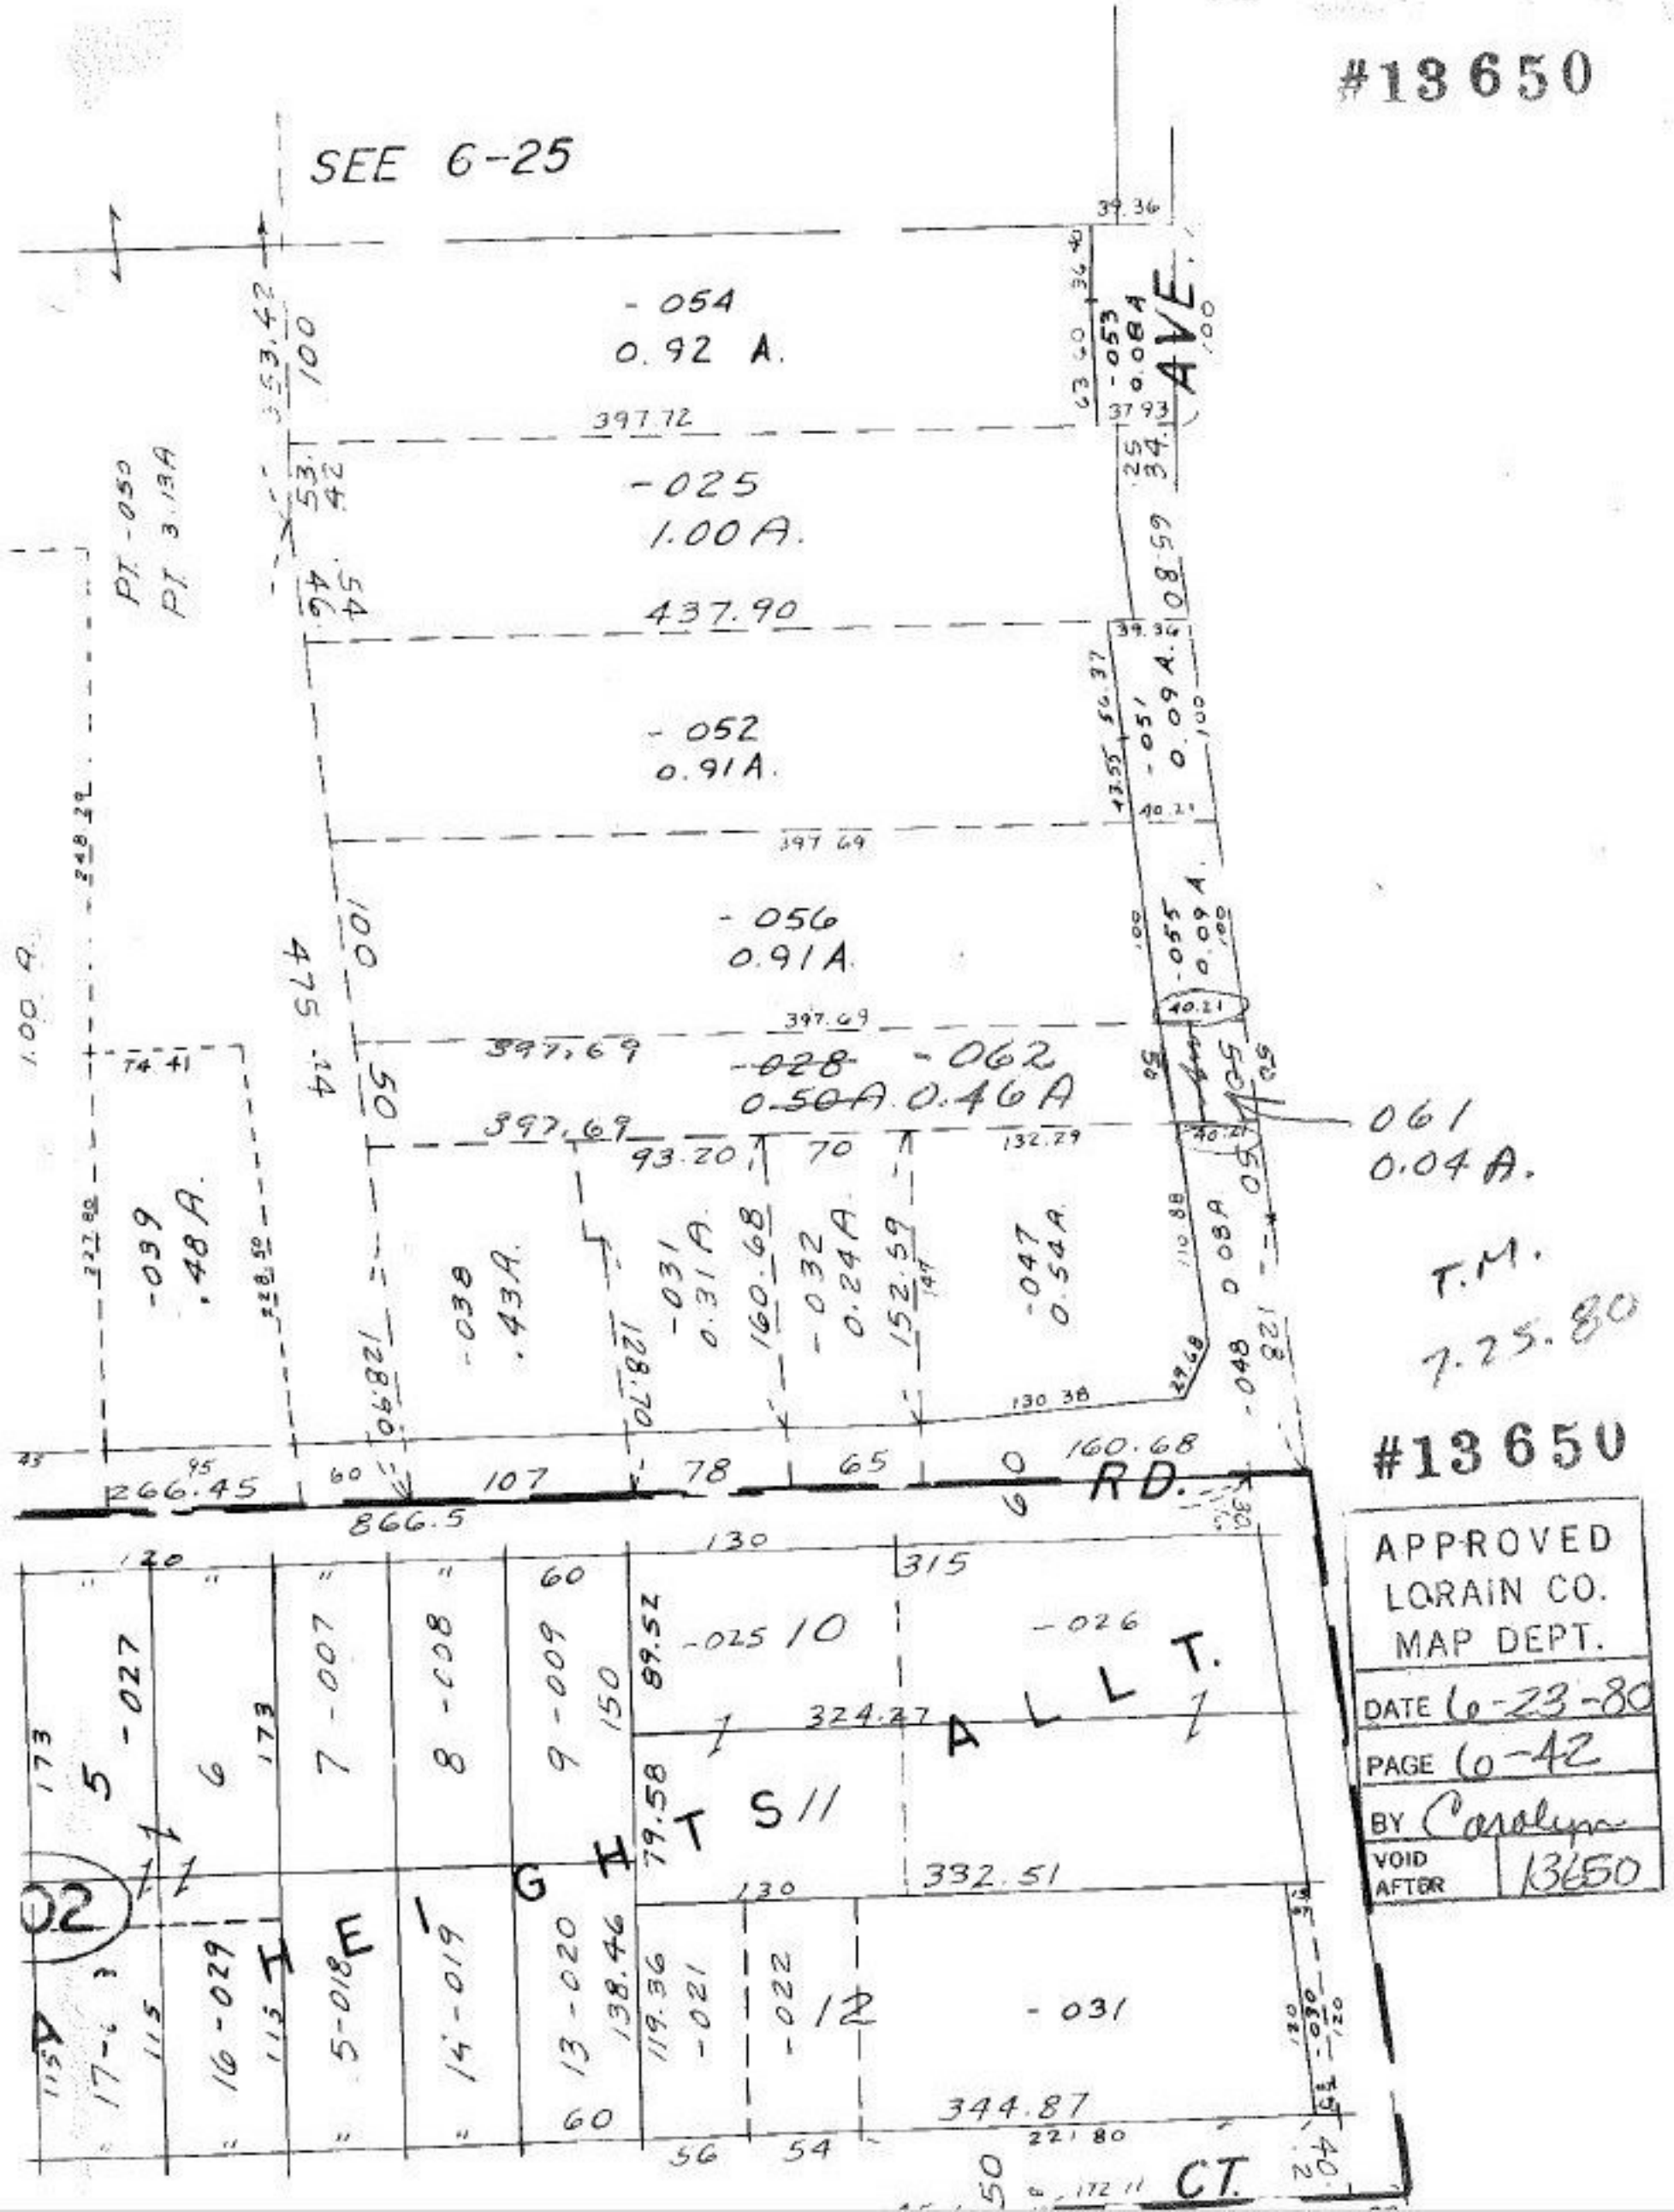
SEE 6-25
-054
0.92 A.
-025
1.00 A.
-052
0.91 A.
-056
0.91 A.
-028
0.50 A.
-062
0.46 A
-053
0.08 A
-051
0.09 A.
-055
0.09 A.
-061
0.04 A.
-039
.48 A.
-038
.43 A.
-031
0.31 A.
-032
0.24 A.
-047
0.54 A.
-048
0.08 A
PT. -050
PT. 3.13 A
AVE.
RD.
CT.
HEIGHTS ALLT.
T.M.
7.25.80
#13650
APPROVED
LORAIN CO.
MAP DEPT.
DATE 6-23-80
PAGE 6-42
BY Carolyn
VOID AFTER 13650