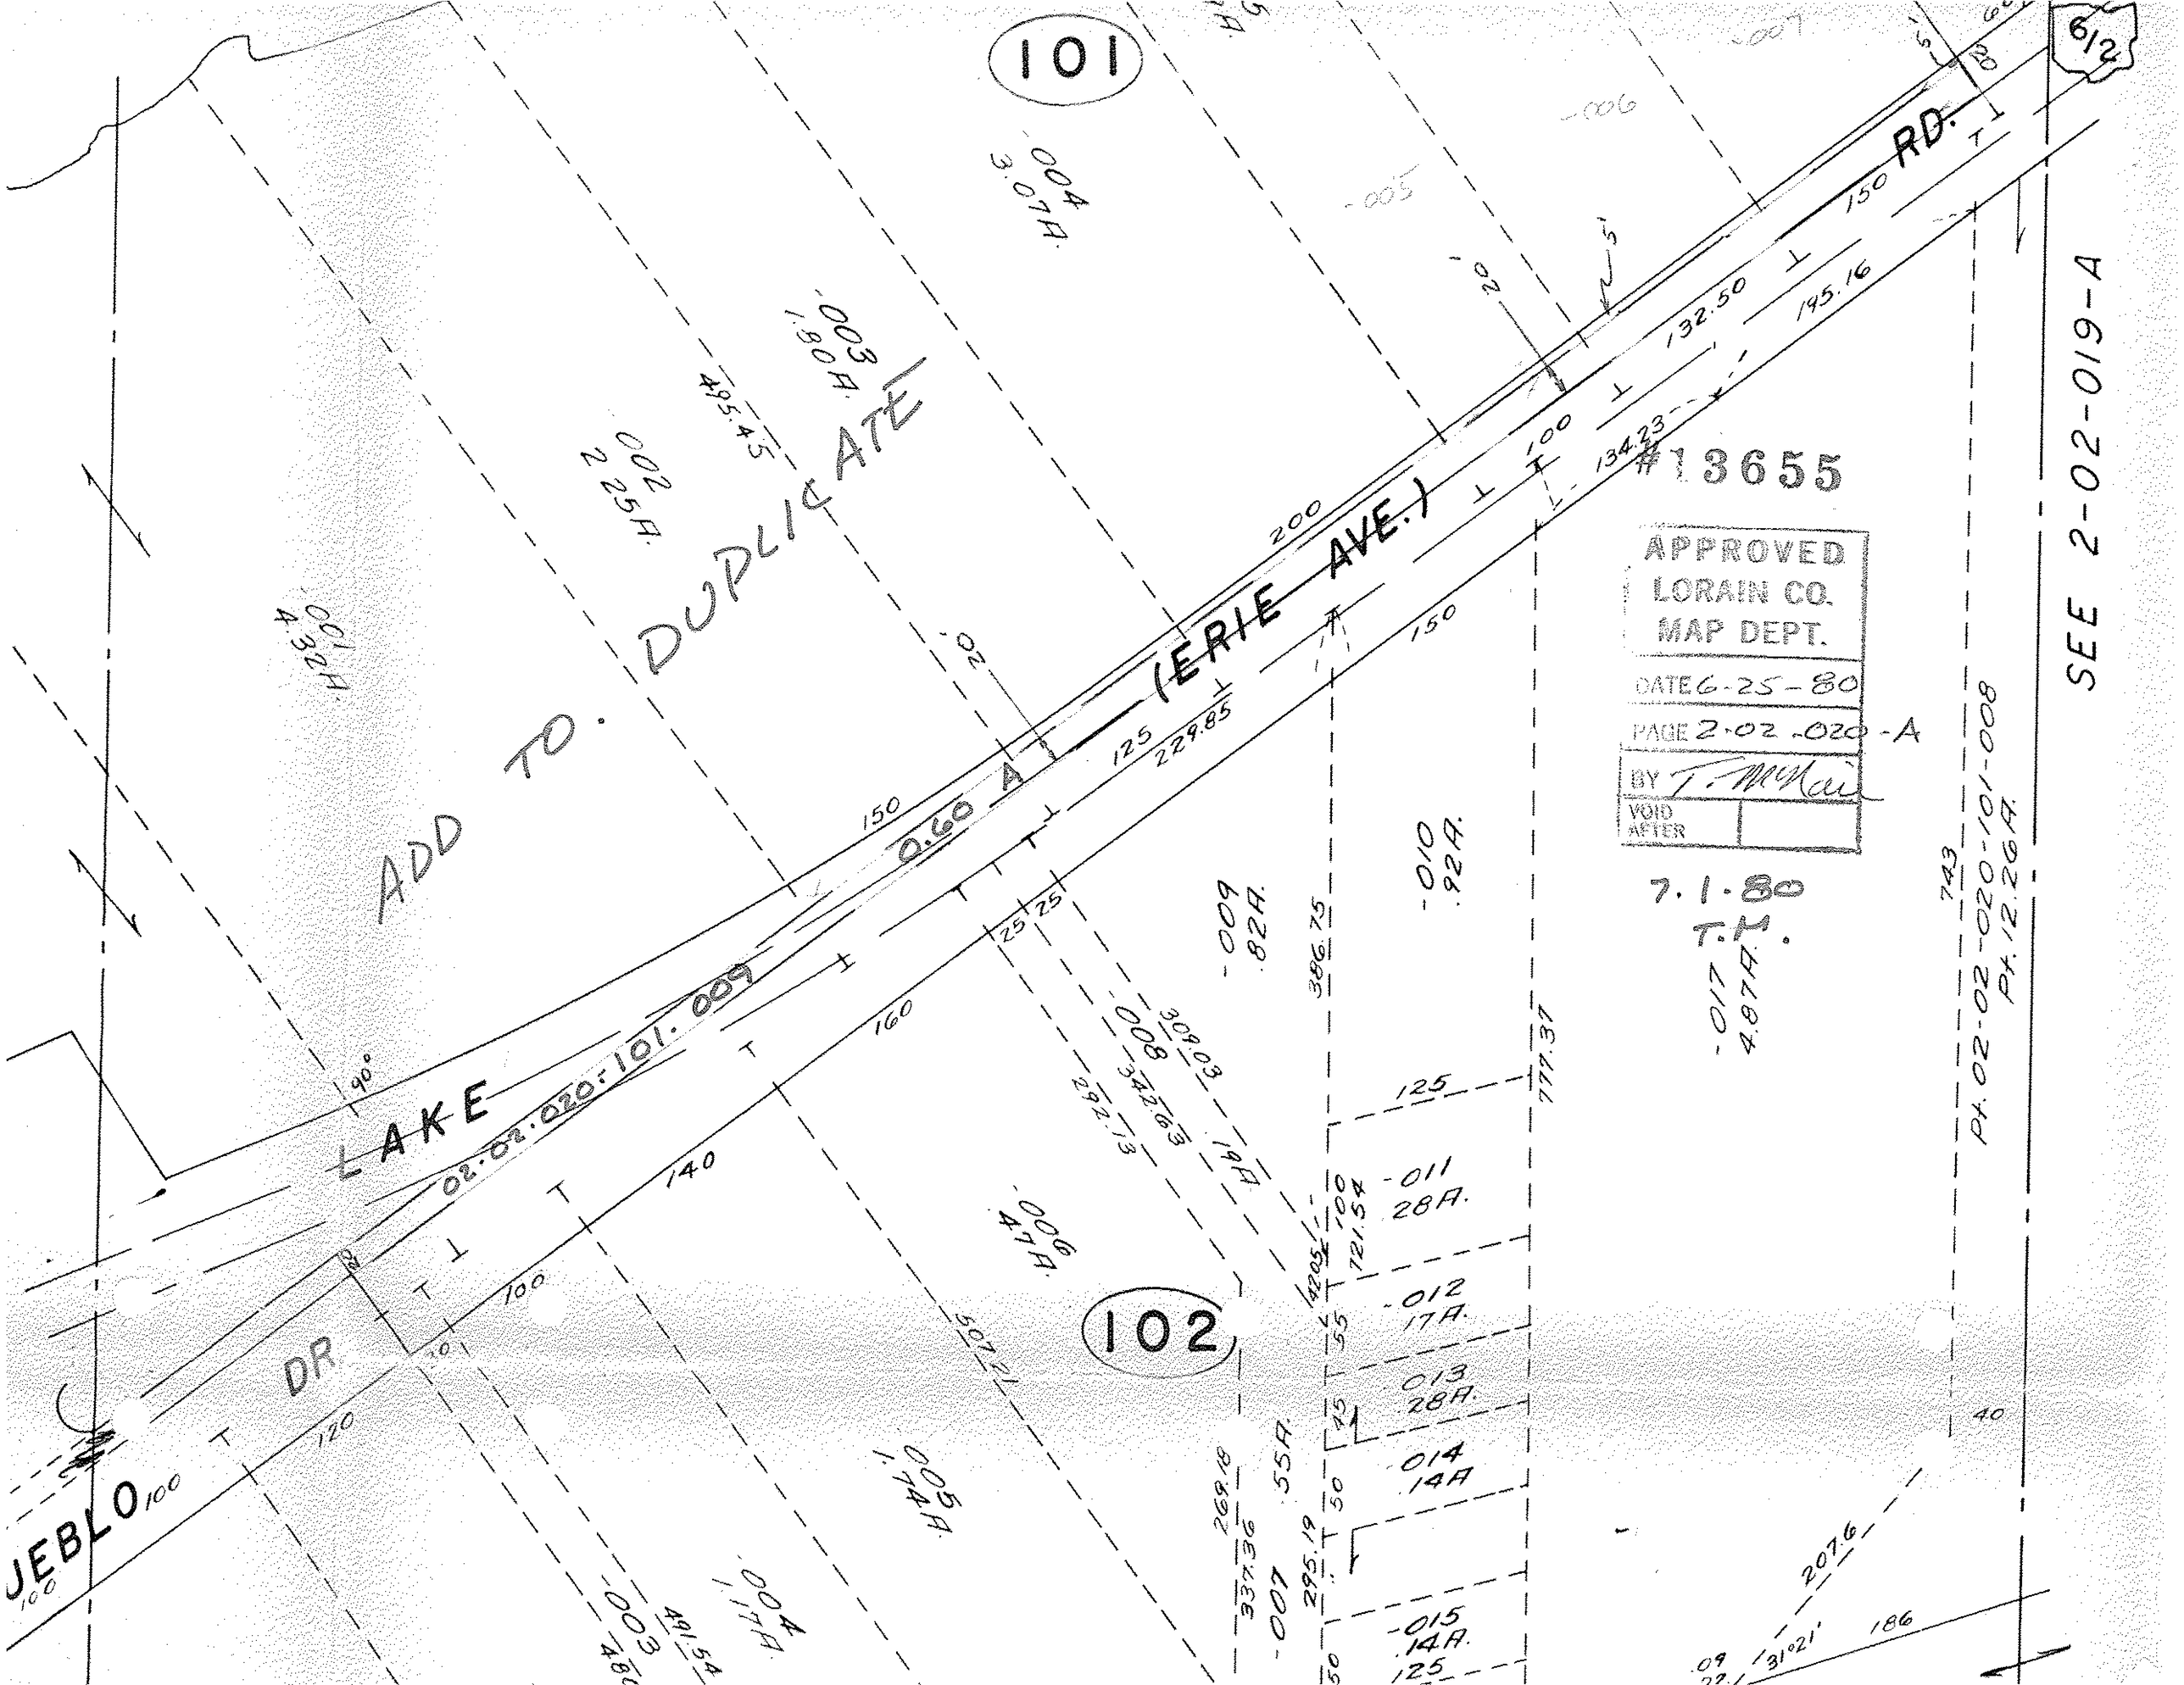

101
102
6/2
SEE 2-02-019-A
#13655
APPROVED
LORAIN CO.
MAP DEPT.
DATE 6-25-80
PAGE 2-02-020-A
BY T. McNair
VOID AFTER
7.1.80
T.M.
ADD TO. DUPLICATE
LAKE
DR
(ERIE AVE.)
RD.
JEBLO
02-02-020-101-009
0.60 A
.004 3.07A.
.003 1.80A.
.002 2.25A.
.001 4.32A.
.006 .47A.
.005 1.74A.
.004 1.17A.
.003
.009 .82A.
.010 .92A.
.017 4.87A.
.011 28A.
.012 17A.
.013 28A.
.014 14A
.015 14A.
.007 55A.
.008 19A.
Pt. 02-02-020-101-008
Pt. 12.26A.