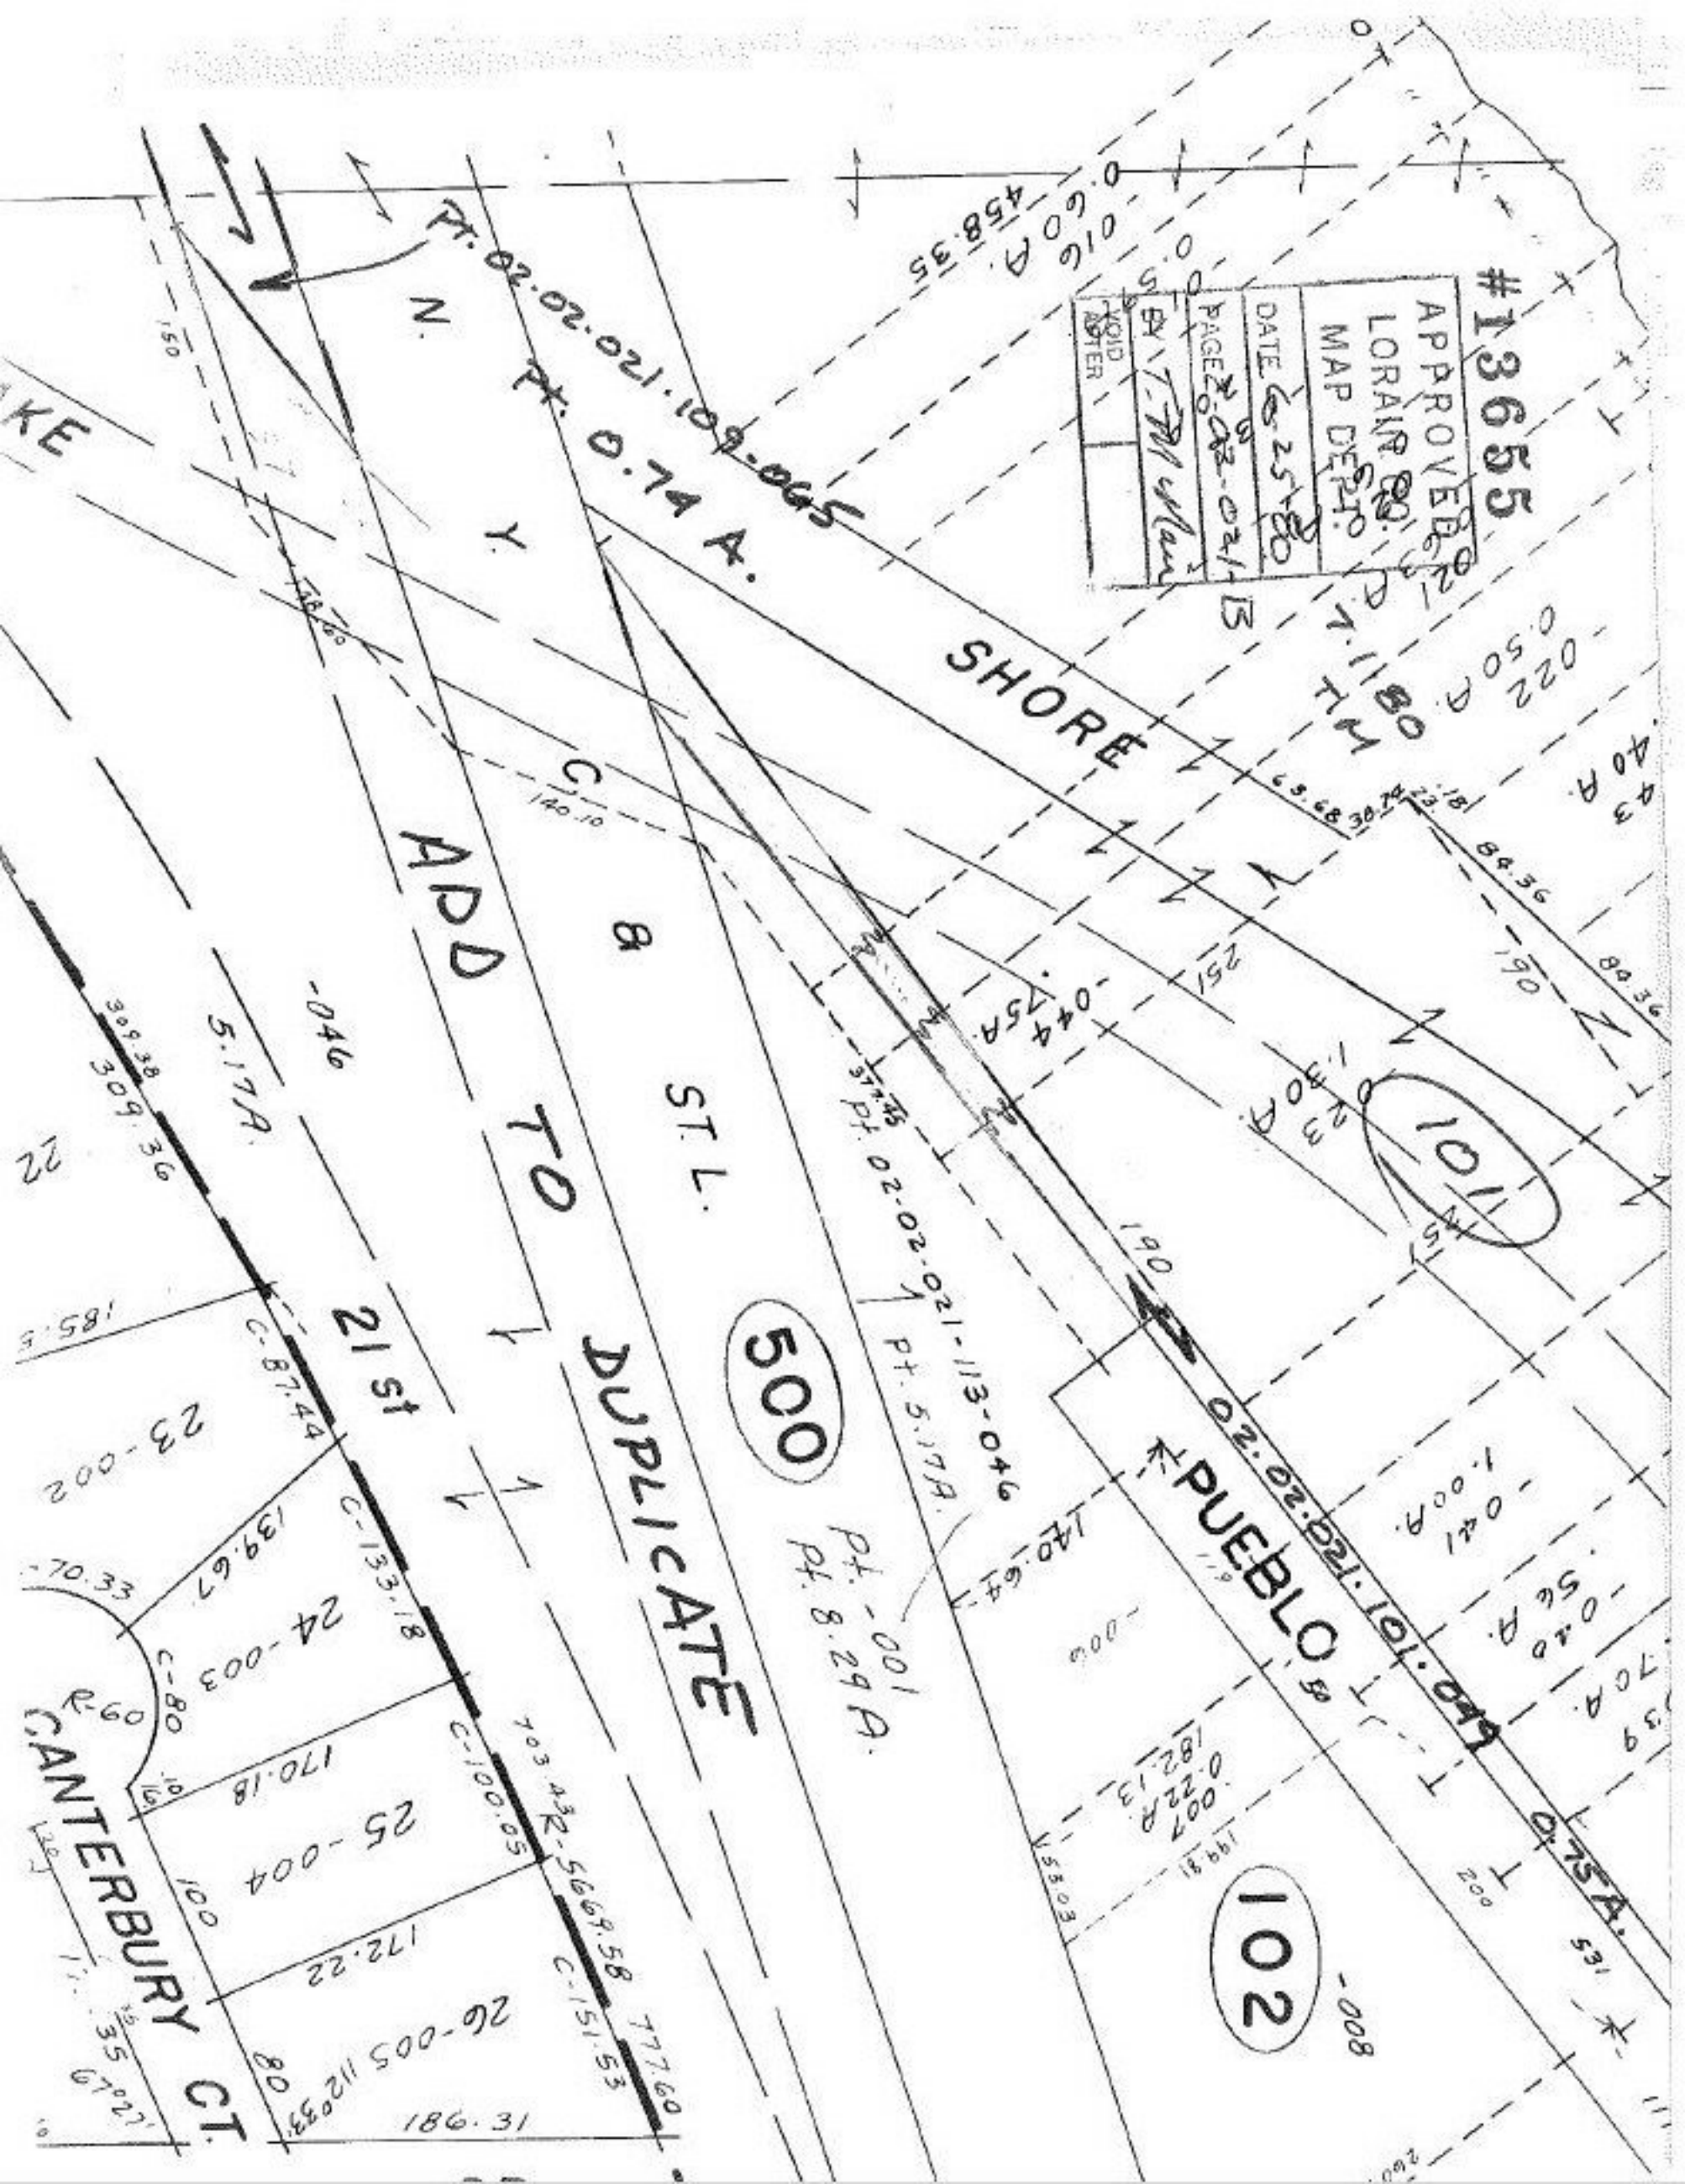

#13655
APPROVED
LORAIN CO.
MAP DEPT.
DATE 6-25-80
PAGE 2-02-021-13
BY T. McMain
VOID AFTER
SHORE
ST. L.
ADD
TO
DUPLICATE
21 st
PUEBLO
CANTERBURY CT.
500
102
101
Pt. 02-02-021-109-065
Pt. 0.74 A.
Pt. 02-02-021-113-046
Pt. 5.17A.
Pt. -001
Pt. 8.29 A.
02-02-021-101-049
0.75 A.