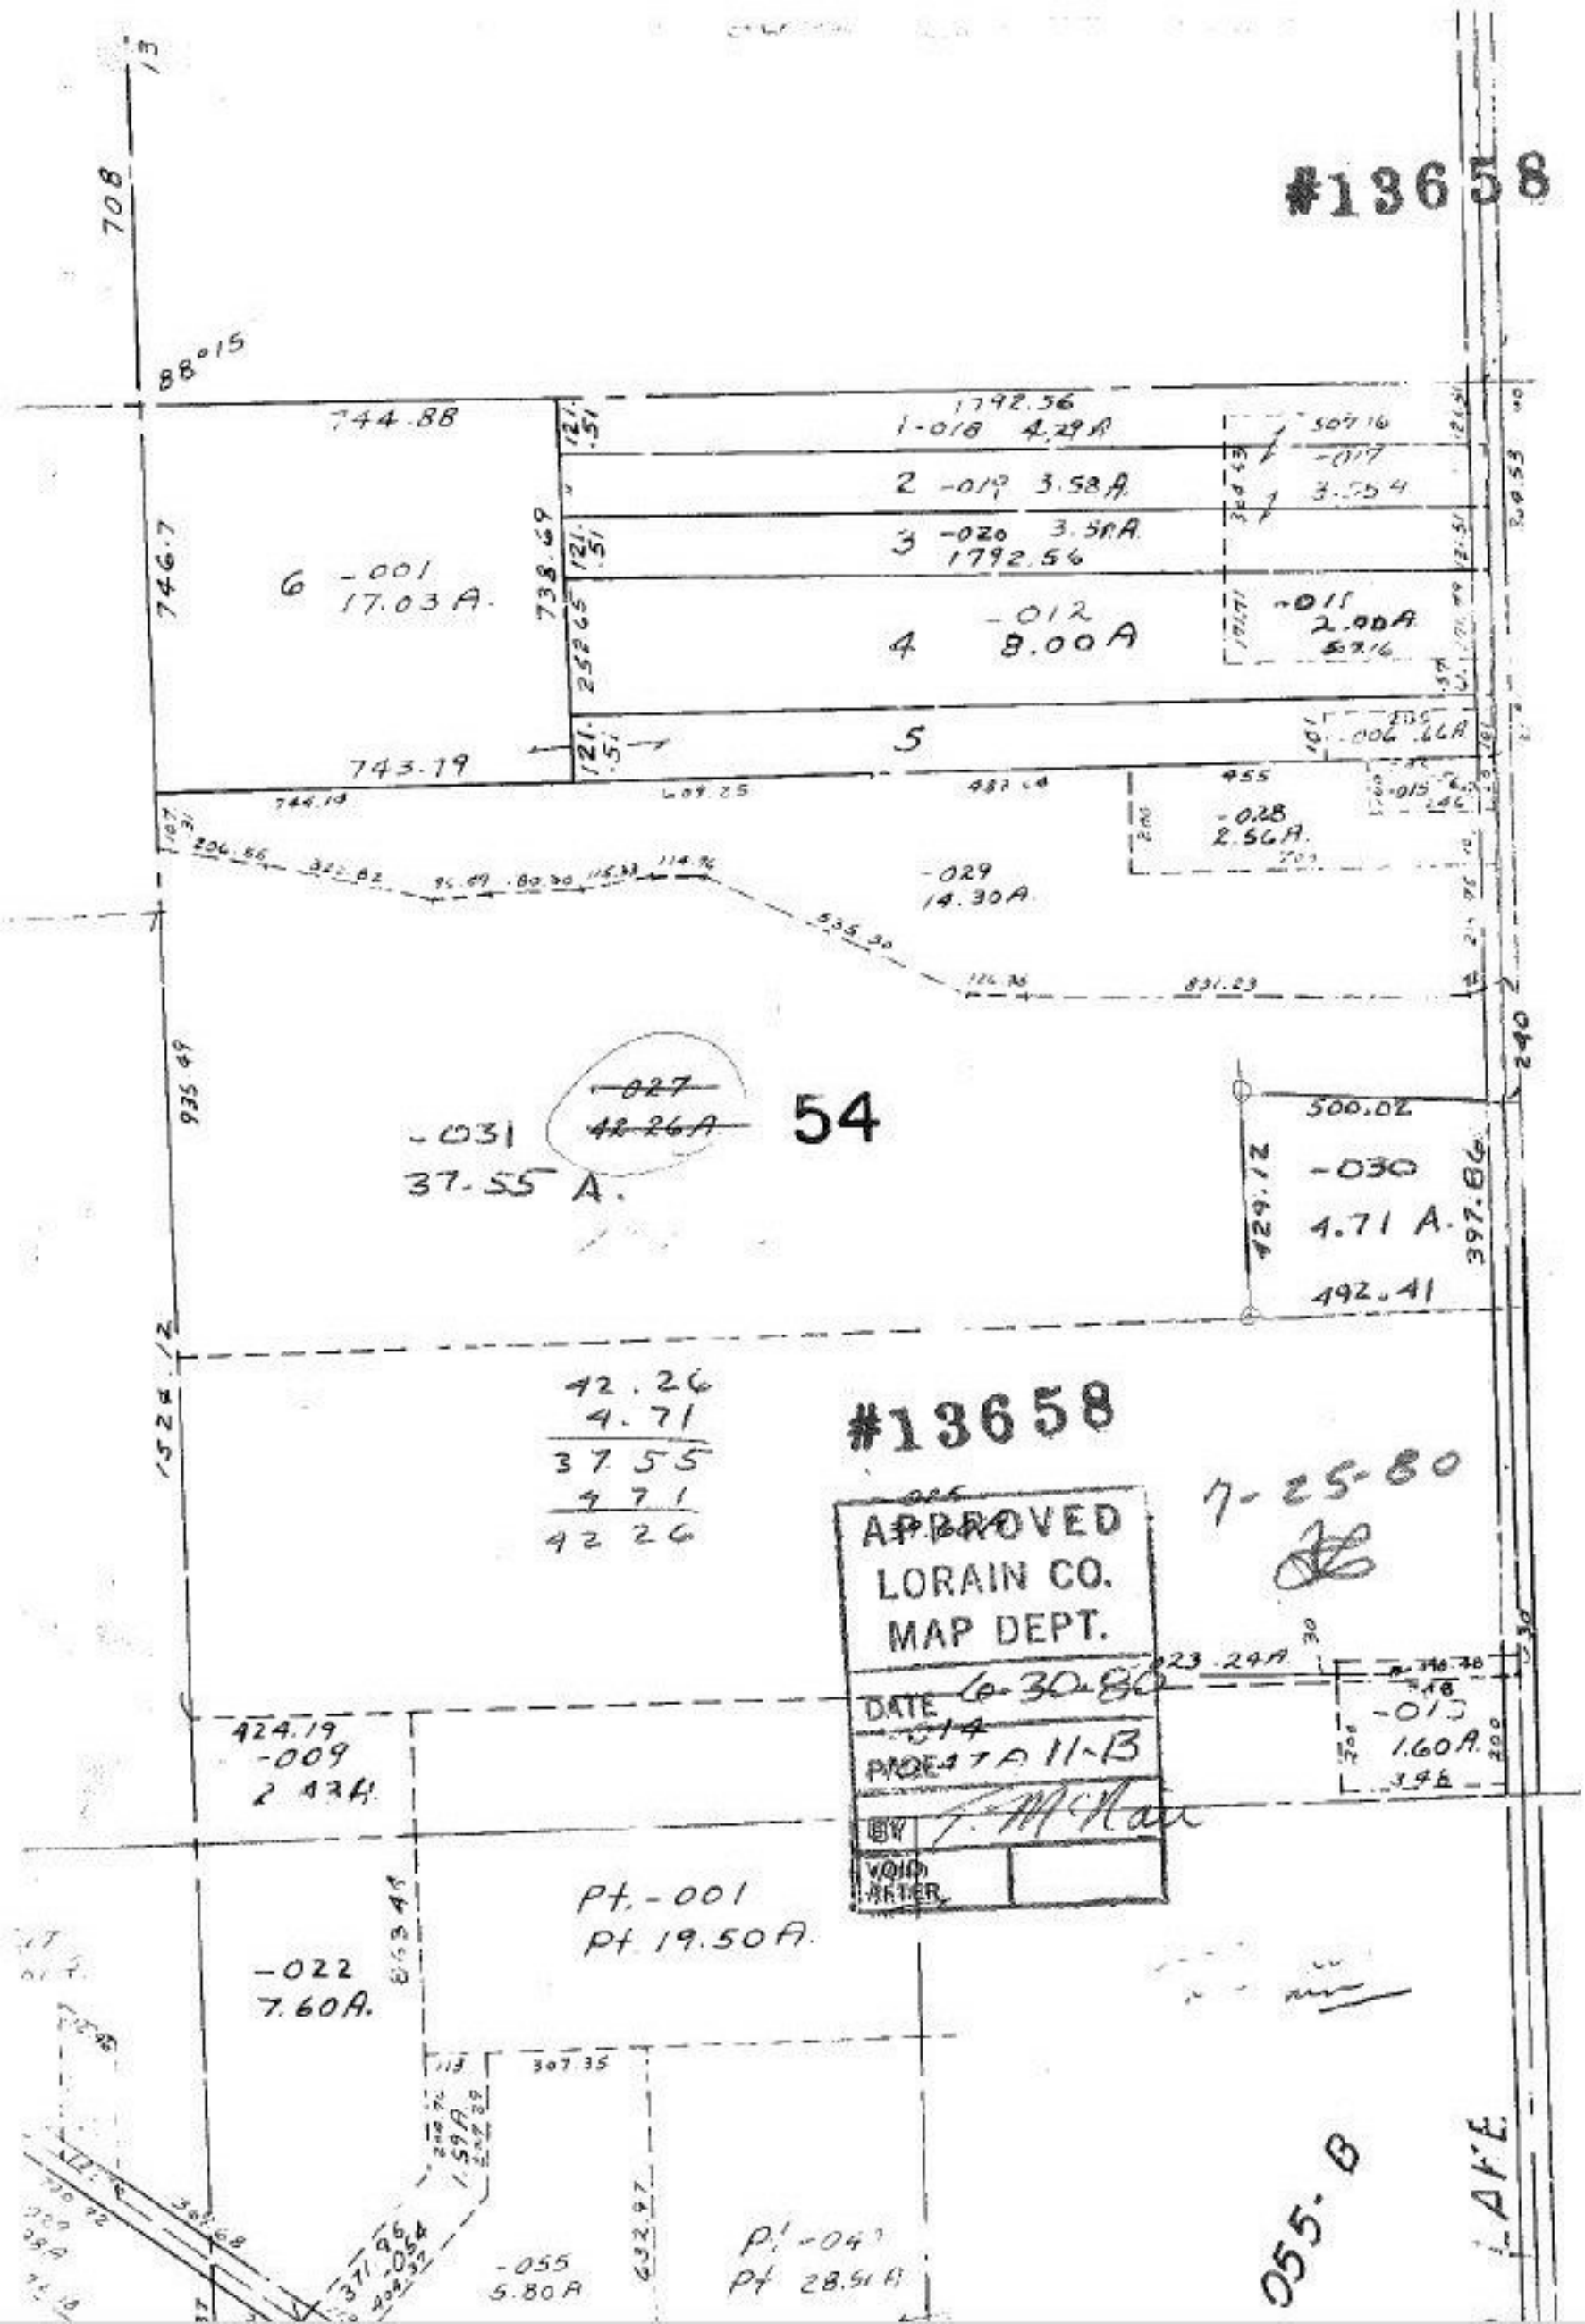
#13658
708
88°15
744.88
1792.56
1-018 4.29A
2 -019 3.58A
3 -020 3.58A
1792.56
6 -001
17.03A.
746.7
738.69
-012
4 8.00A
-015
2.00A
5
743.79
-028
2.56A.
-029
14.30A.
-027
42.26A
54
-031
37.55 A.
500.02
-030
4.71 A.
492.41
397.86
429.12
240
935.49
1524.12
42.26
4.71
37.55
4.71
42.26
#13658
7-25-80
APPROVED
LORAIN CO.
MAP DEPT.
DATE 6-30-80
PAGE 11-B
BY
VOID AFTER
-013
1.60A.
424.19
-009
2.43A.
Pt.-001
Pt 19.50A.
-022
7.60A.
307.35
-055
5.80A
Pt -047
Pt 28.51A
055-B
AVE.