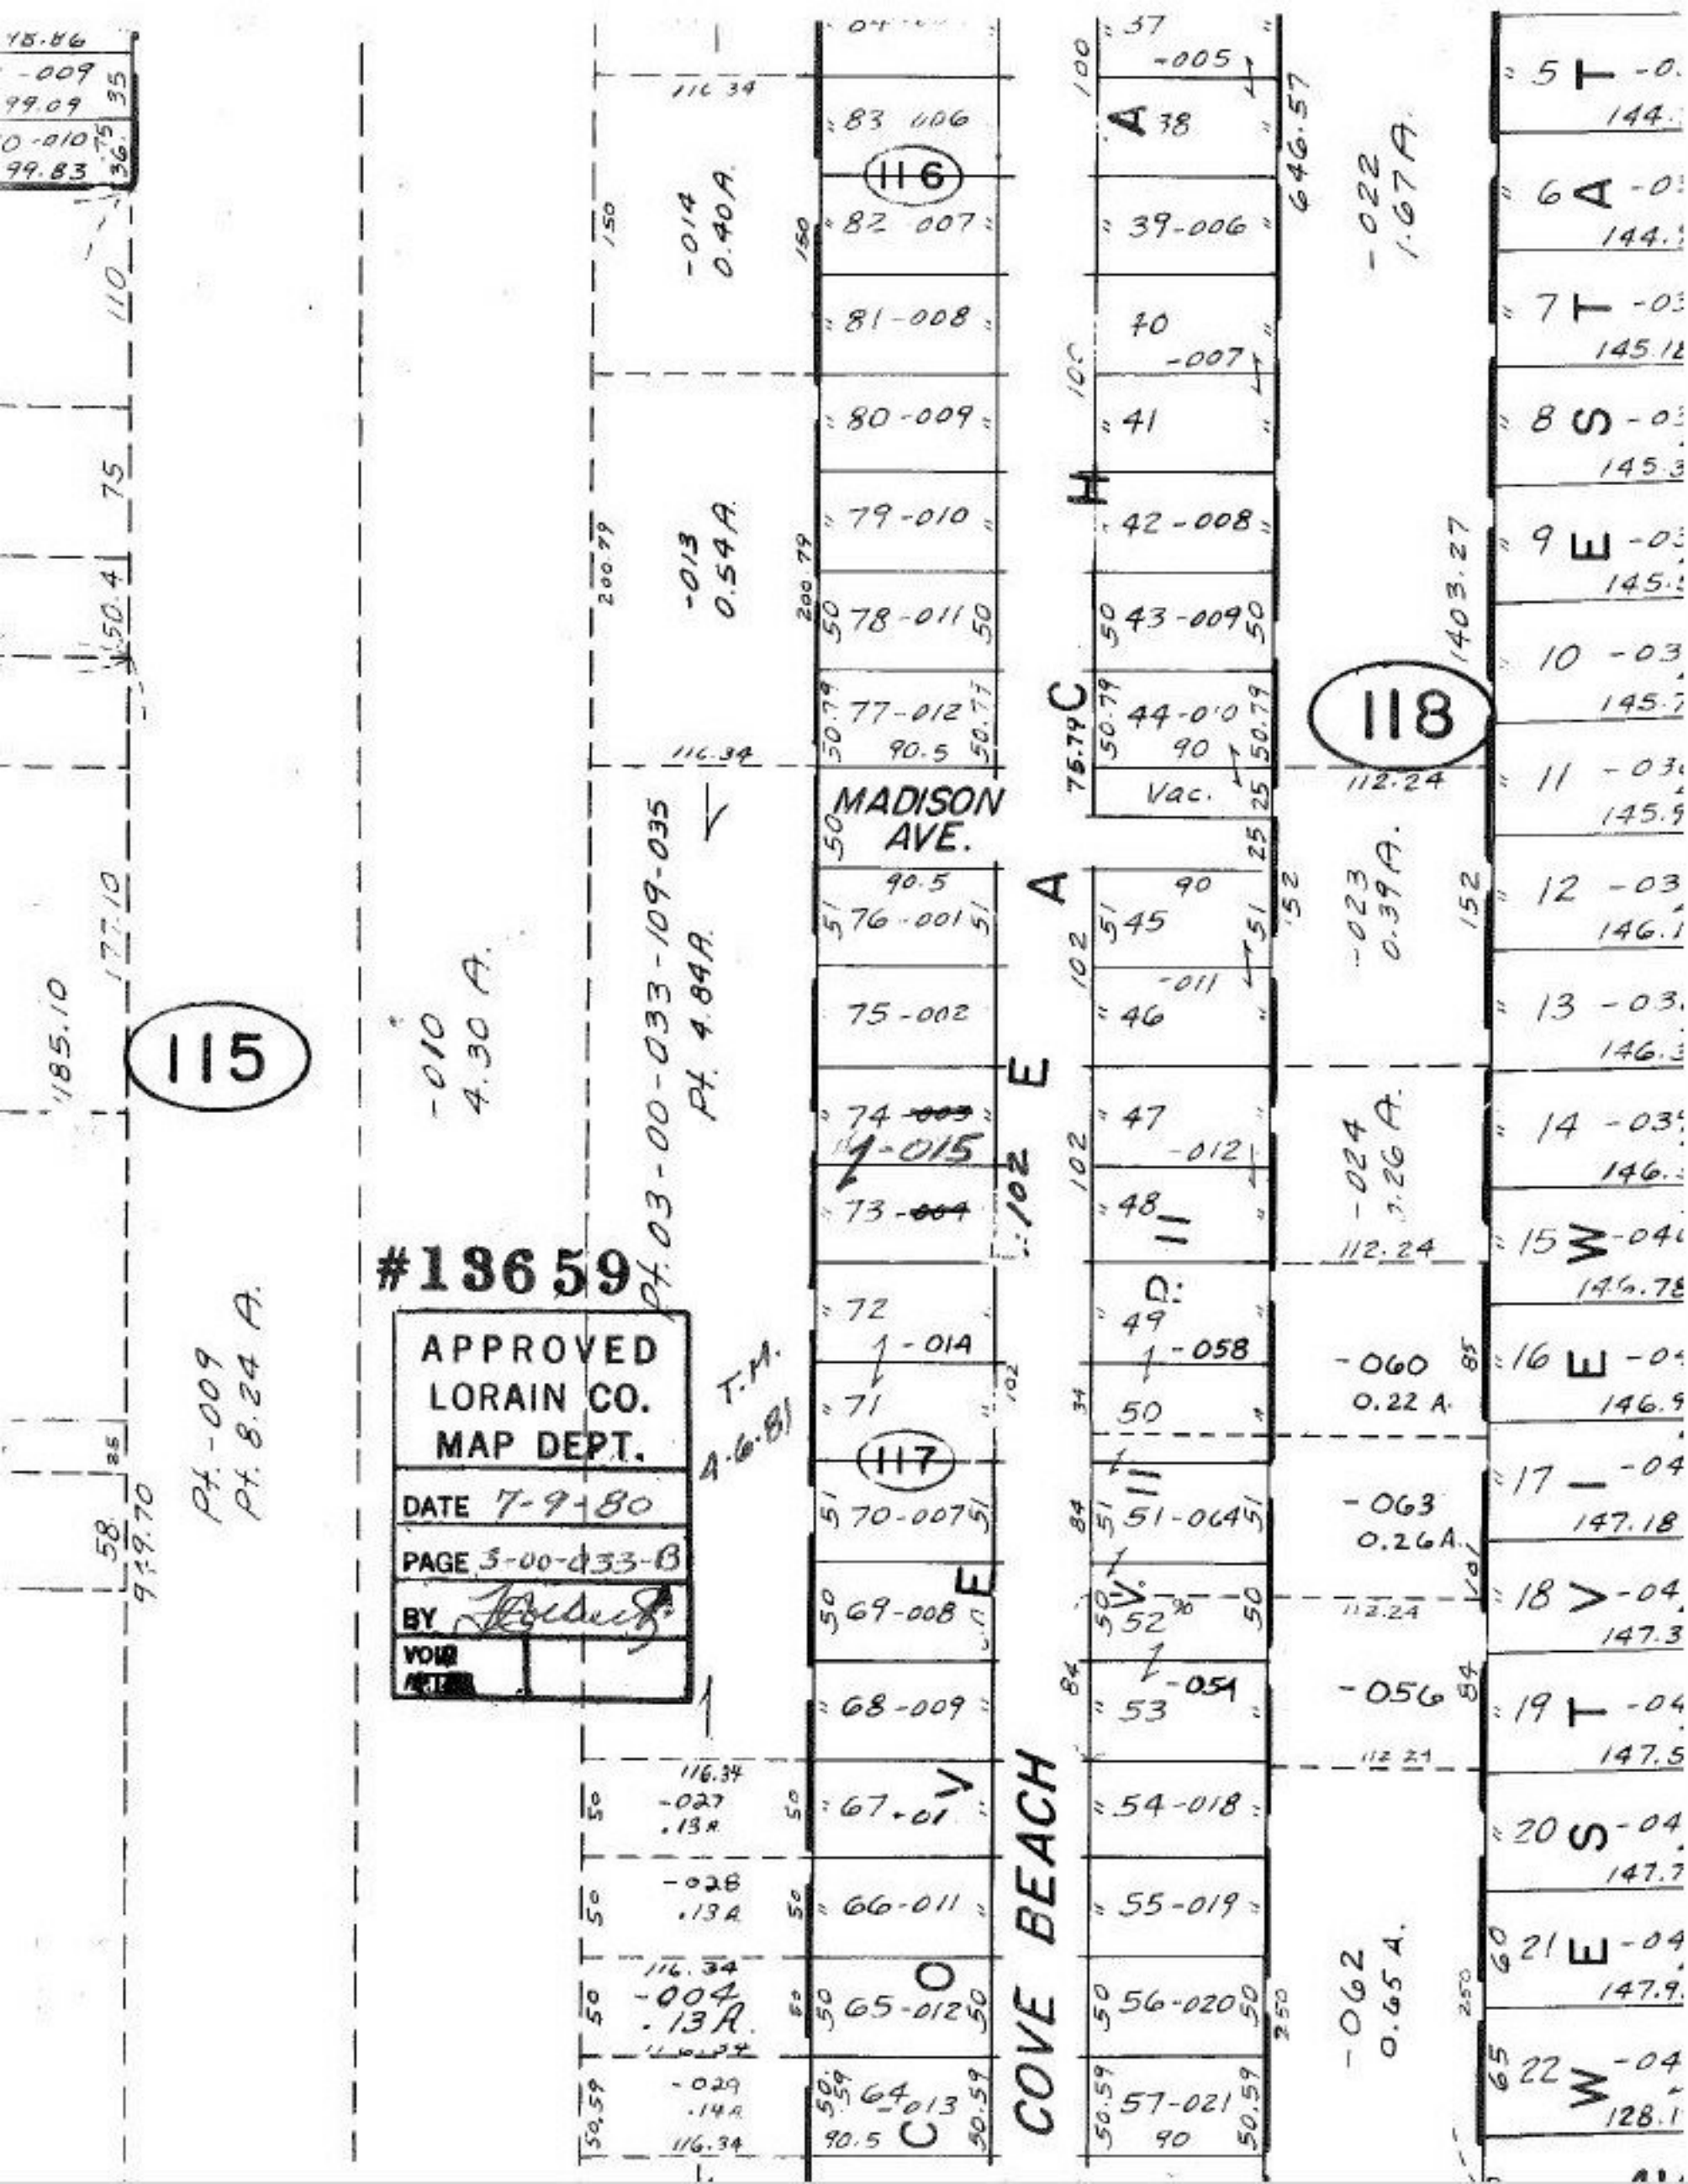

#13659
APPROVED
LORAIN CO.
MAP DEPT.
DATE 7-9-80
PAGE 3-00-033-B
BY
VOID
115
116
117
118
MADISON AVE.
COVE BEACH
Pt. 03-00-033-109-035
Pt. 4.84A.
-010
4.30 A.
Pt. -009
Pt. 8.24 A.
T.M.
4-6-81
-014
0.40A.
-013
0.54A.
-022
1.67A.
-023
0.39A.
-024
3.26 A.
-060
0.22 A.
-063
0.26A.
-056
-062
0.65 A.
-027
.13A
-028
.13A
-004
.13A.
-029
.14A