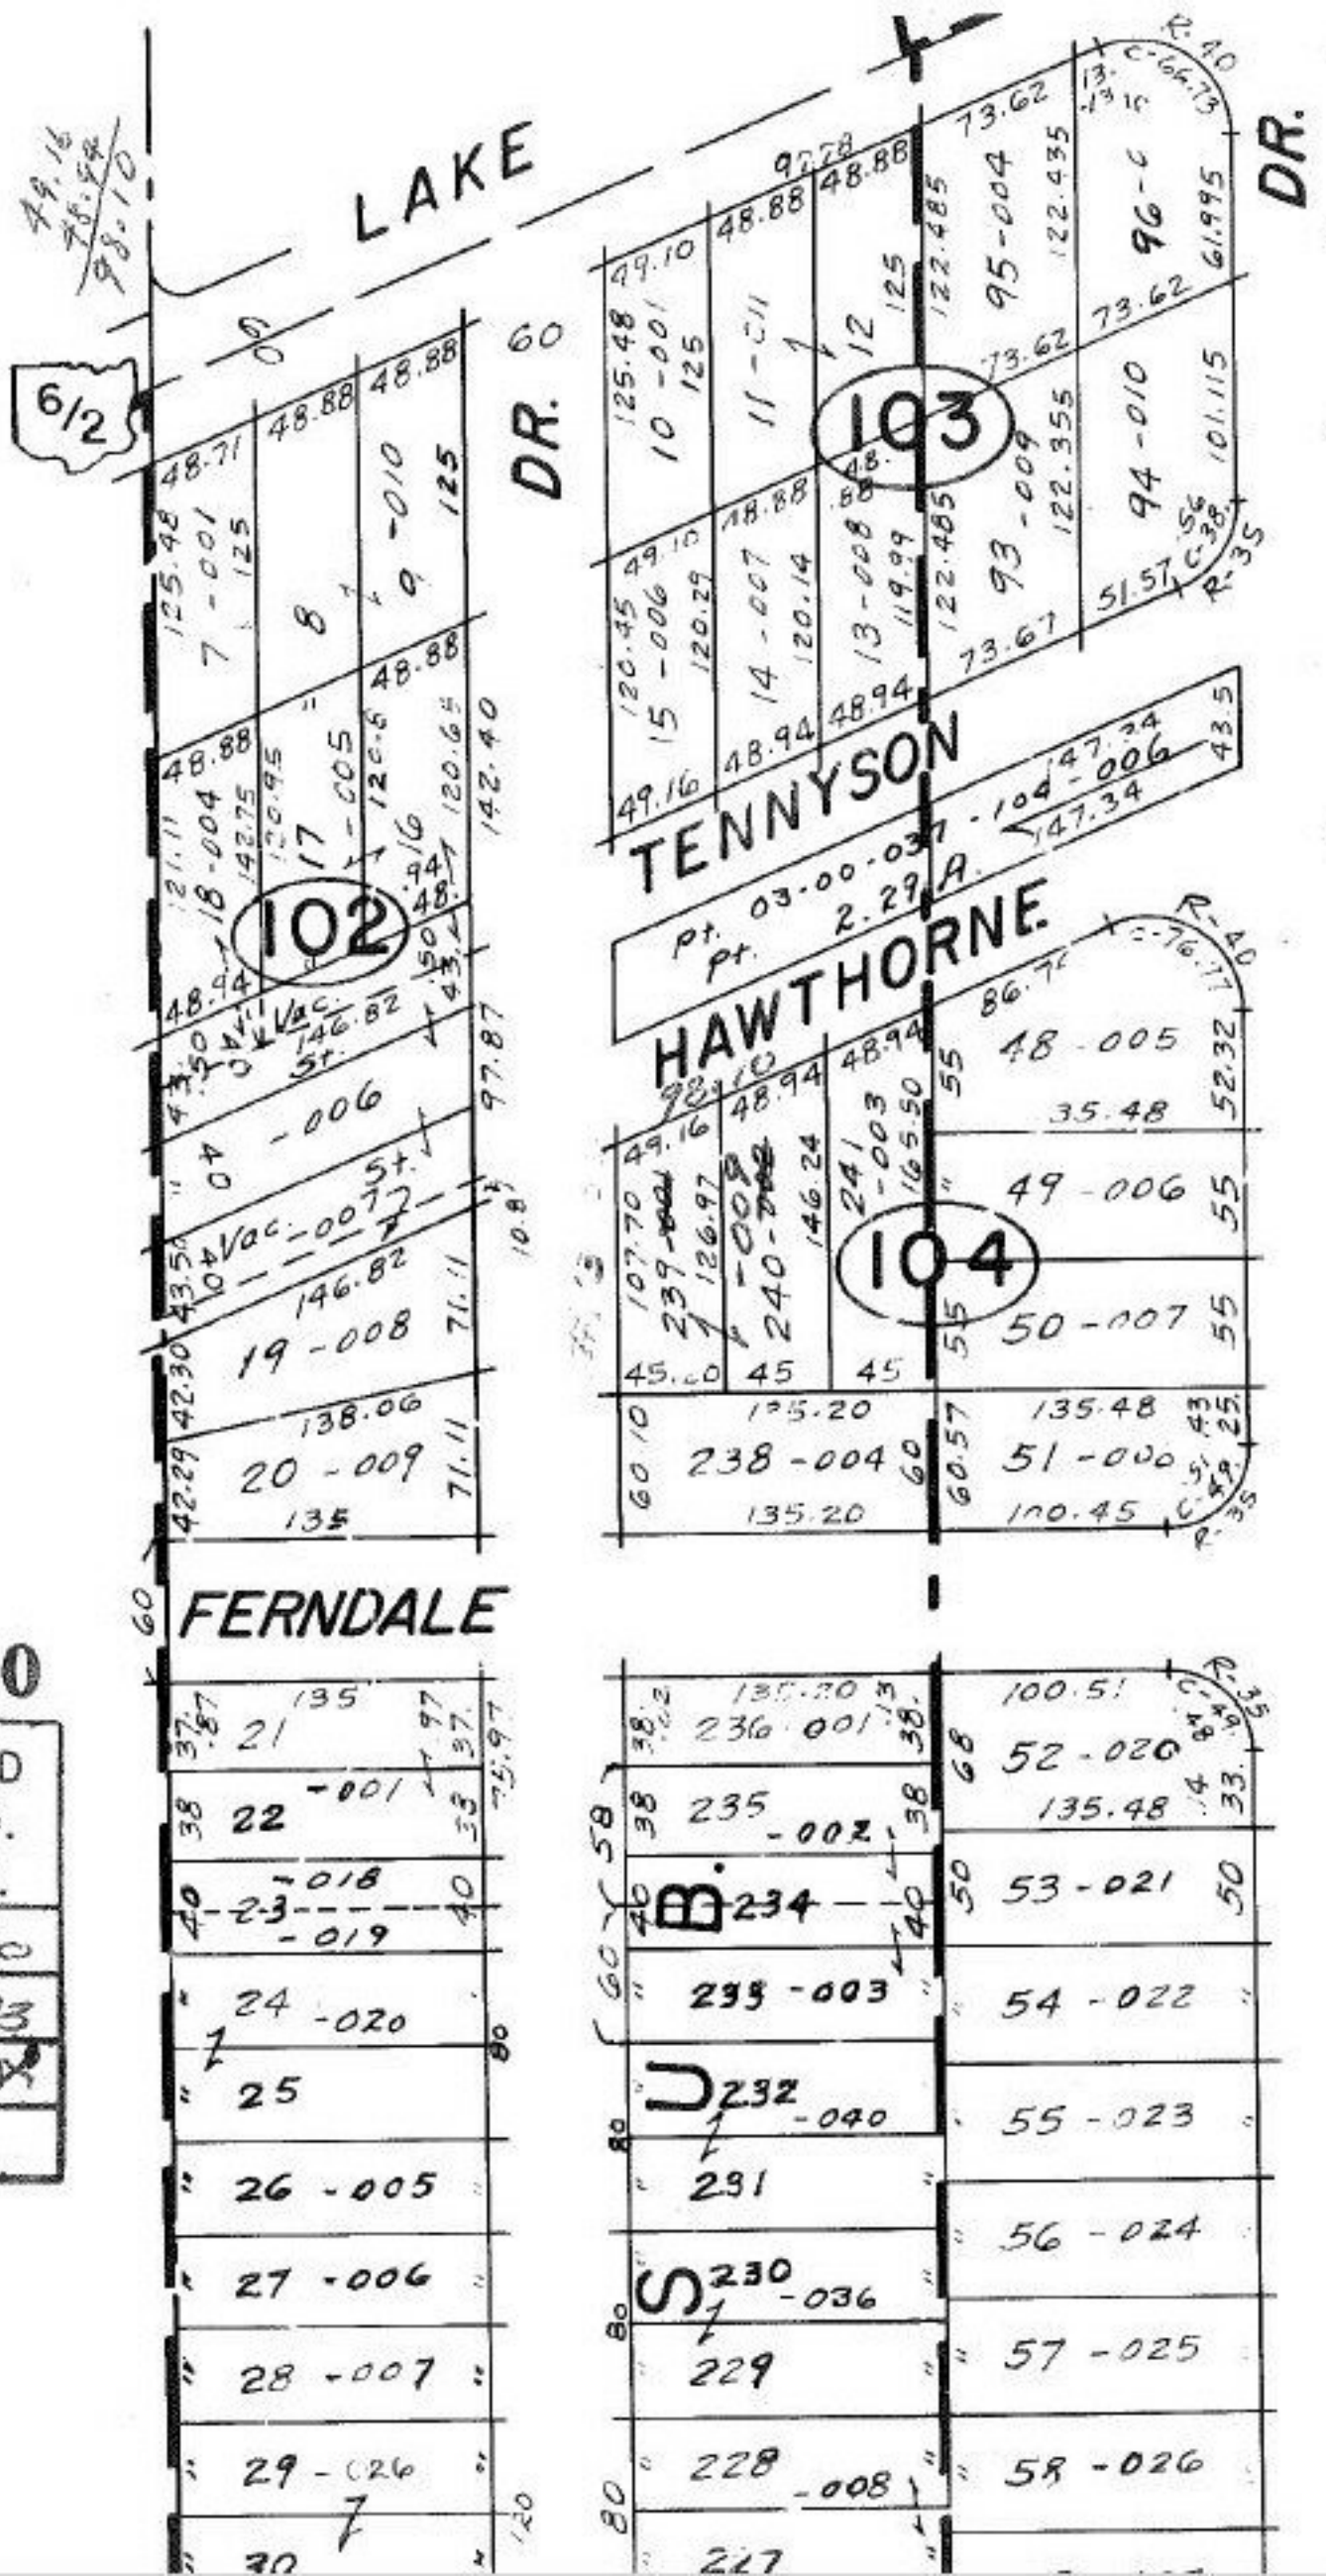

#13660

APPROVED
LORAIN CO.
MAP DEPT.
DATE 4-9-80
PAGE 3-00-043
BY J. Collins
YOUR FILE

T.M.
1-B-81