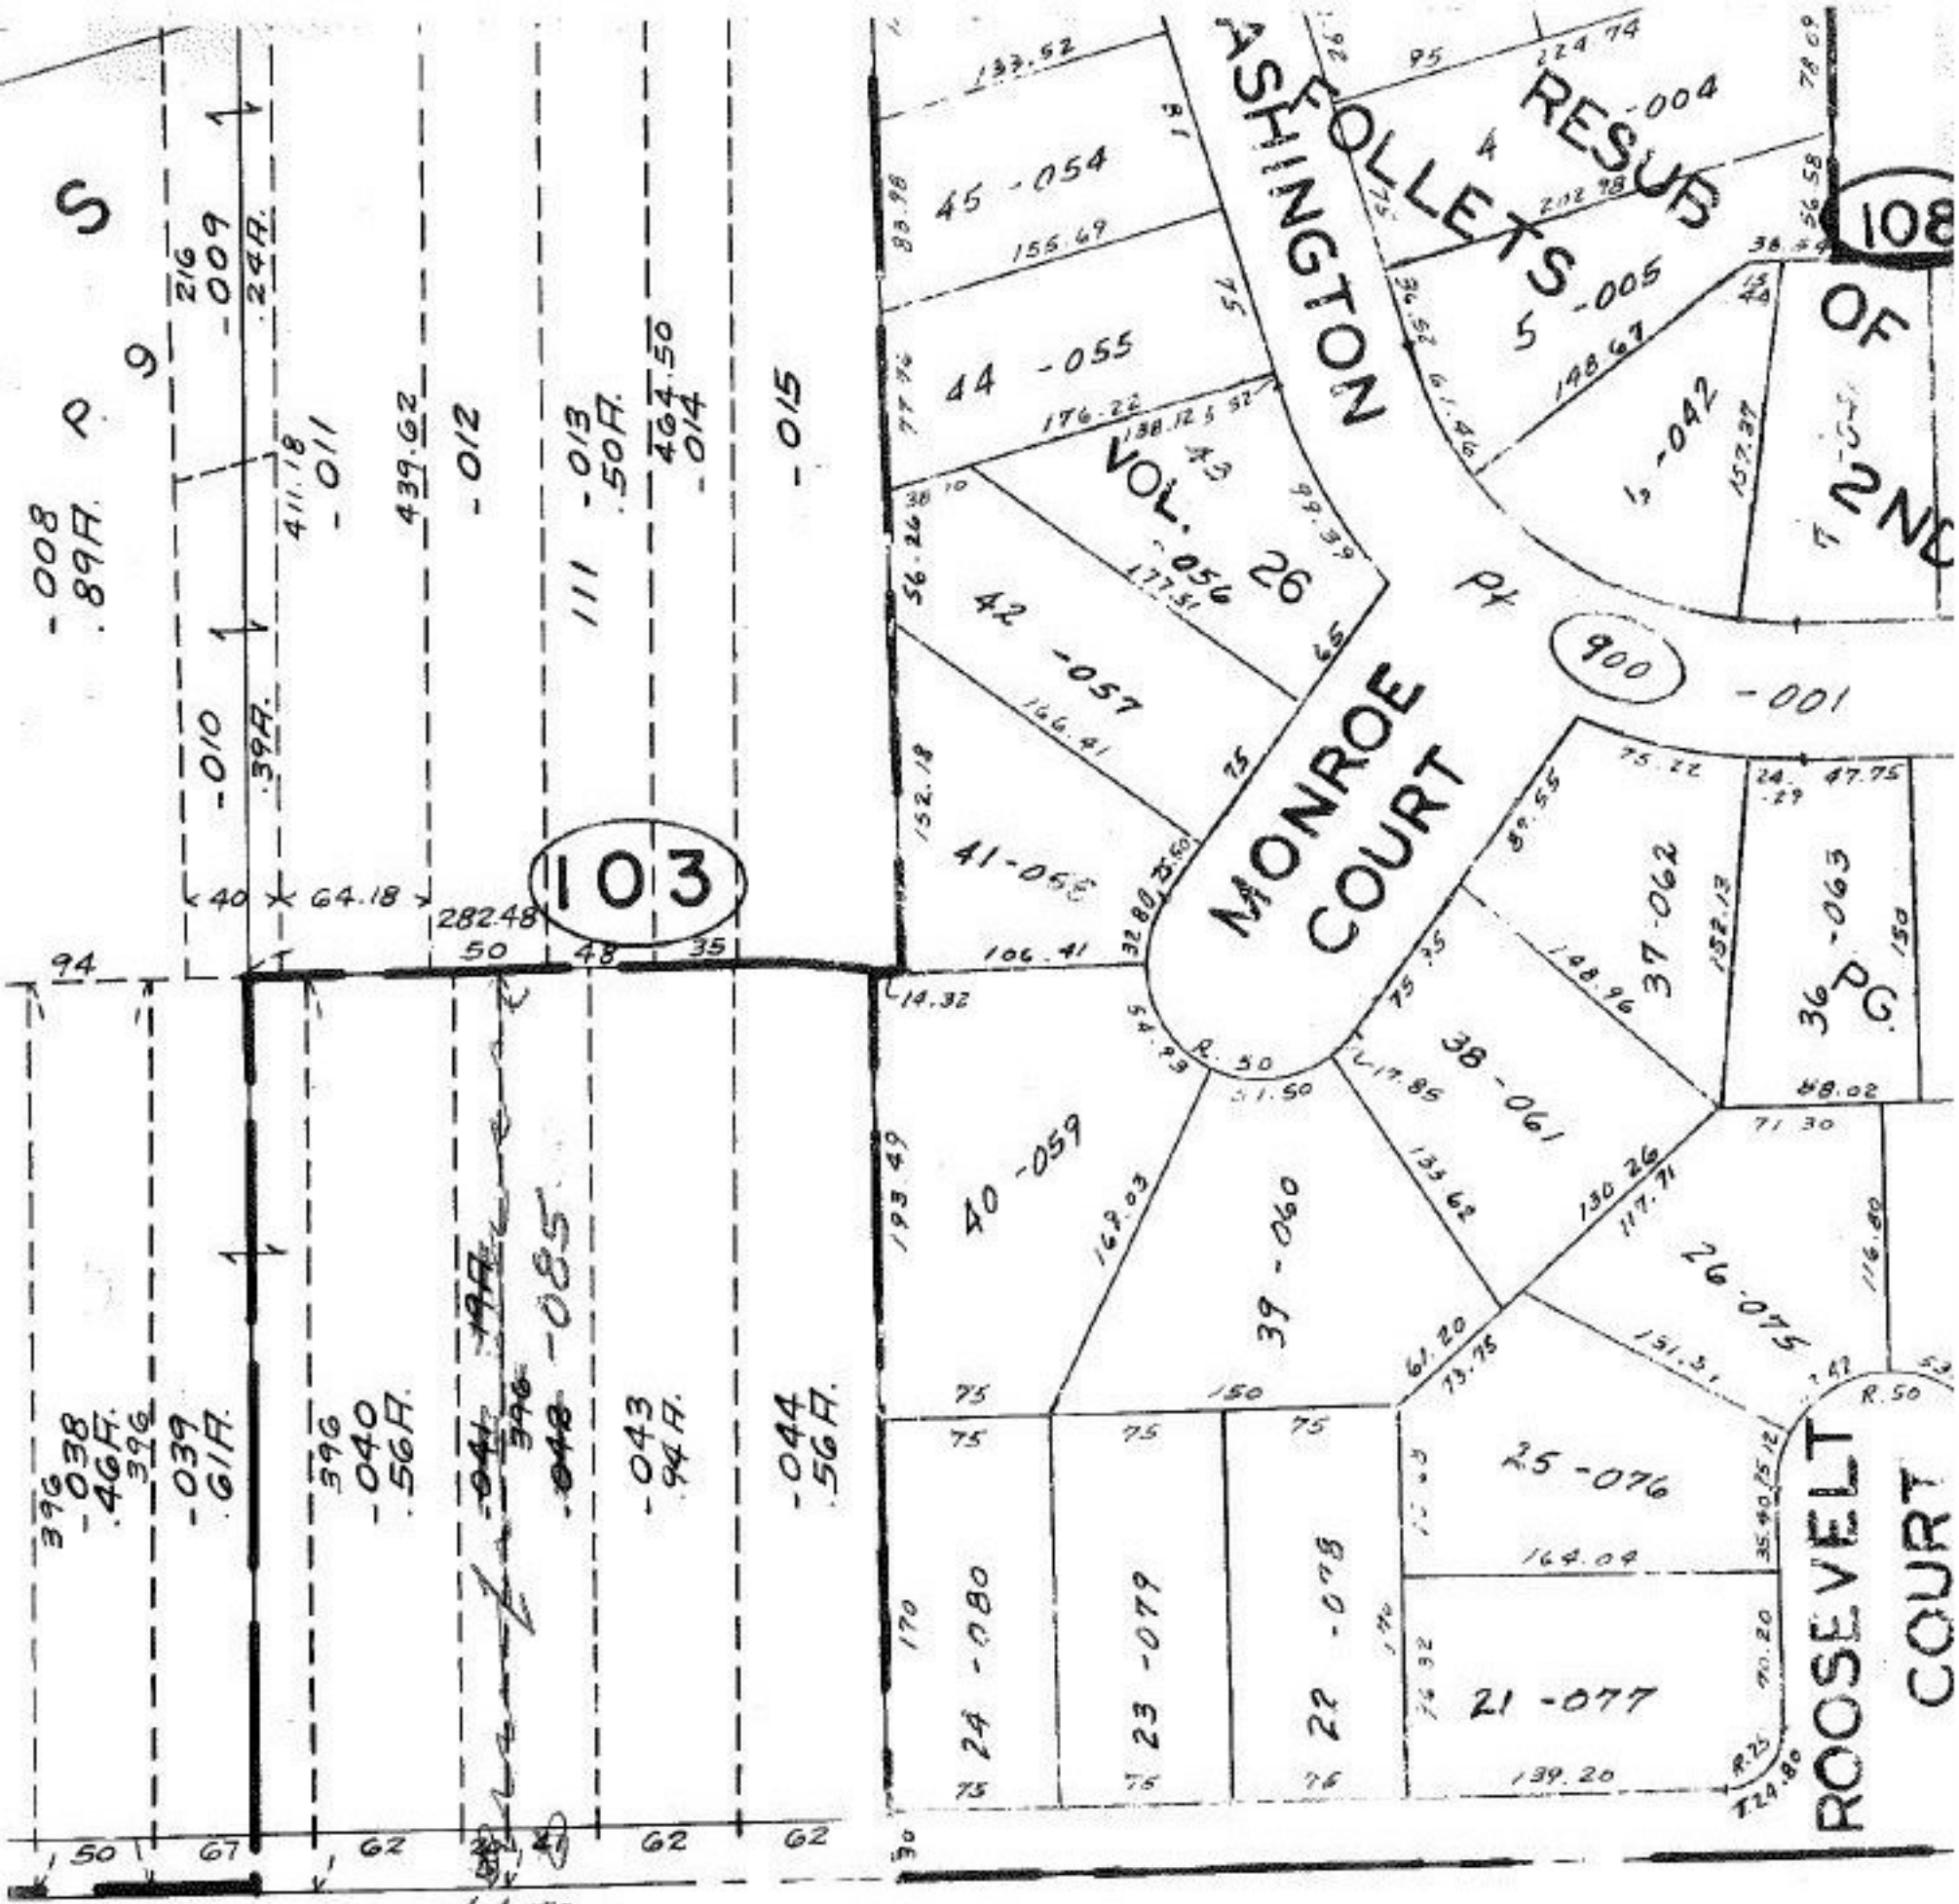

SEE 9-00-105-A

#13660

APPROVED LORAIN CO. MAP DEPT.
DATE 7-9-80
PAGE 9-00-095A
BY
ROAD METER

T.M.
7-23-80

A TWP.

W PT. LO