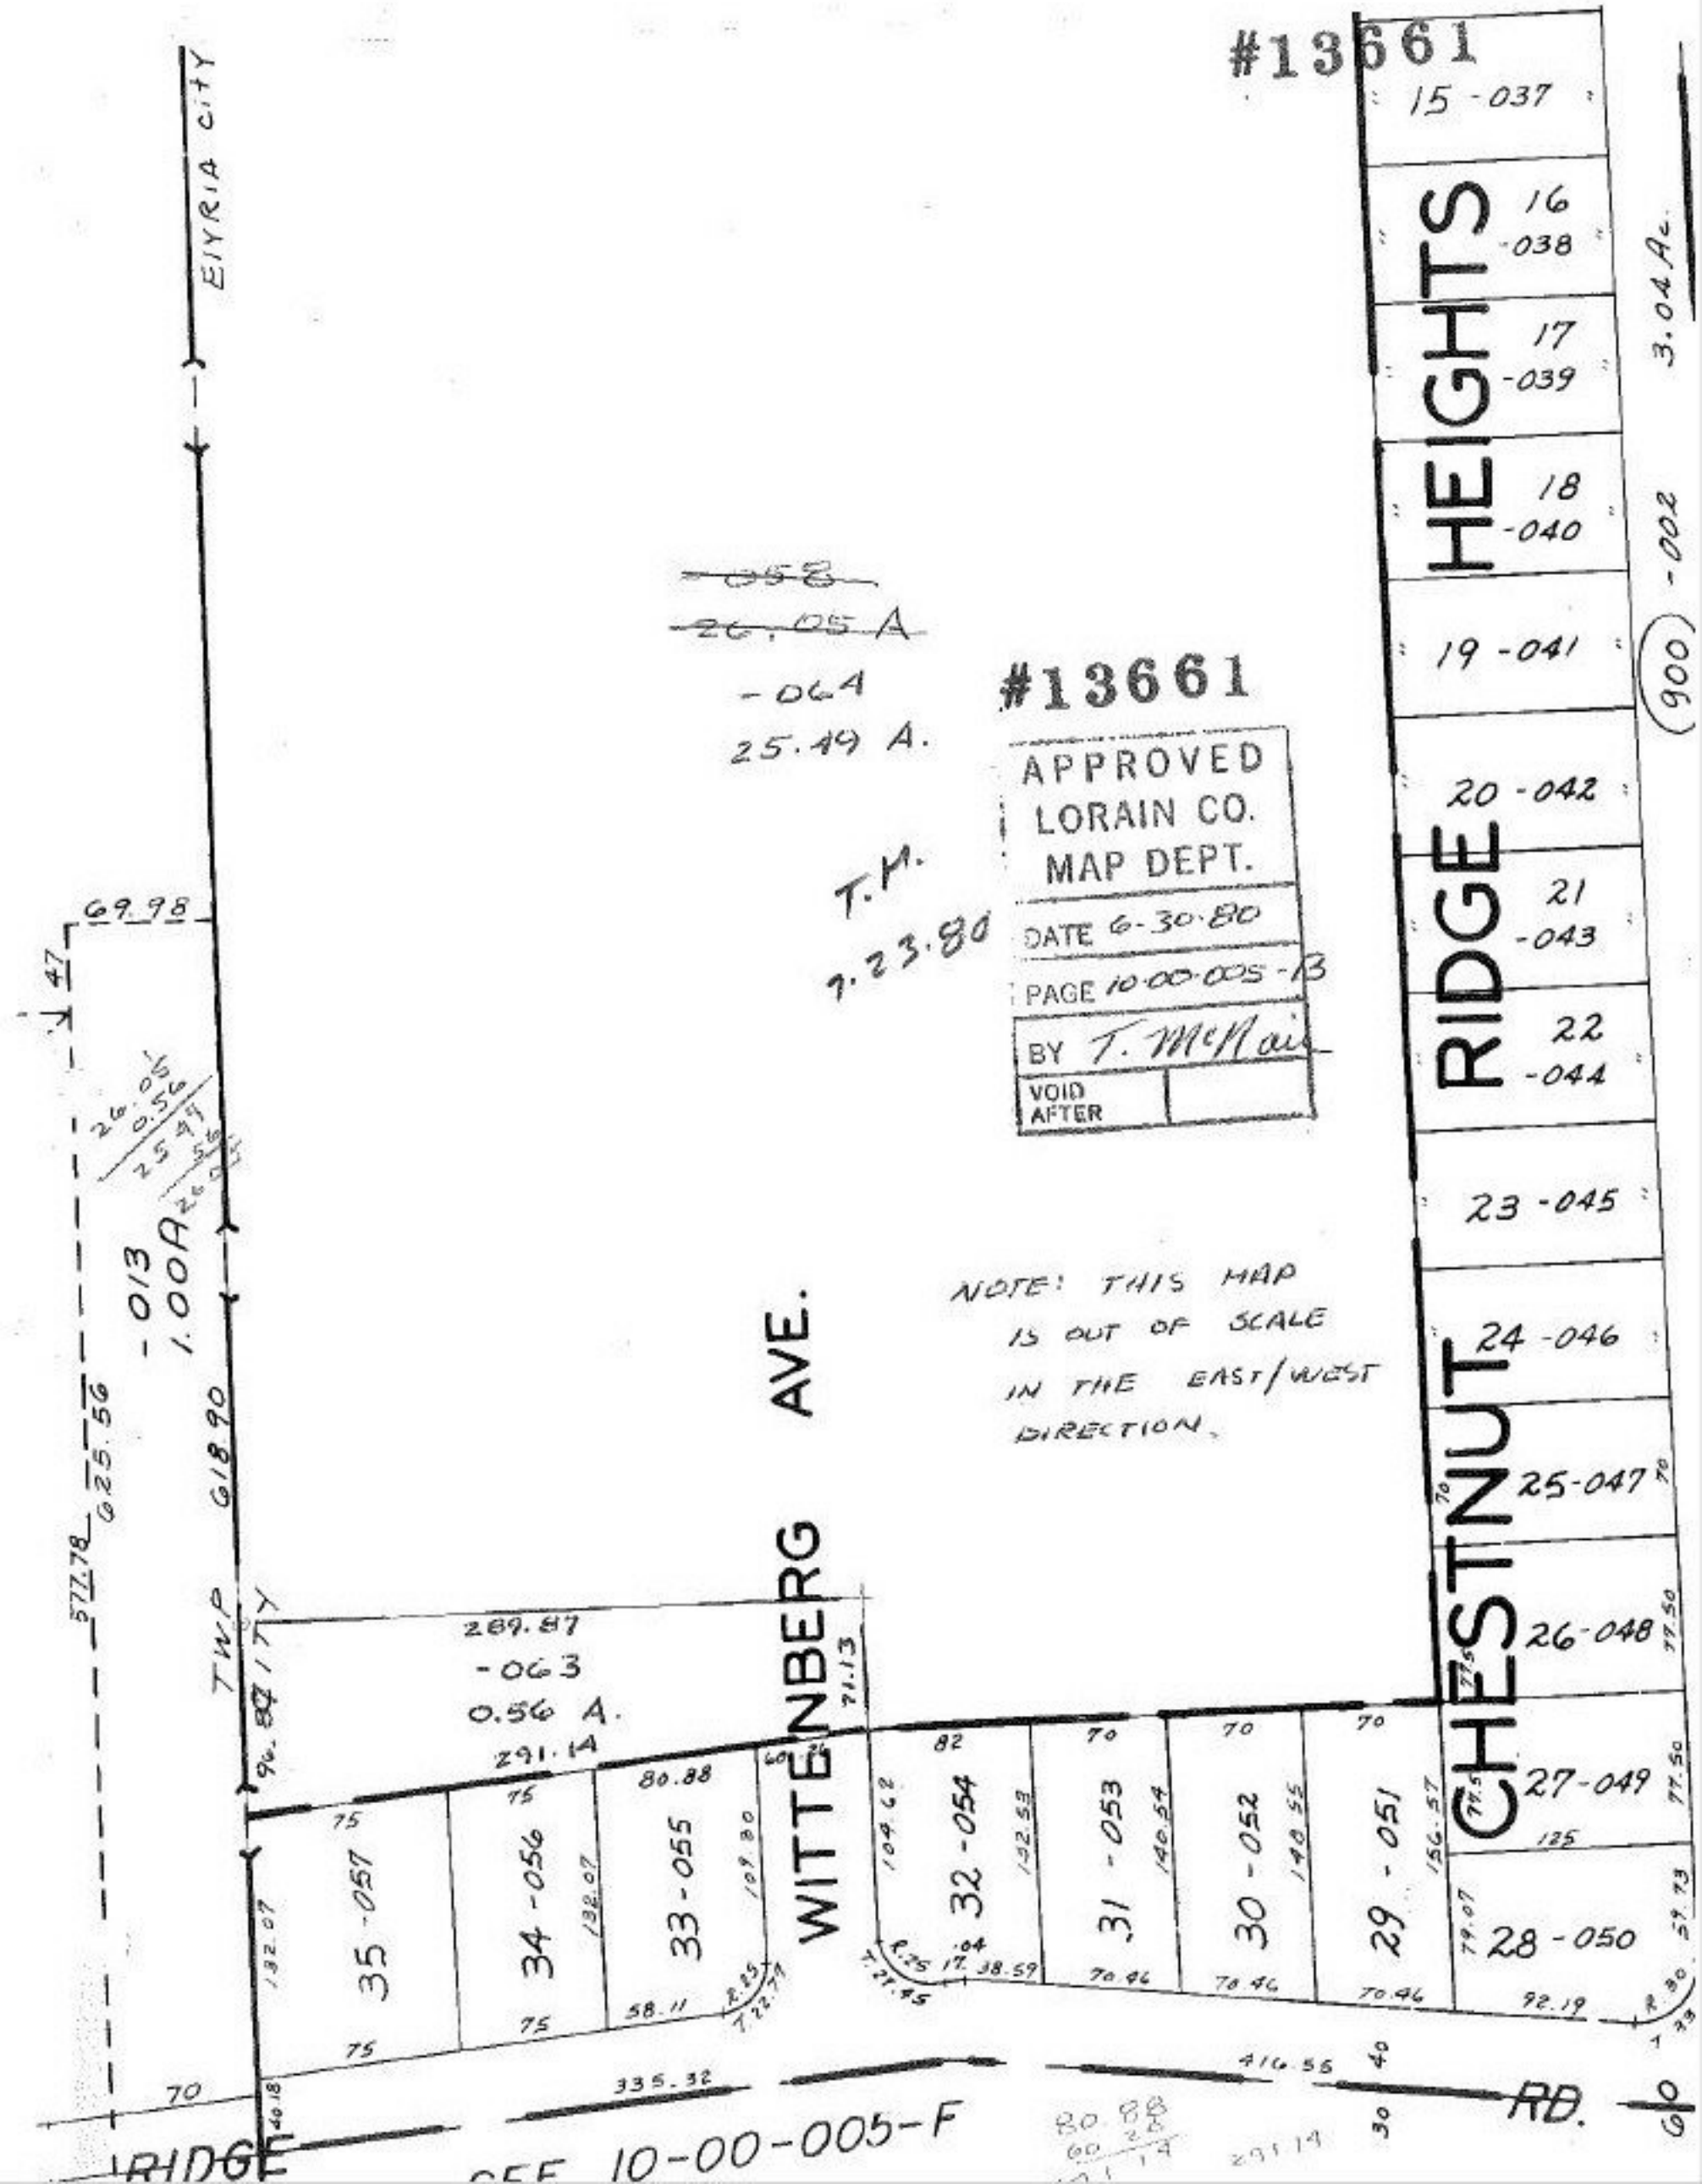

#13661
15 -037
16 -038
17 -039
18 -040
19 -041
20 -042
21 -043
22 -044
23 -045
24 -046
25-047
26-048
27-049
28 -050
RIDGE HEIGHTS
CHESTNUT
3.04 Ac.
(900) -002
EIYRIA CITY
~~-058~~
~~26.05 A~~
-064
25.49 A.
#13661
APPROVED
LORAIN CO.
MAP DEPT.
DATE 6-30-80
PAGE 10-00-005-B
BY T. McNair
VOID AFTER
T.M.
7.23.80
NOTE: THIS MAP IS OUT OF SCALE IN THE EAST/WEST DIRECTION.
WITTENBERG AVE.
69.98
47
26.05
0.56
25.49
-013
1.00A
618.90
625.56
577.78
TWP
289.87
-063
0.56 A.
291.14
35 -057
34 -056
33 -055
32 -054
31 -053
30 -052
29 -051
80.88
70
82
70
70
70
75
75
75
75
70
335.32
416.55
RD.
RIDGE
SEE 10-00-005-F