#13662

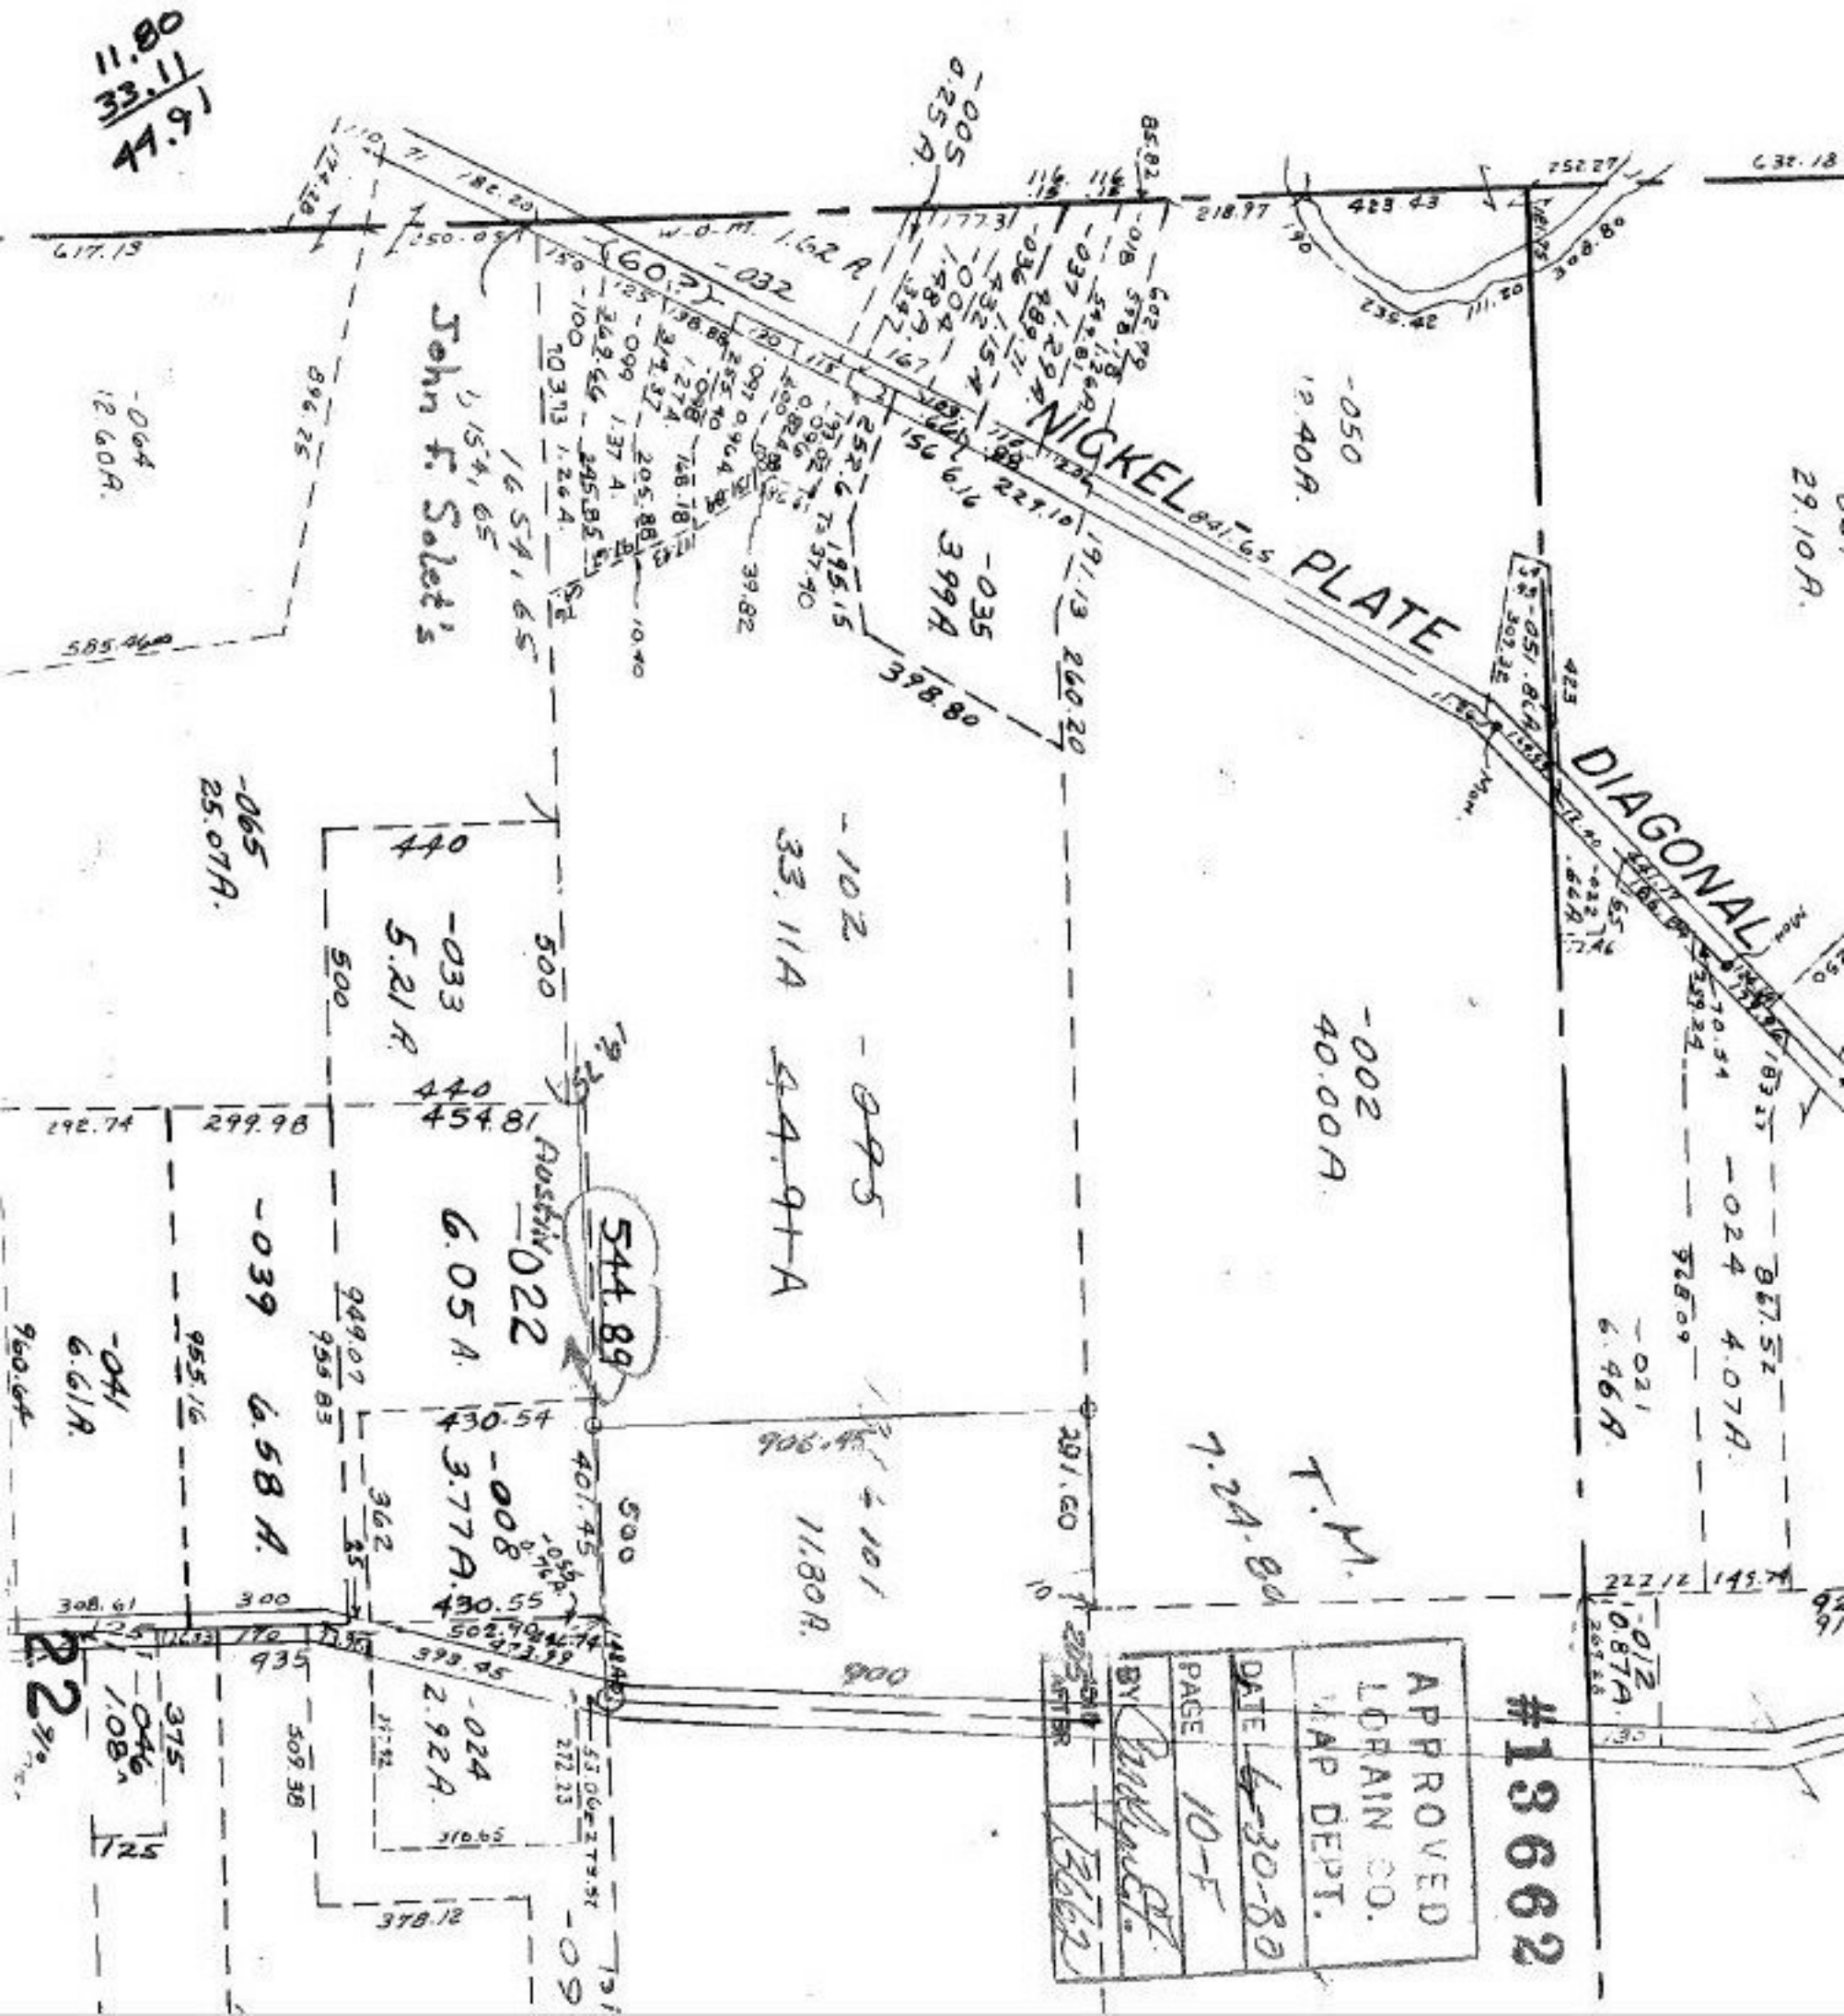

11.80
33.11
44.91
NICKEL PLATE DIAGONAL
John F. Solet's
-032
-035
3.99A
-050
12.40A.
-064
12.60A.
-065
25.07A.
-033
5.21A.
-102
33.11A
-095
44.91A
-002
40.00A.
-024
4.07A.
-021
6.46A.
-039
6.58A.
-022
6.05A.
544.89
-041
6.61A.
-008
3.77A.
-101
11.80A.
T.M.
7.24.80
-024
2.92A.
-046
1.08A.
-012
0.87A.
APPROVED
LORAIN CO.
MAP DEPT.
DATE 6-30-80
PAGE 10-F
BY
#13662