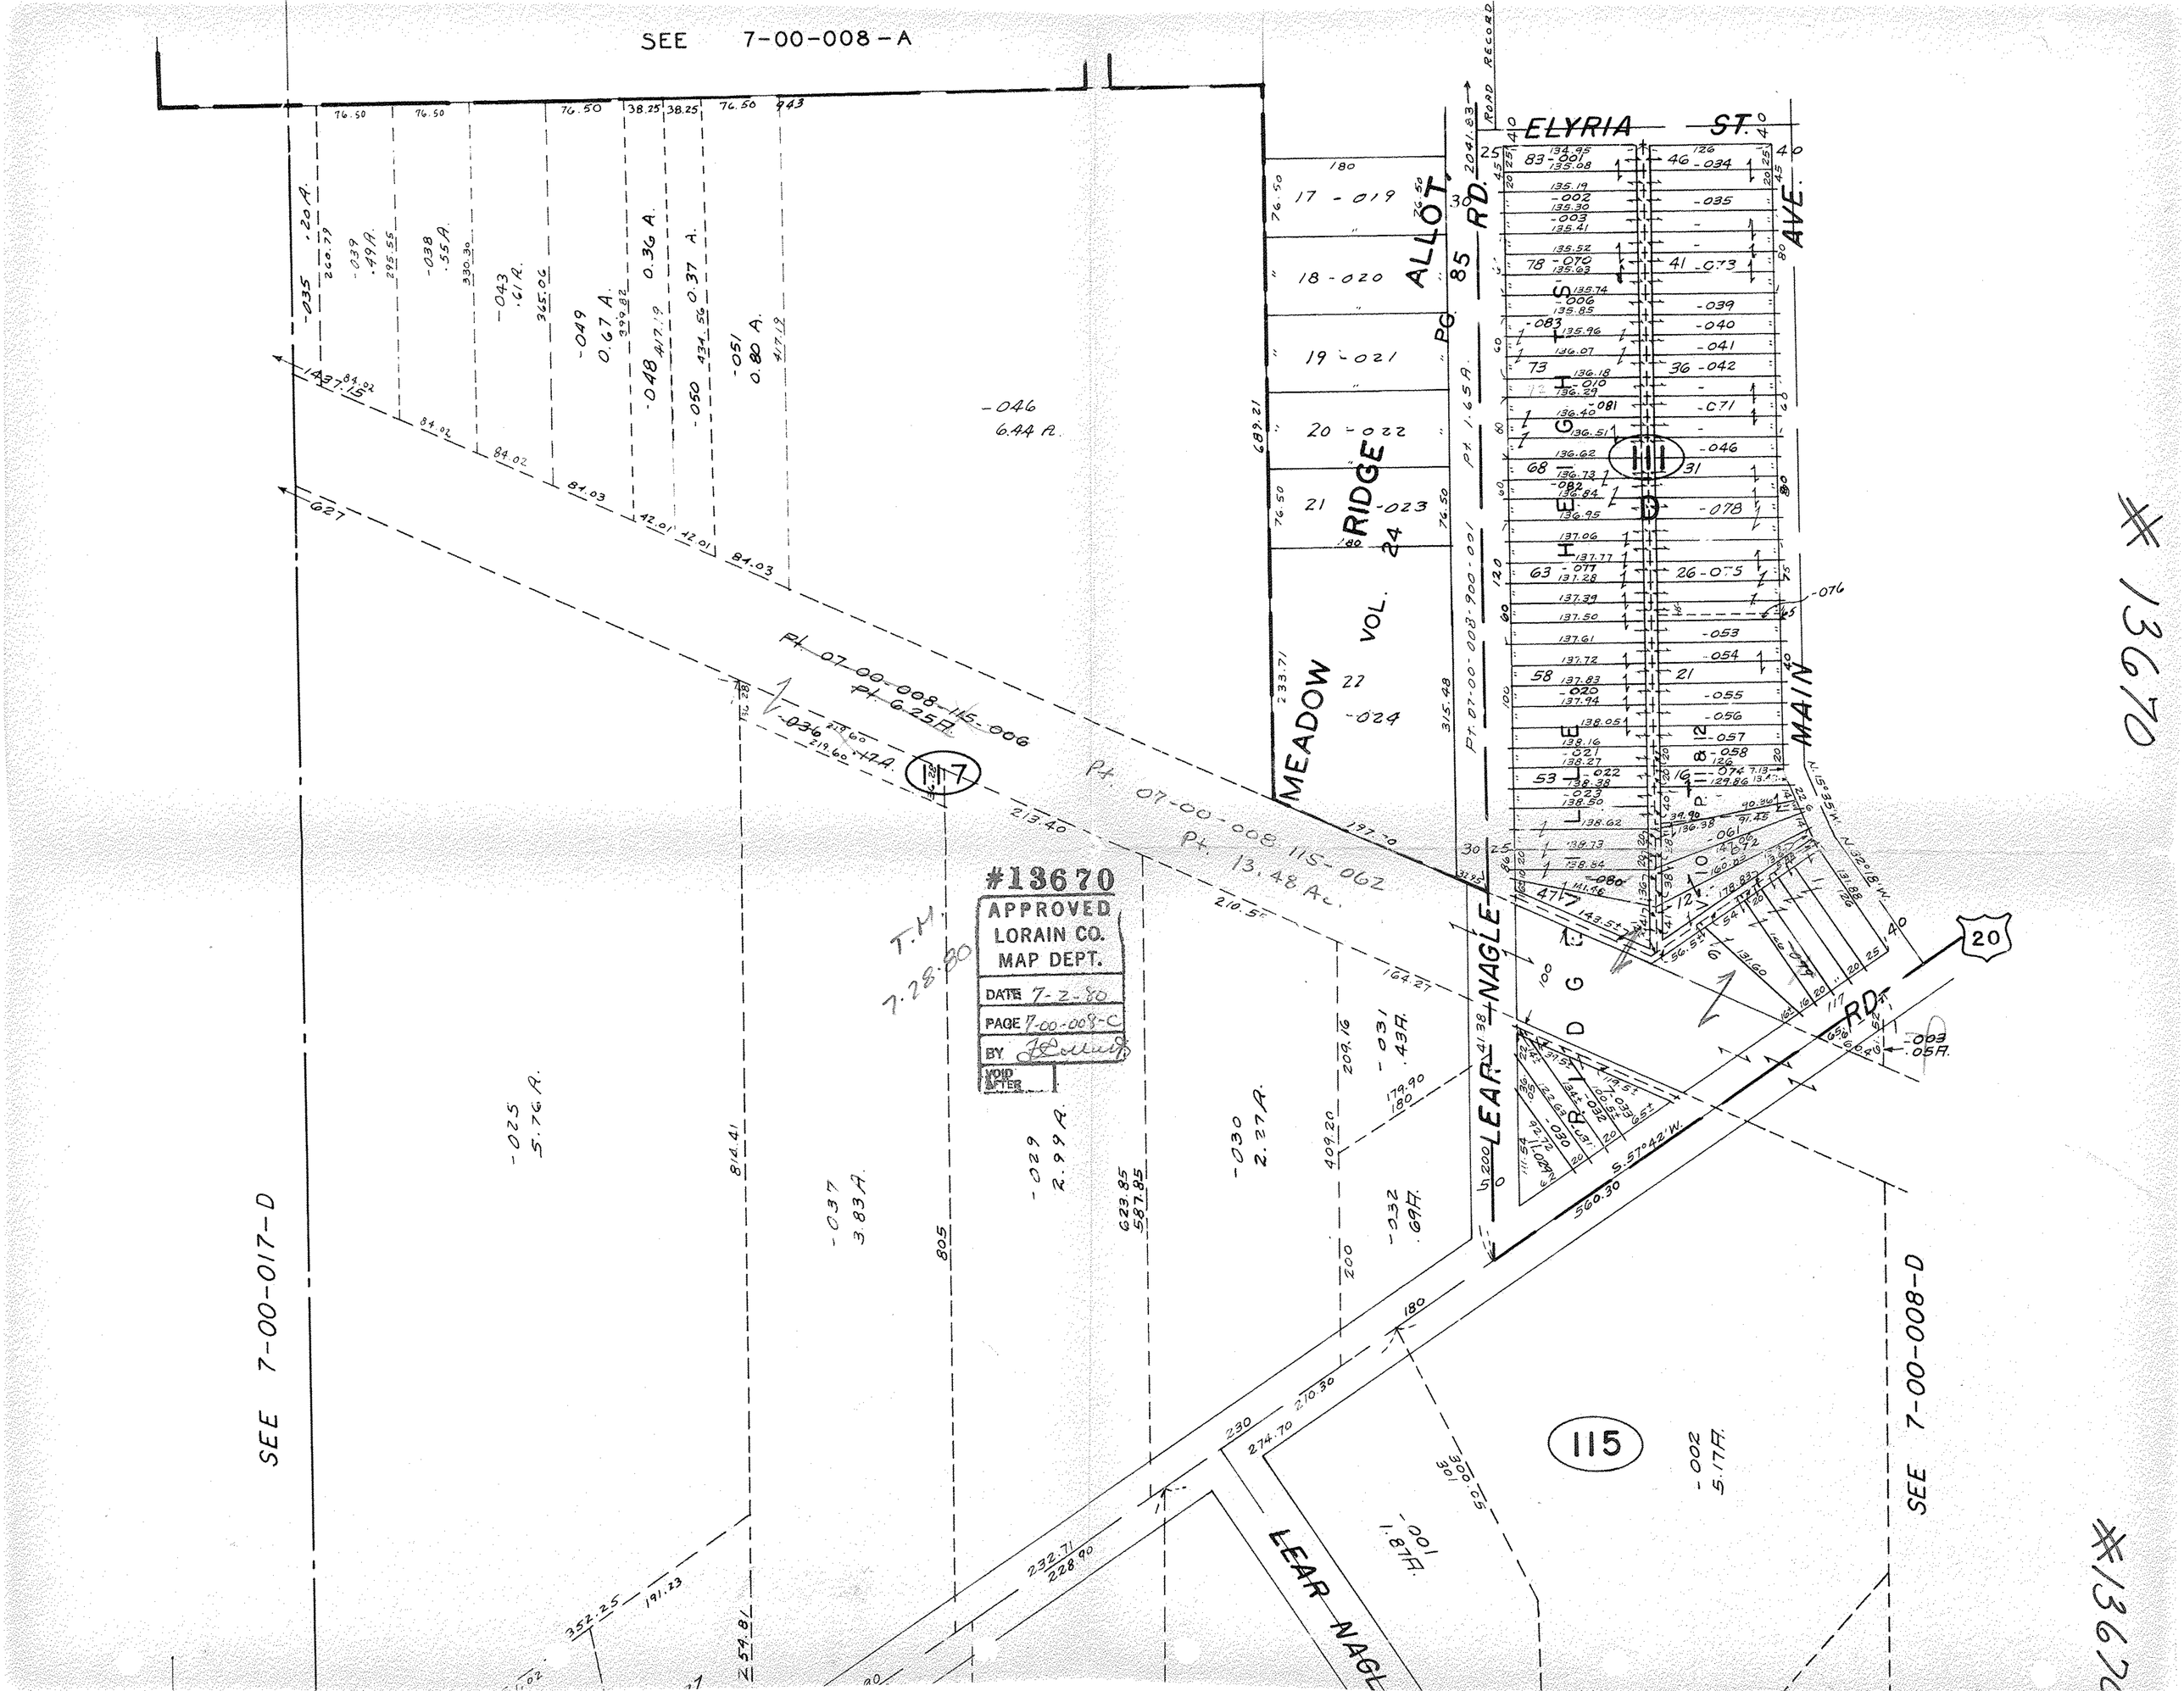
SEE 7-00-008-A
ELYRIA ST.
ALLOT. RD.
MEADOW RIDGE
VOL. 24
PG. 85
LEAR NAGLE RD.
MAIN AVE.
LEAR NAGLE
SEE 7-00-017-D
SEE 7-00-008-D
Pt. 07-00-008-115-006
Pt. 6.25A.
Pt. 07-00-008-115-062
Pt. 13.48 Ac.
Pt. 07-00-008-900-001
Pt. 1.65A.
-046
6.44 A.
-025
5.76 A.
-037
3.83 A.
-029
2.99 A.
-030
2.27 A.
-031
.43A.
-032
.69A.
-001
1.87A.
-002
5.17A.
-003
.05A.
-035
.20A.
-039
.49A.
-038
.55A.
-043
.61A.
-049
0.67 A.
-048
0.36 A.
-050
0.37 A.
-051
0.80 A.
117
115
20
T.M.
7-28-80
#13670
APPROVED
LORAIN CO.
MAP DEPT.
DATE 7-2-80
PAGE 7-00-008-C
BY
VOID AFTER
#13670
#13670