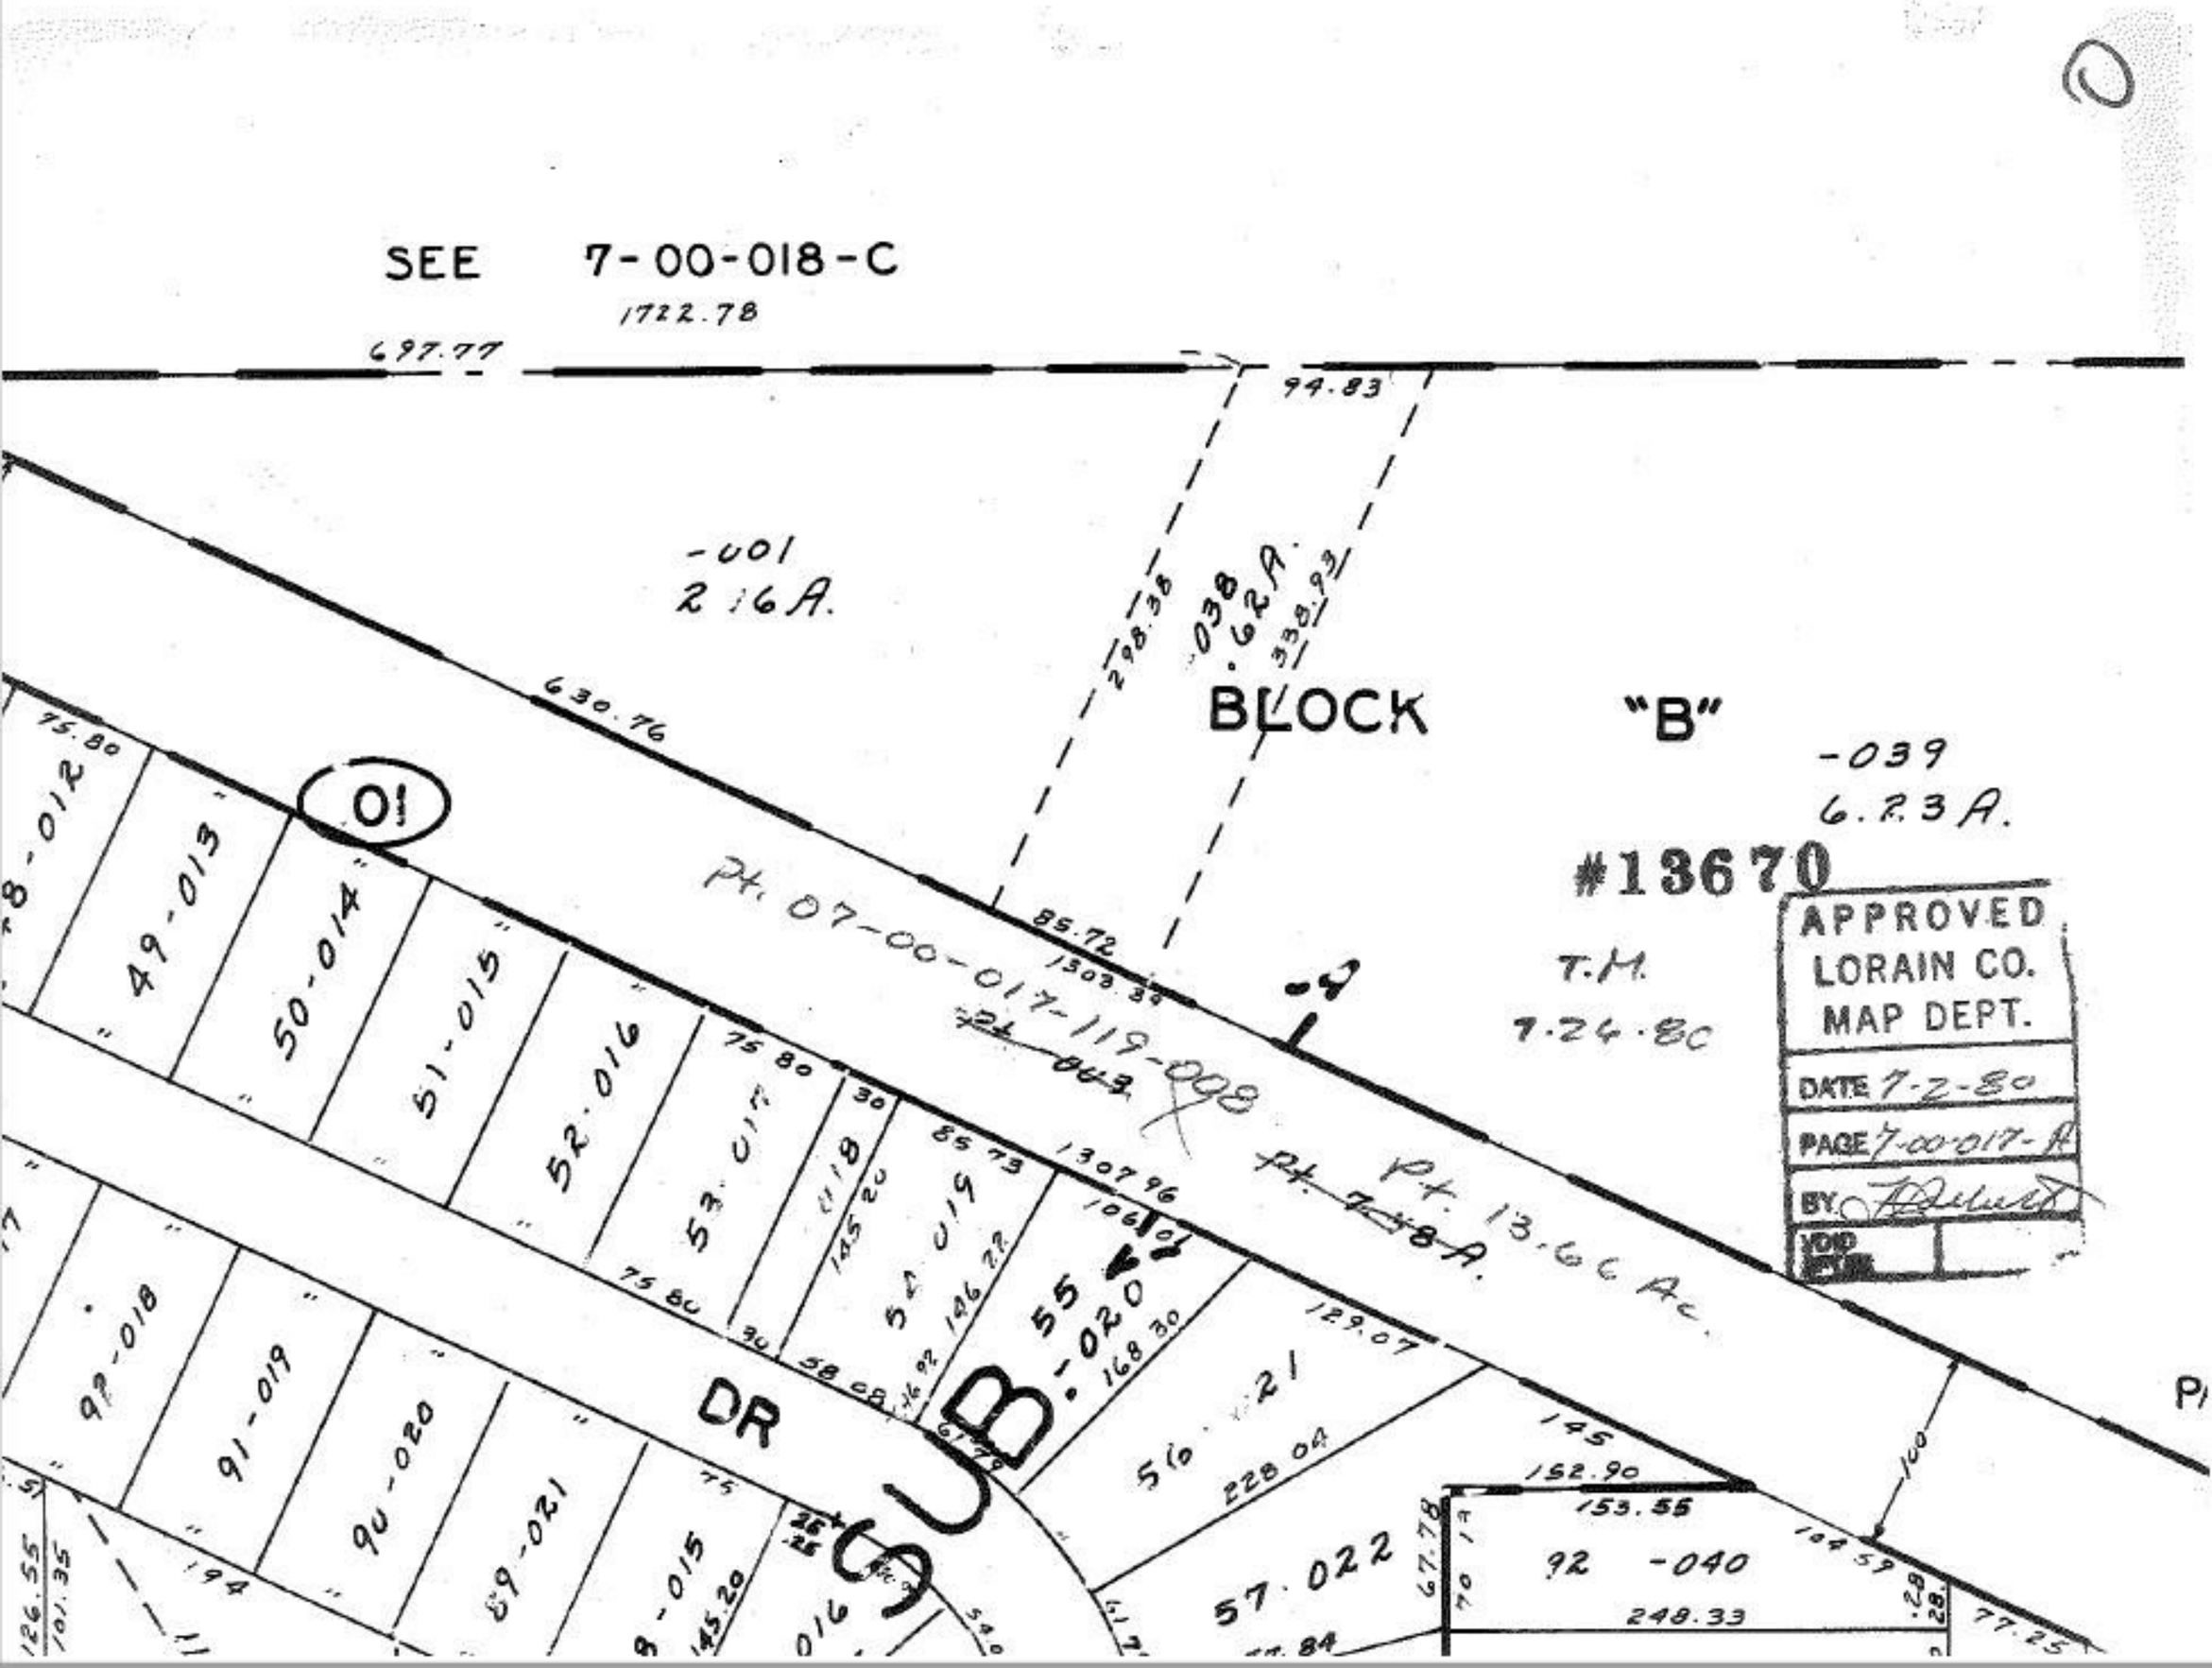
SEE 7-00-018-C
1722.78
697.77
94.83
-001
2.16A.
630.76
298.38
.038
.62A.
338.93
BLOCK "B"
-039
6.23A.
#13670
APPROVED
LORAIN CO.
MAP DEPT.
DATE 7-2-80
PAGE 7-00-017-A
BY
VOID
T.M.
7-24-80
01
Pt. 07-00-017-119-008
Pt. 13.66 Ac.
49-013
50-014
51-015
52-016
53-017
54-019
55-020
56-021
57-022
92-018
91-019
90-020
89-021
92-040
DR
SUB
85.72
1303.34
1307.96
129.07
145
152.90
153.55
248.33
100
77.25