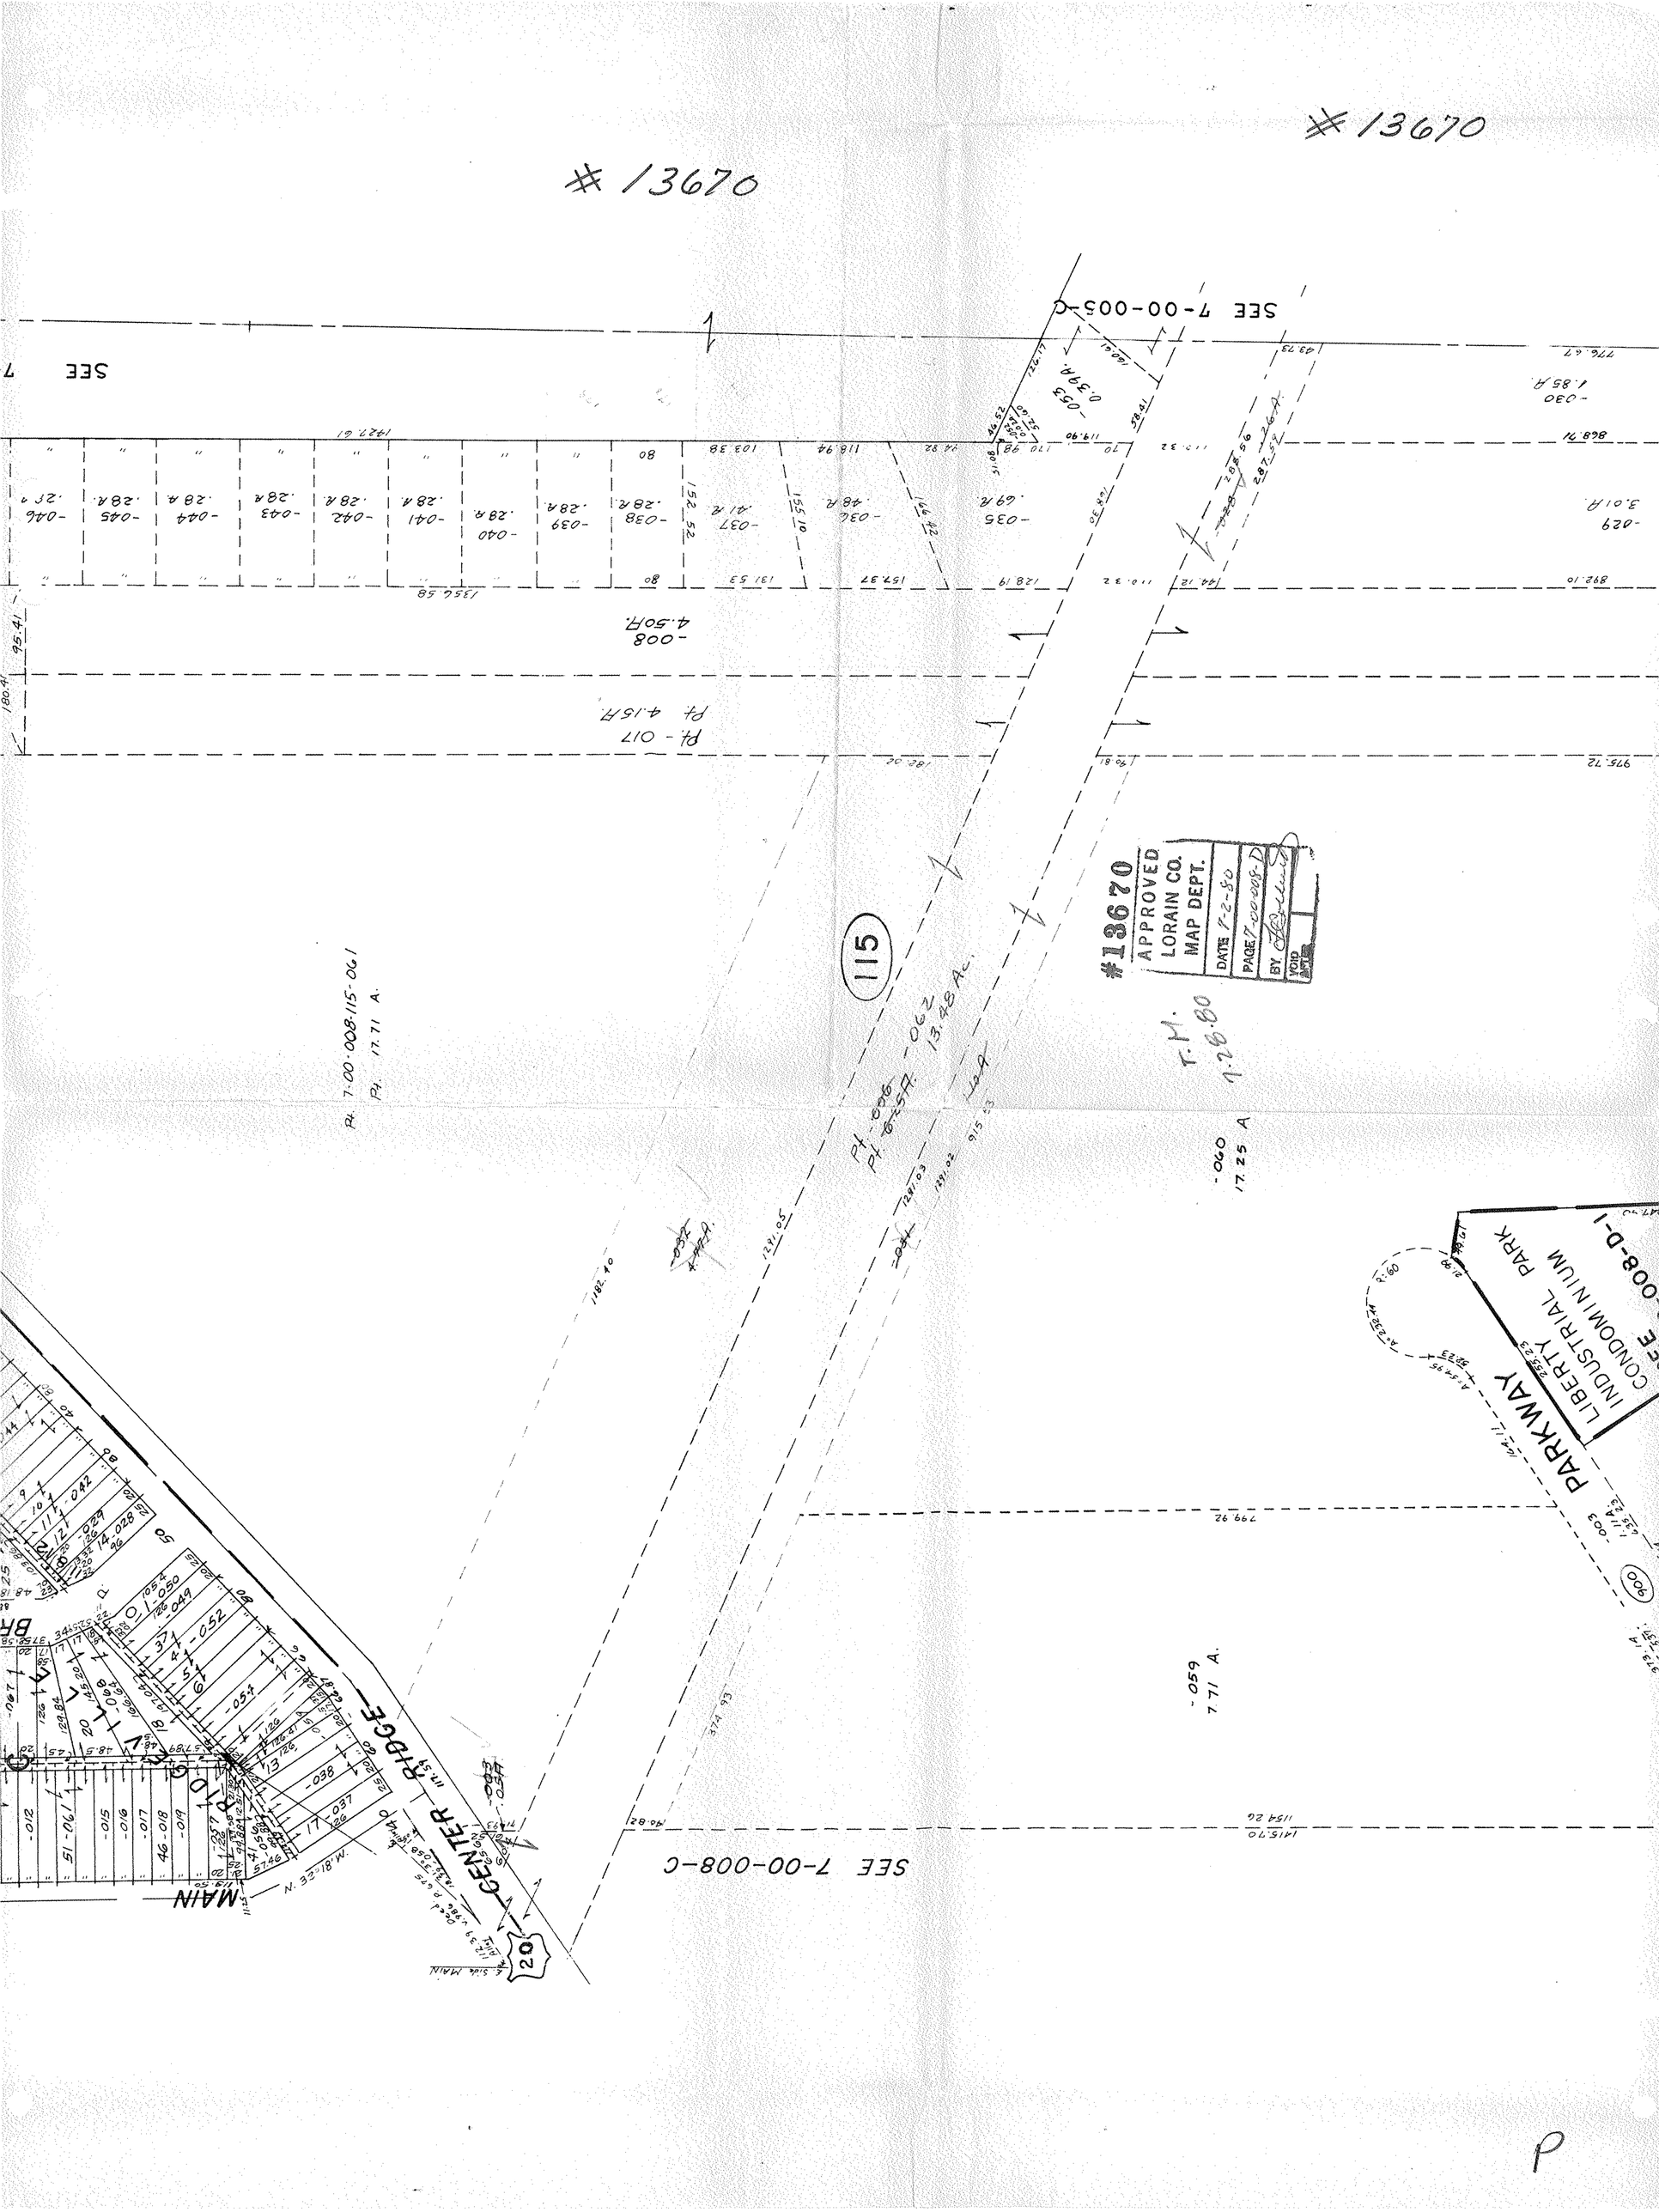

#13670
#13670
SEE 7-00-005-C
SEE 7-00-008-C
PARKWAY
LIBERTY INDUSTRIAL PARK CONDOMINIUM
CENTER RIDGE
MAIN
115
20
#13670
APPROVED
LORAIN CO.
MAP DEPT.
DATE 7-2-80
PAGE 7-00-008-D
BY
VOID
AFTER
T.M.
7.28.80
Pt. 7-00-008-115-061
Pt. 17.71 A.
-060
17.25 A
-059
7.71 A.
-008
4.50A.
Pt. -017
Pt. 4.15A.
-029
3.01A.
-030
1.85A.
-053
0.39A.
-062
13.48 Ac.

P