SEE 3-00-096-A

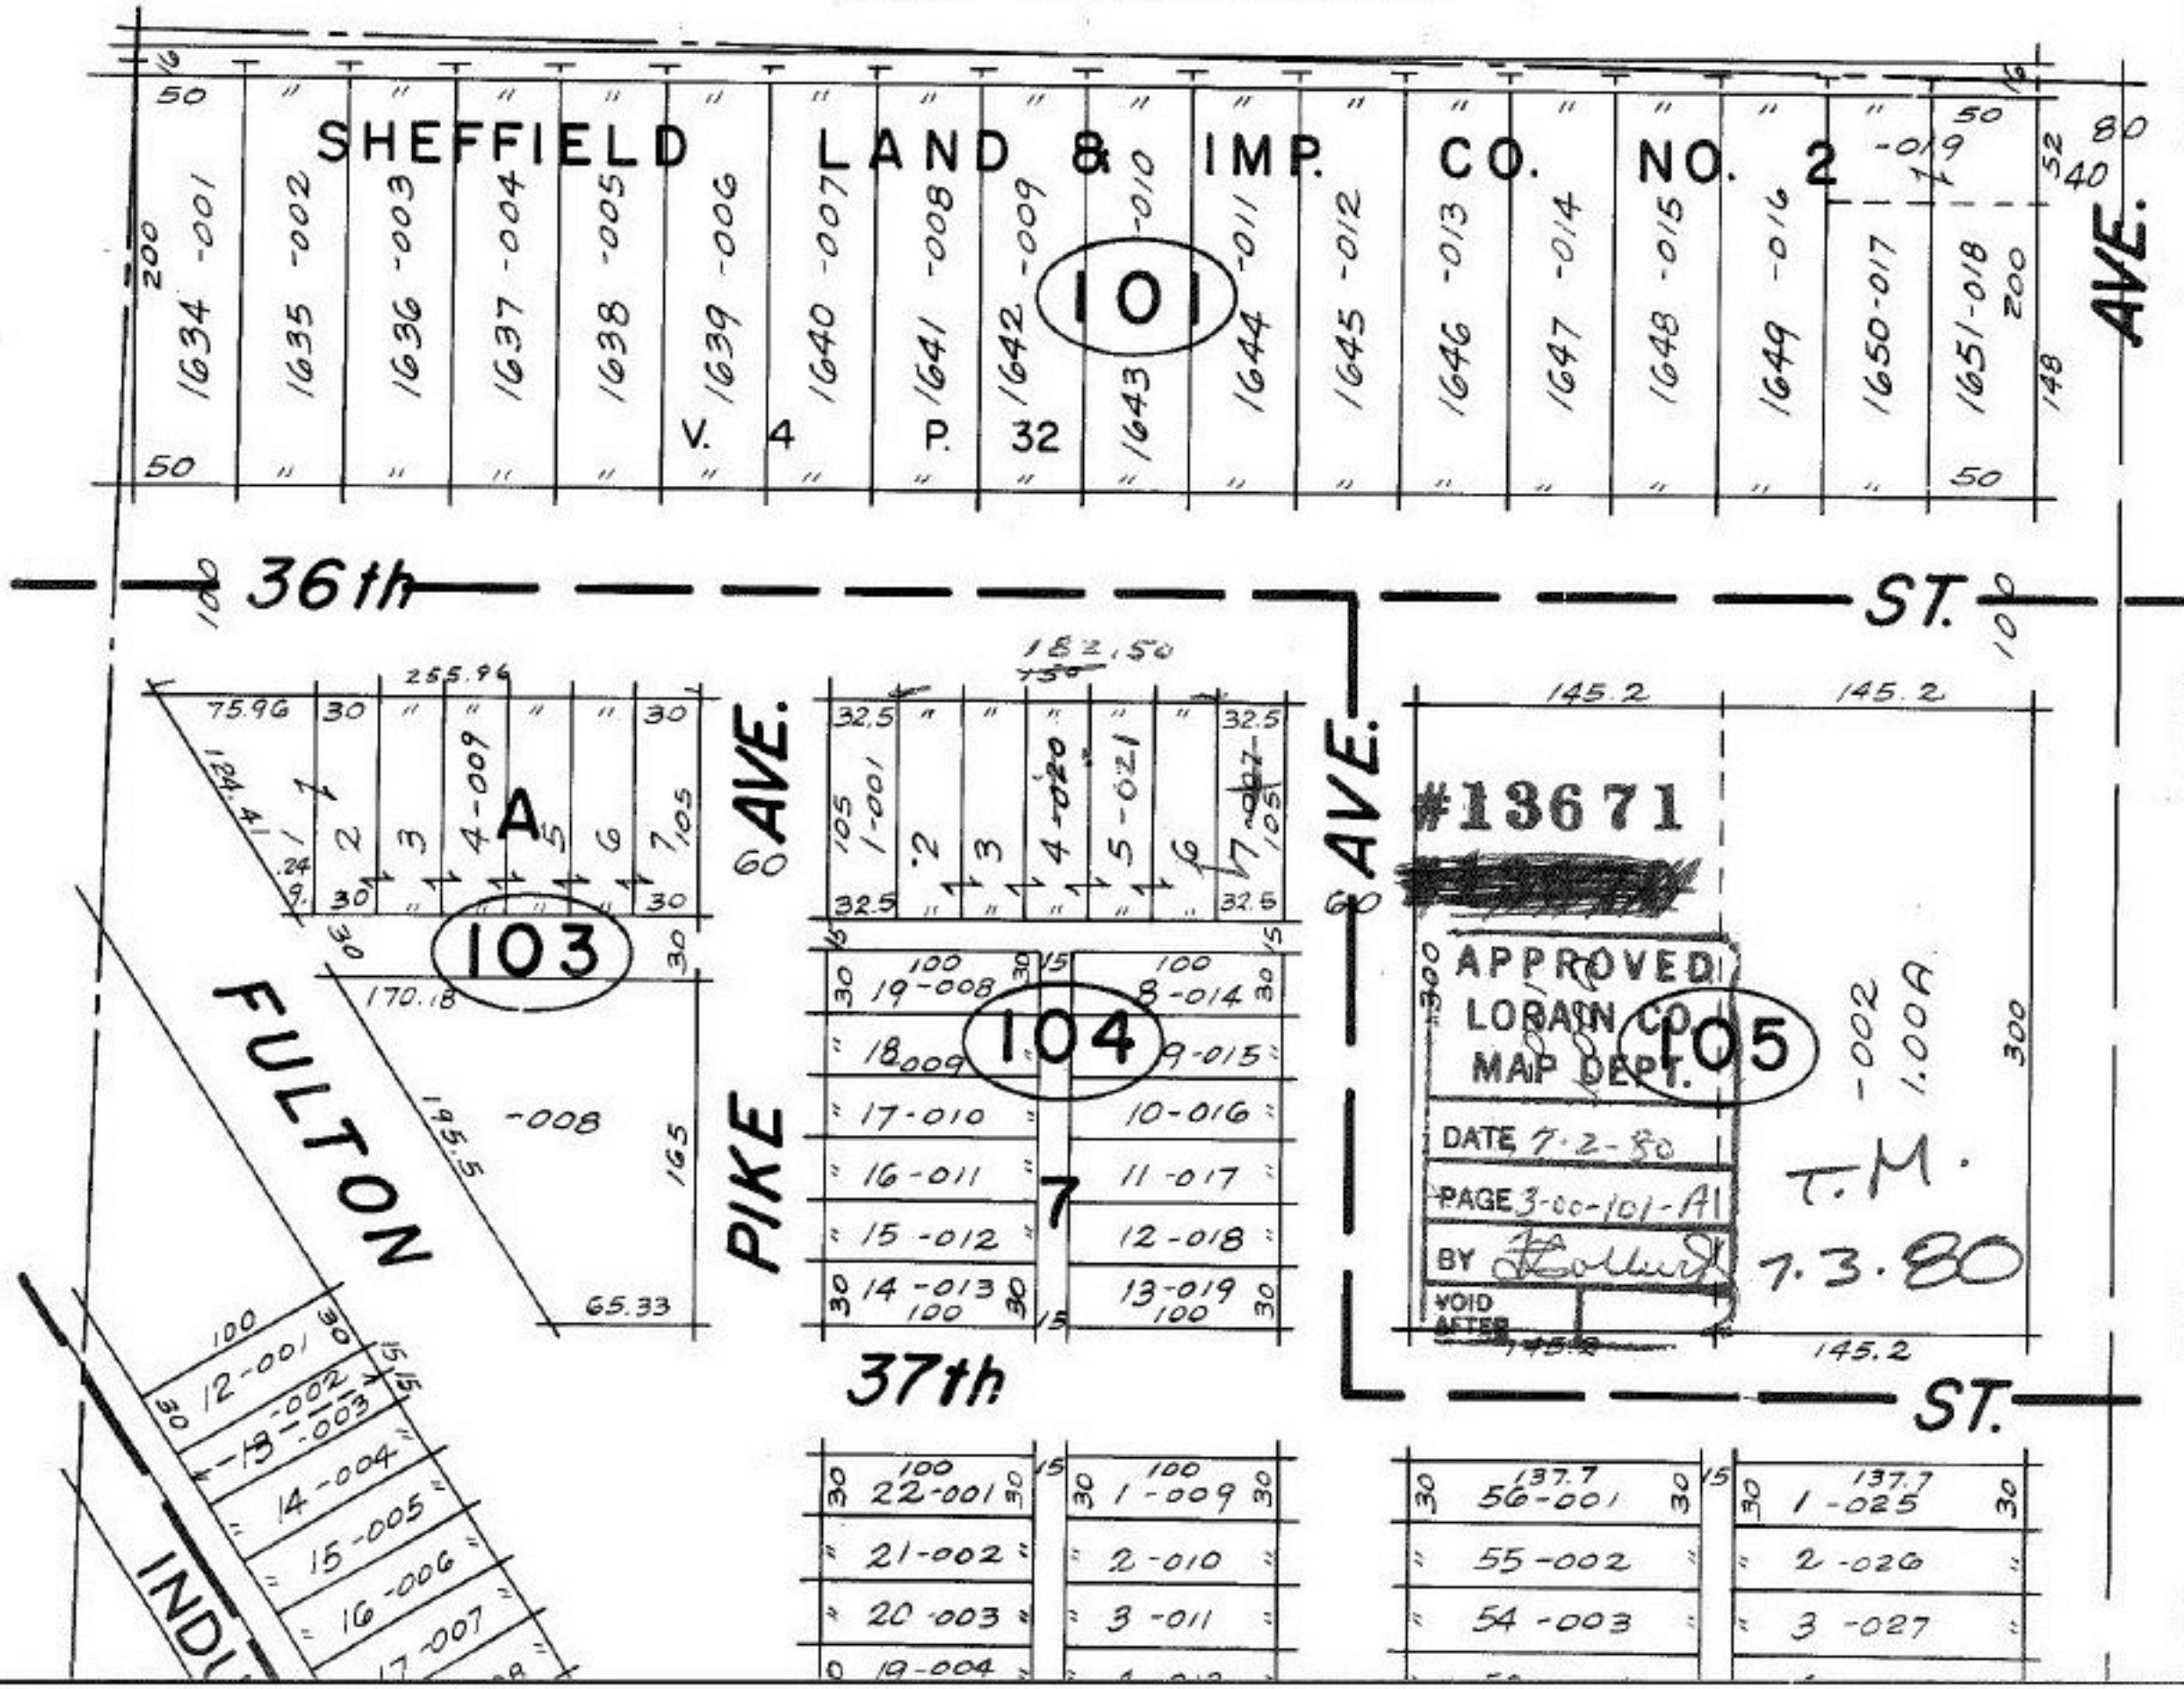

SHEFFIELD LAND & IMP. CO. NO. 2
101
V. 4 P. 32
36th ST.
37th ST.
FULTON AVE.
PIKE AVE.
103
104
105
A
7
#13671
APPROVED
LORAIN CO.
MAP DEPT.
DATE 7-2-80
PAGE 3-00-101-A1
BY
VOID AFTER
T.M.
7.3.80