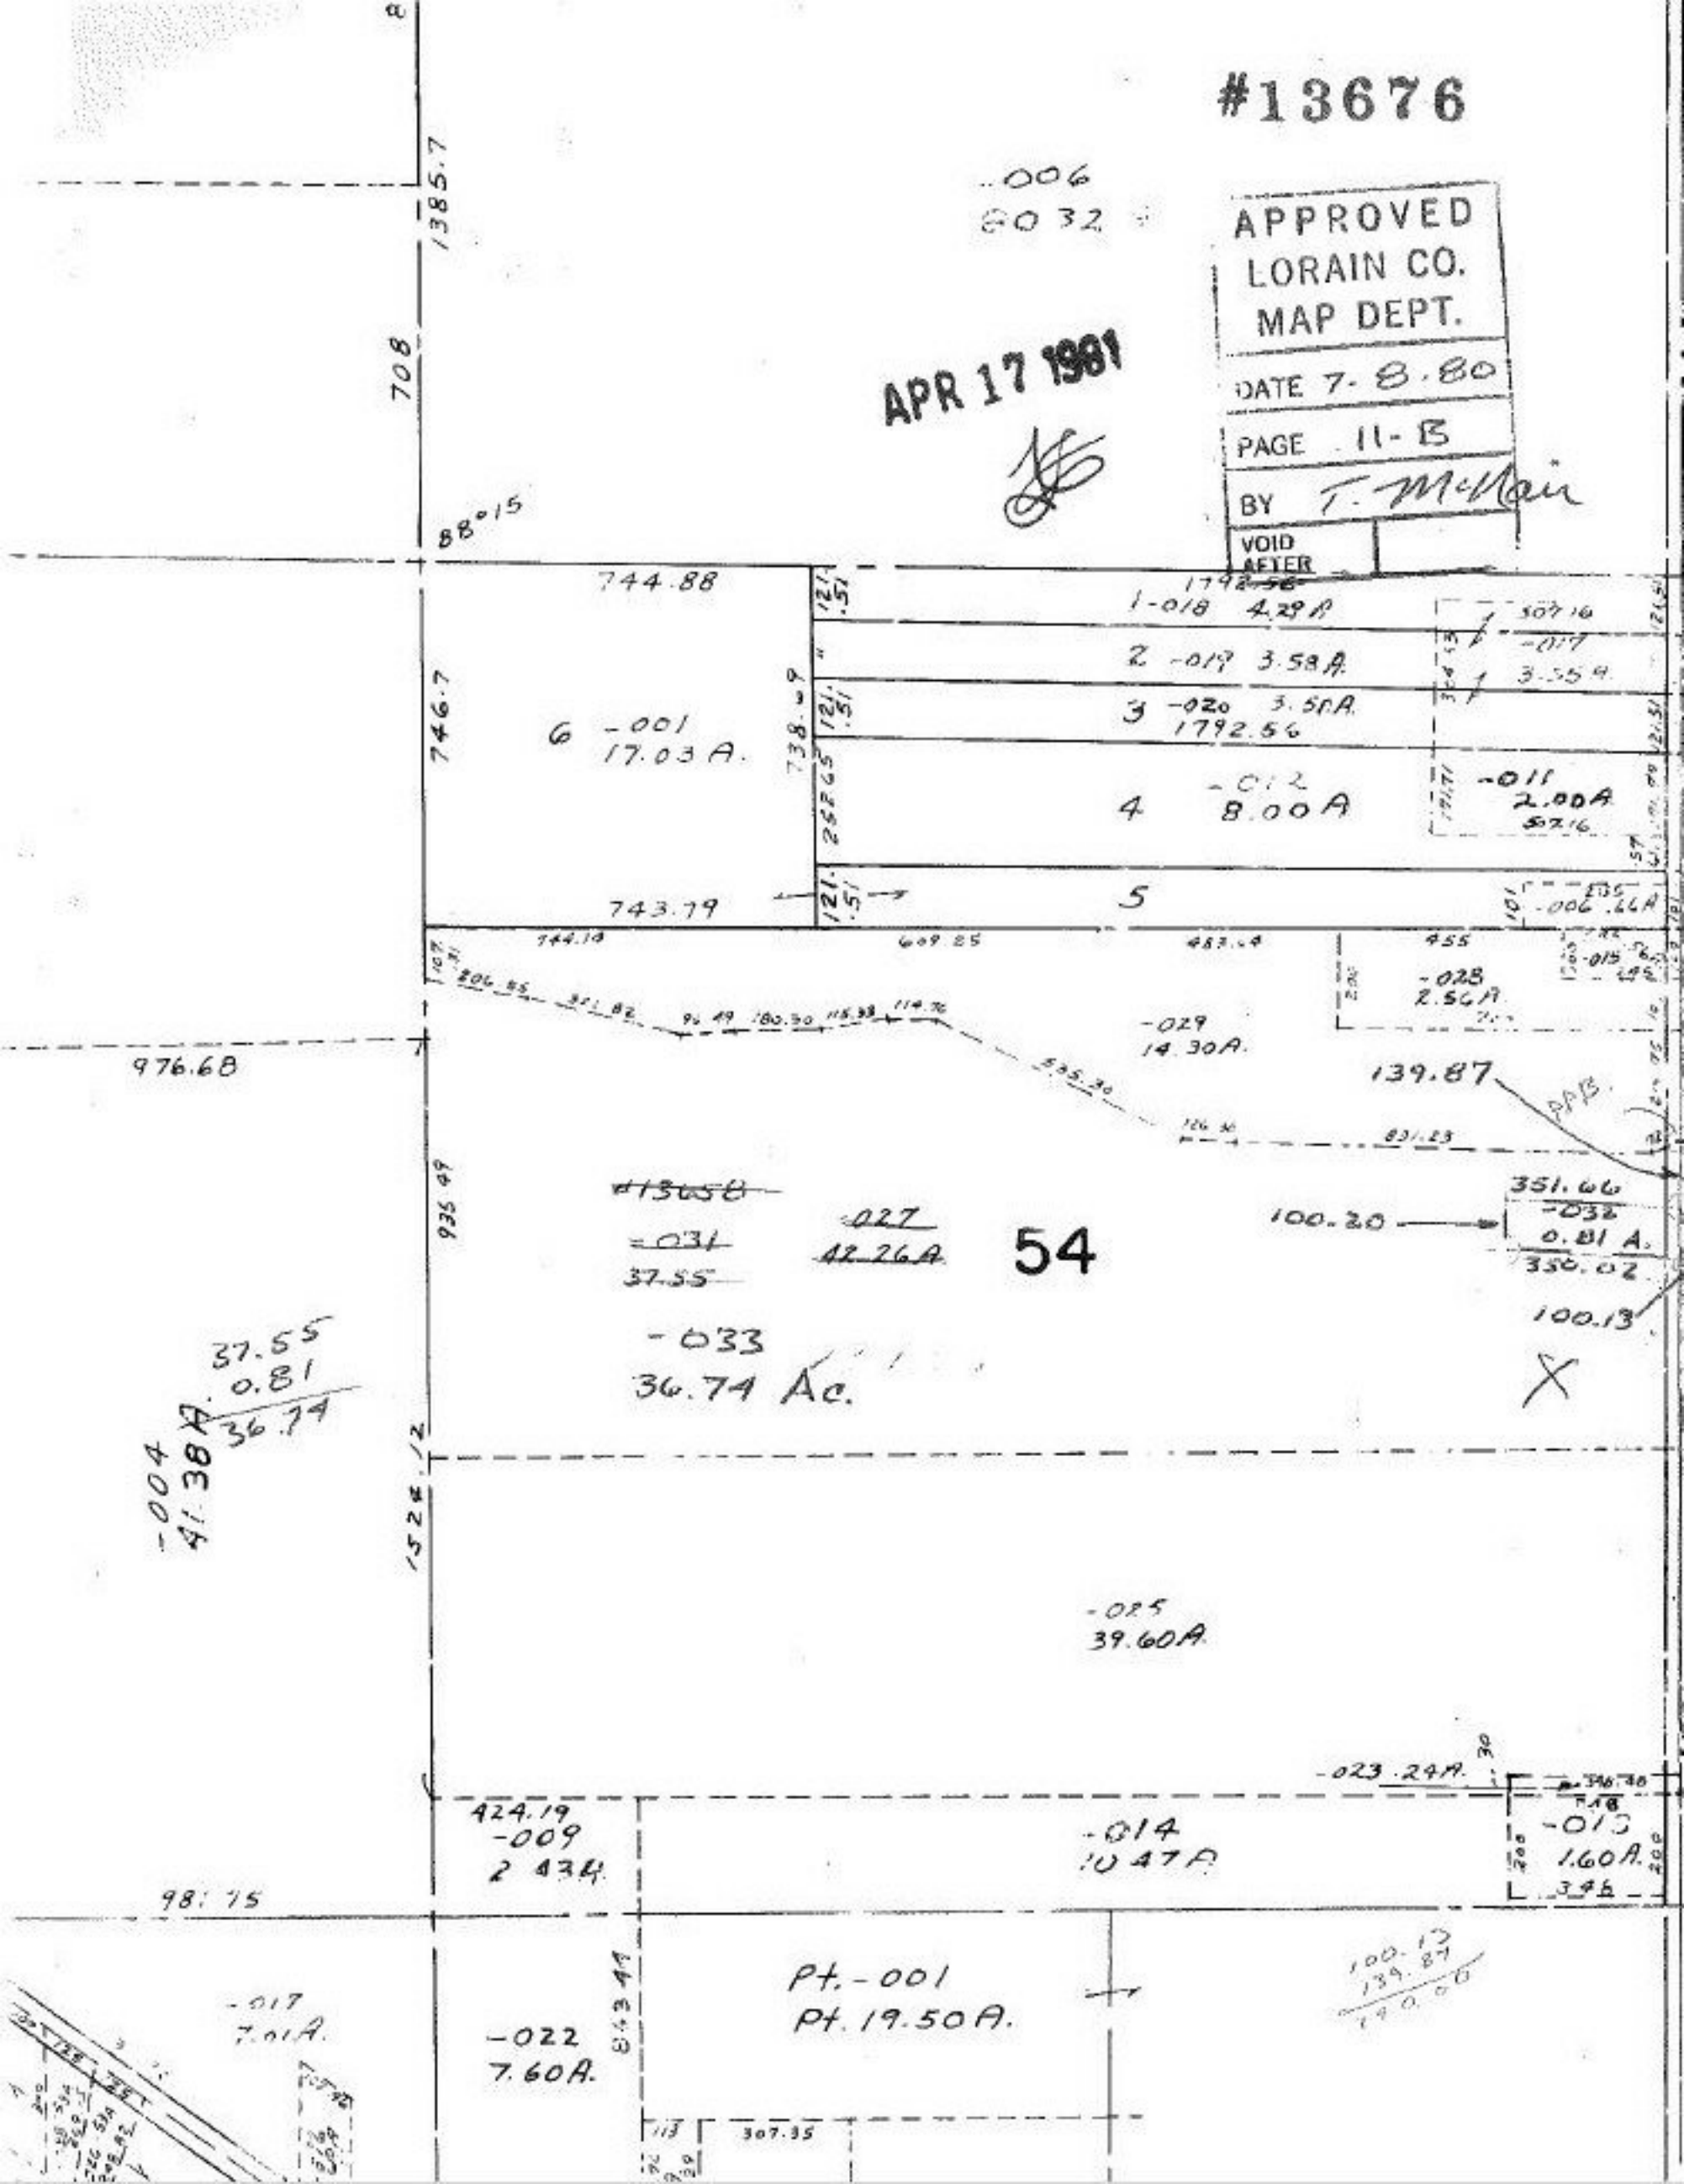
#13676
APPROVED
LORAIN CO.
MAP DEPT.
DATE 7-8-80
PAGE 11-B
BY T. McNair
VOID AFTER
APR 17 1981
.006
8032
1385.7
708
88°15
744.88
1-018 4.29A
2 -019 3.58A
3 -020 3.50A
1792.56
6 -001
17.03 A.
746.7
738.69
4 -012
8.00A
-011
2.00A
5
743.79
744.14
609.25
483.64
455
-028
2.56A
-029
14.30A.
976.68
139.87
831.23
935.49
#13658
-031
37.55
-027
42.26A
54
100.20
351.66
-032
0.81 A.
350.02
100.13
-033
36.74 Ac.
37.55
0.81
36.74
-004
41.38A
1524.12
-025
39.60A
-023 .24A.
424.19
-009
2.43A
-014
10.47A
-013
1.60A.
981.75
-017
7.01A.
-022
7.60A.
843.44
Pt.-001
Pt. 19.50A.
100.13
139.87
140.00
307.35