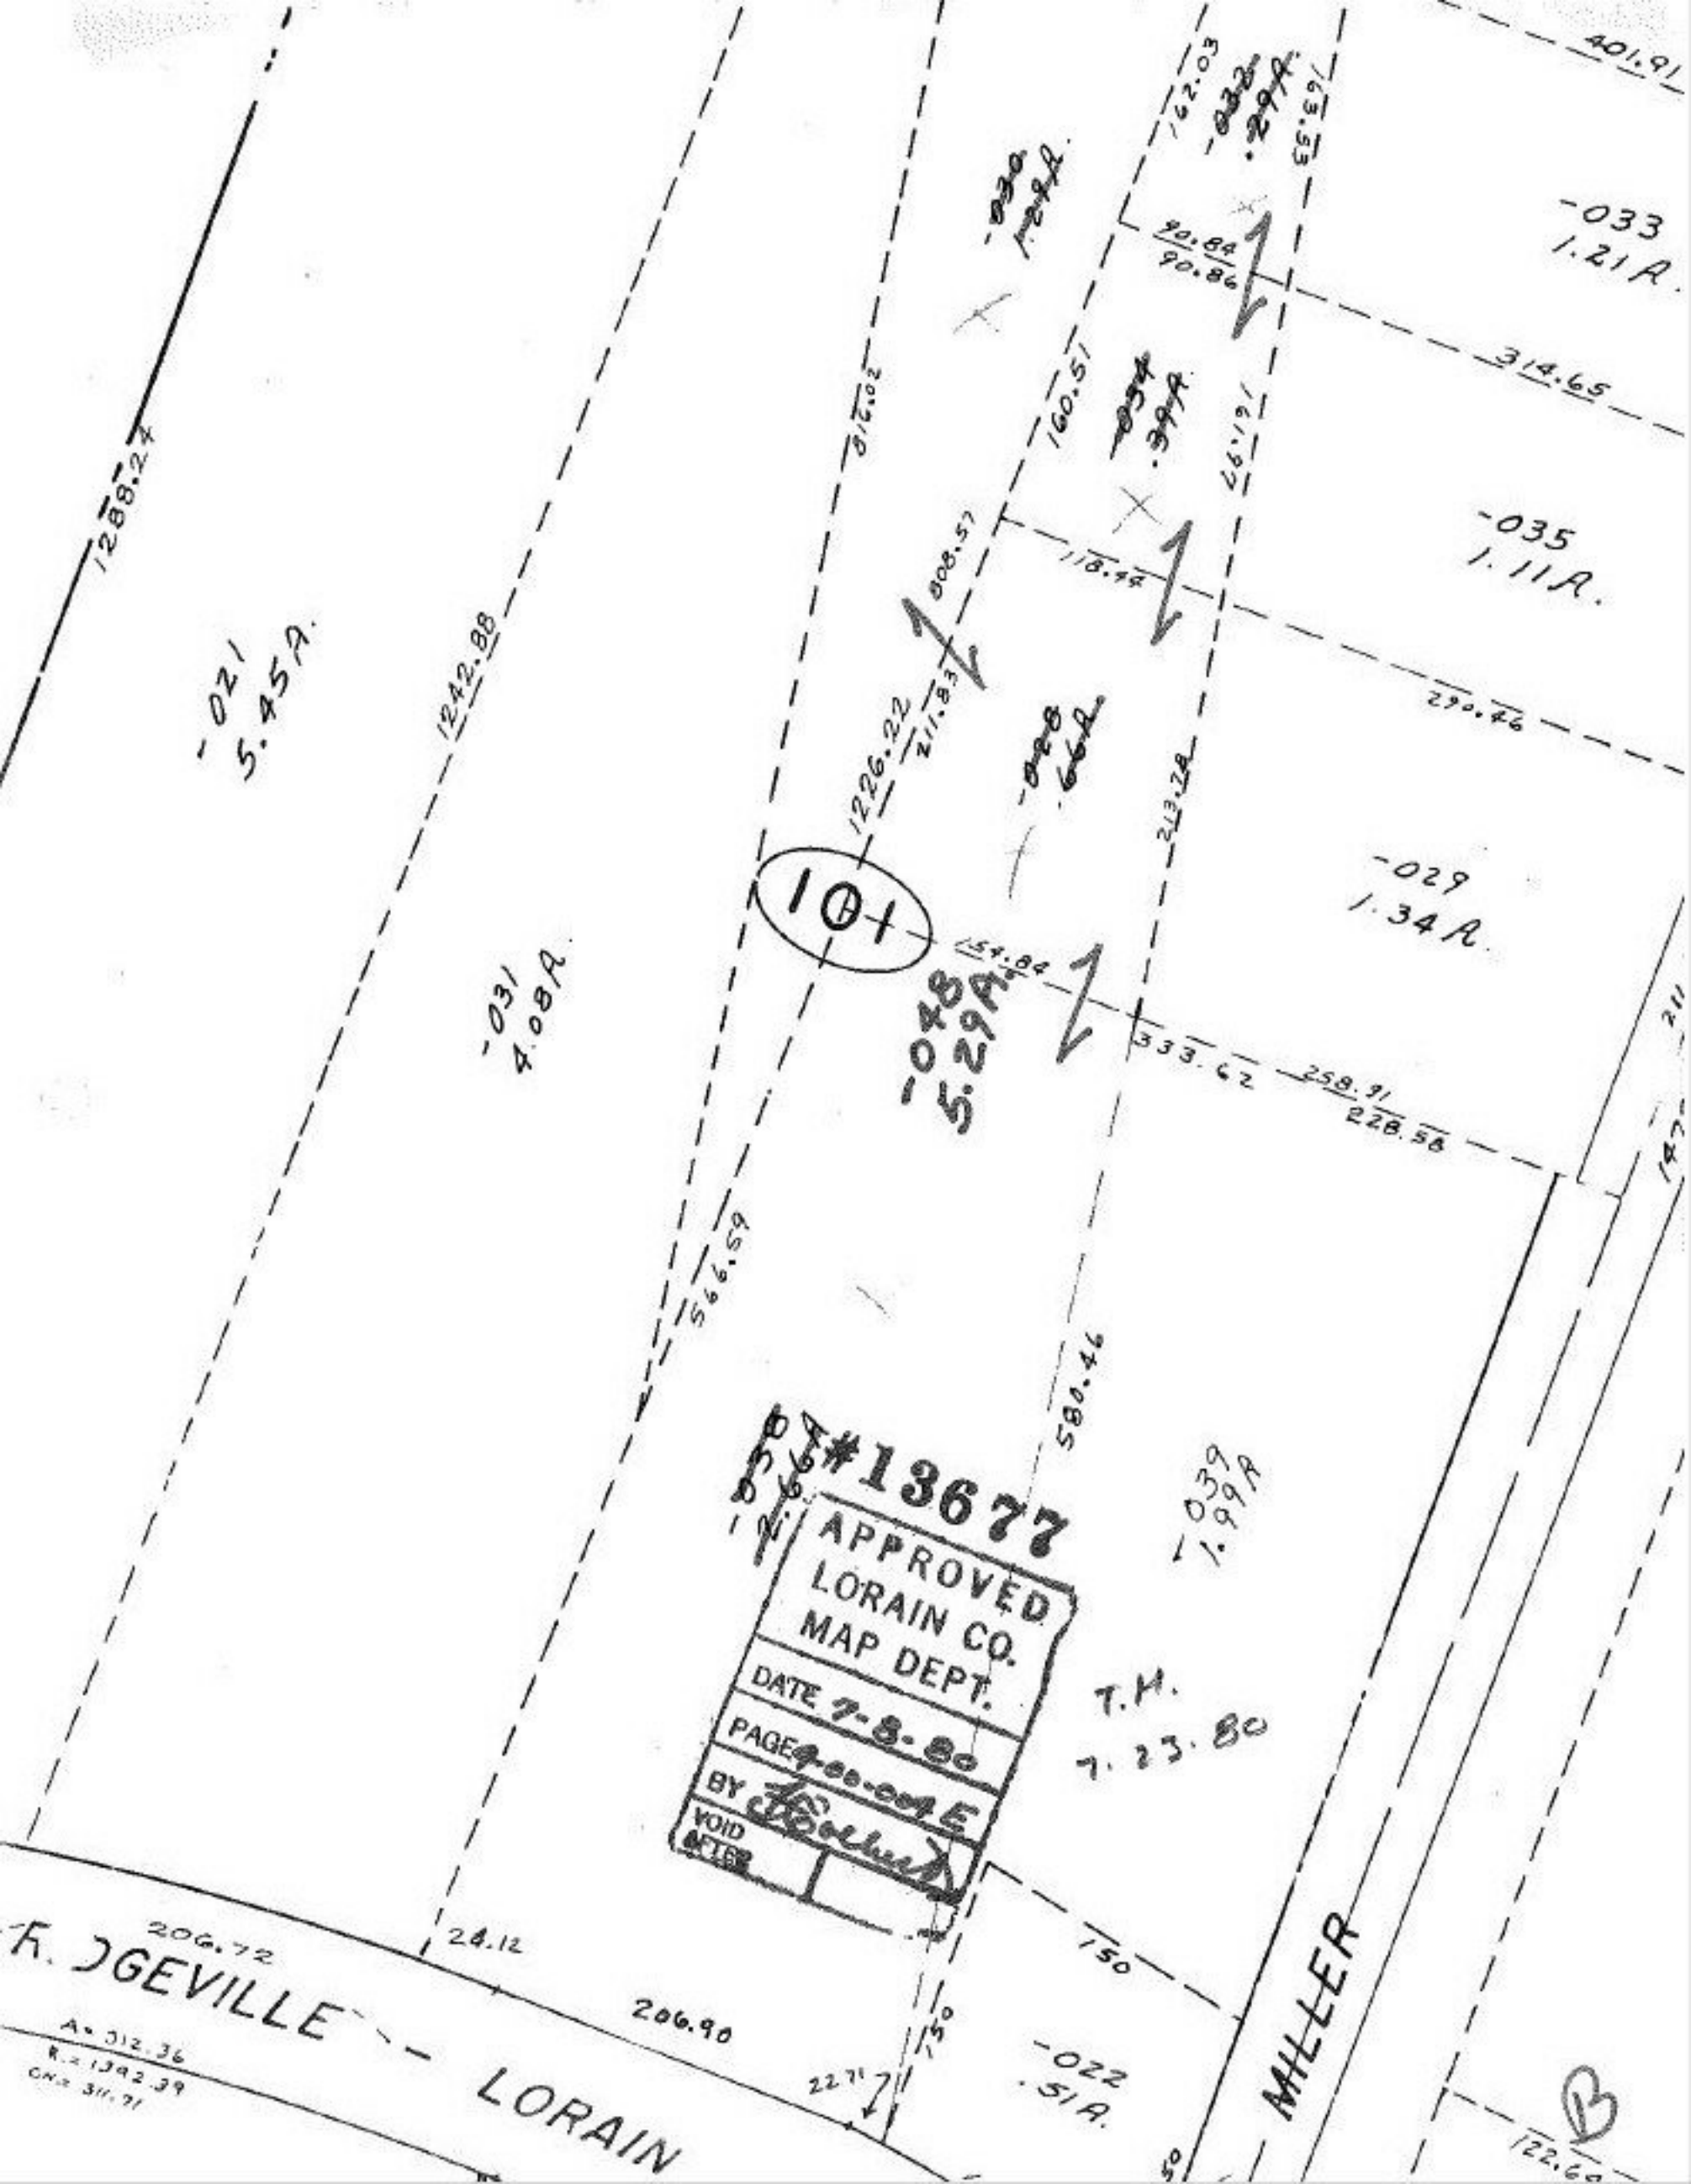

401.91
162.03
163.53
-033
1.21A.
90.84
90.86
314.65
160.51
-035
1.11A.
118.44
290.46
1288.24
-021
5.45A.
1242.88
1226.22
211.83
-029
1.34A.
101
-031
4.08A.
-048
5.29A.
154.84
333.62
258.91
228.58
566.59
580.46
-039
1.99A
#13677
APPROVED
LORAIN CO.
MAP DEPT.
DATE 7-8-80
PAGE
BY
VOID
AFTER
T.H.
7.23.80
206.72
24.12
206.90
150
-022
.51A.
MILLER
LORAIN
B