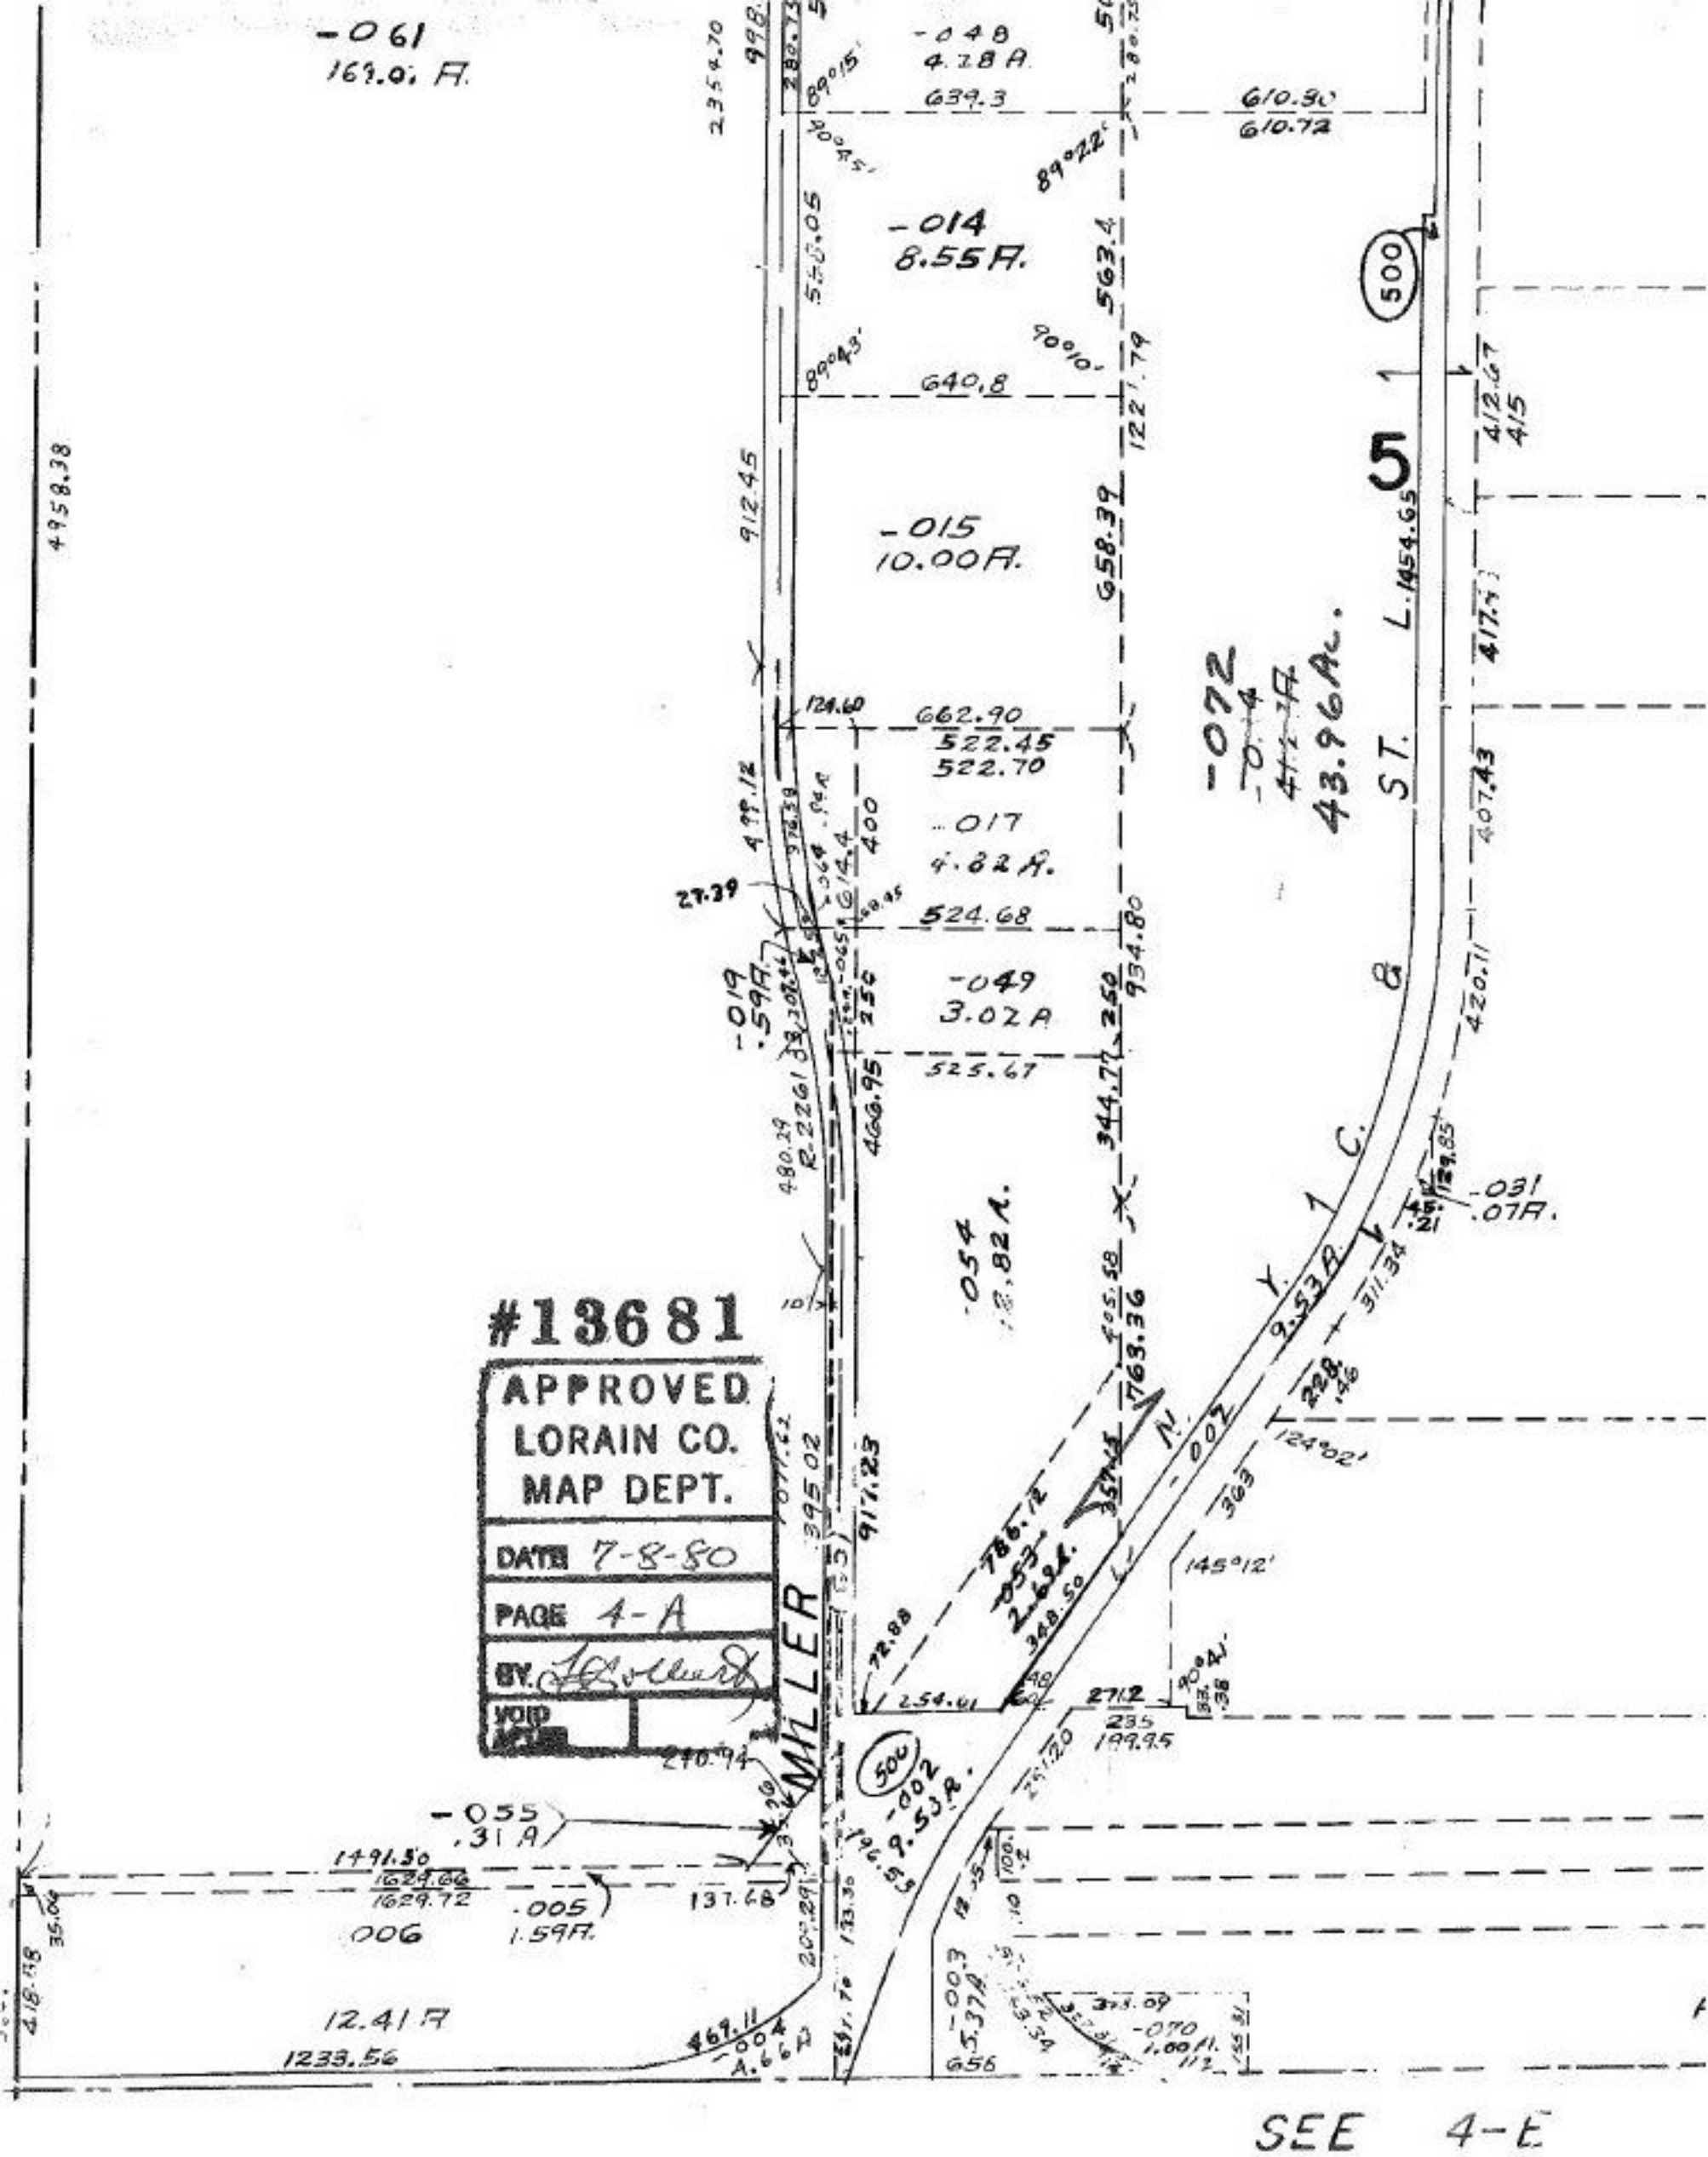

#13681

APPROVED
LORAIN CO.
MAP DEPT.

DATE 7-8-80

PAGE 4-A

BY. [signature]

VOID AFTER

SEE 4-E