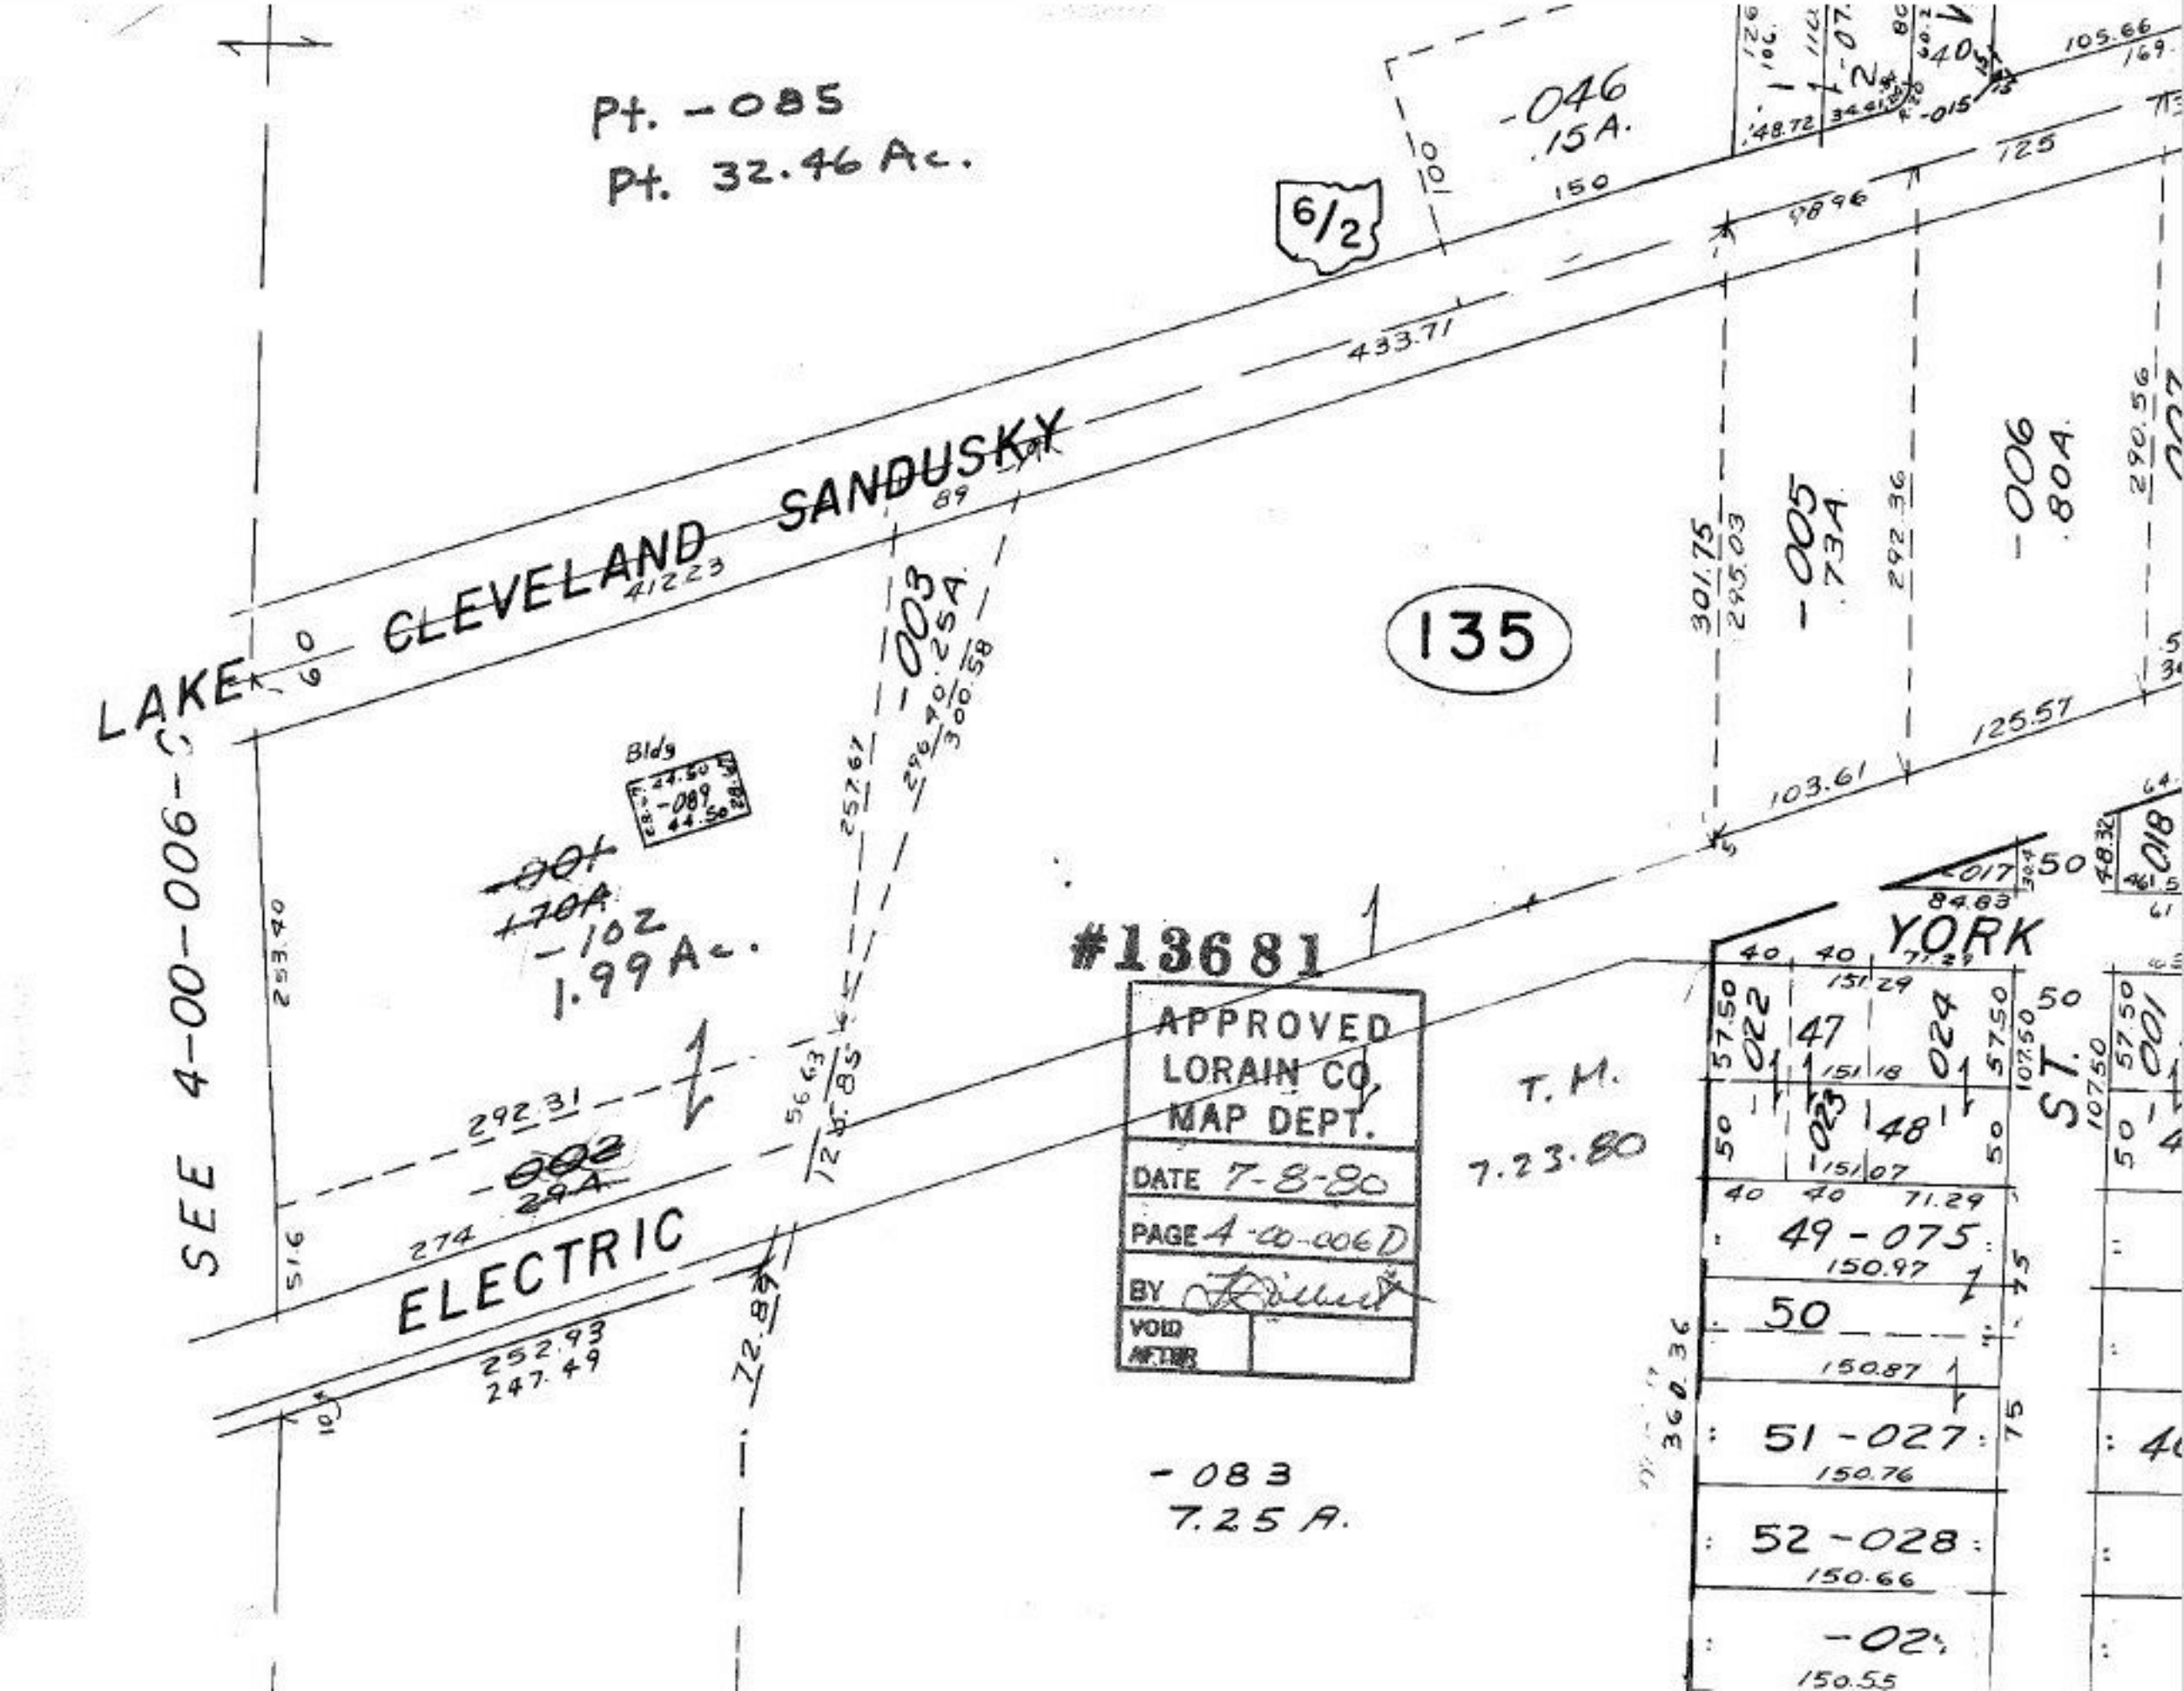

Pt. -085
Pt. 32.46 Ac.
6/2
-046
.15A.
LAKE CLEVELAND SANDUSKY
135
-003
.25A
-005
.73A
-006
.80A
SEE 4-00-006-C
Bldg
-089
-001
.70A
-102
1.99 Ac.
ELECTRIC
#13681
APPROVED
LORAIN CO.
MAP DEPT.
DATE 7-8-80
PAGE 4-00-006D
BY
VOID AFTER
T.M.
7.23.80
-083
7.25 A.
YORK
ST.
49-075
50
51-027
52-028
-02