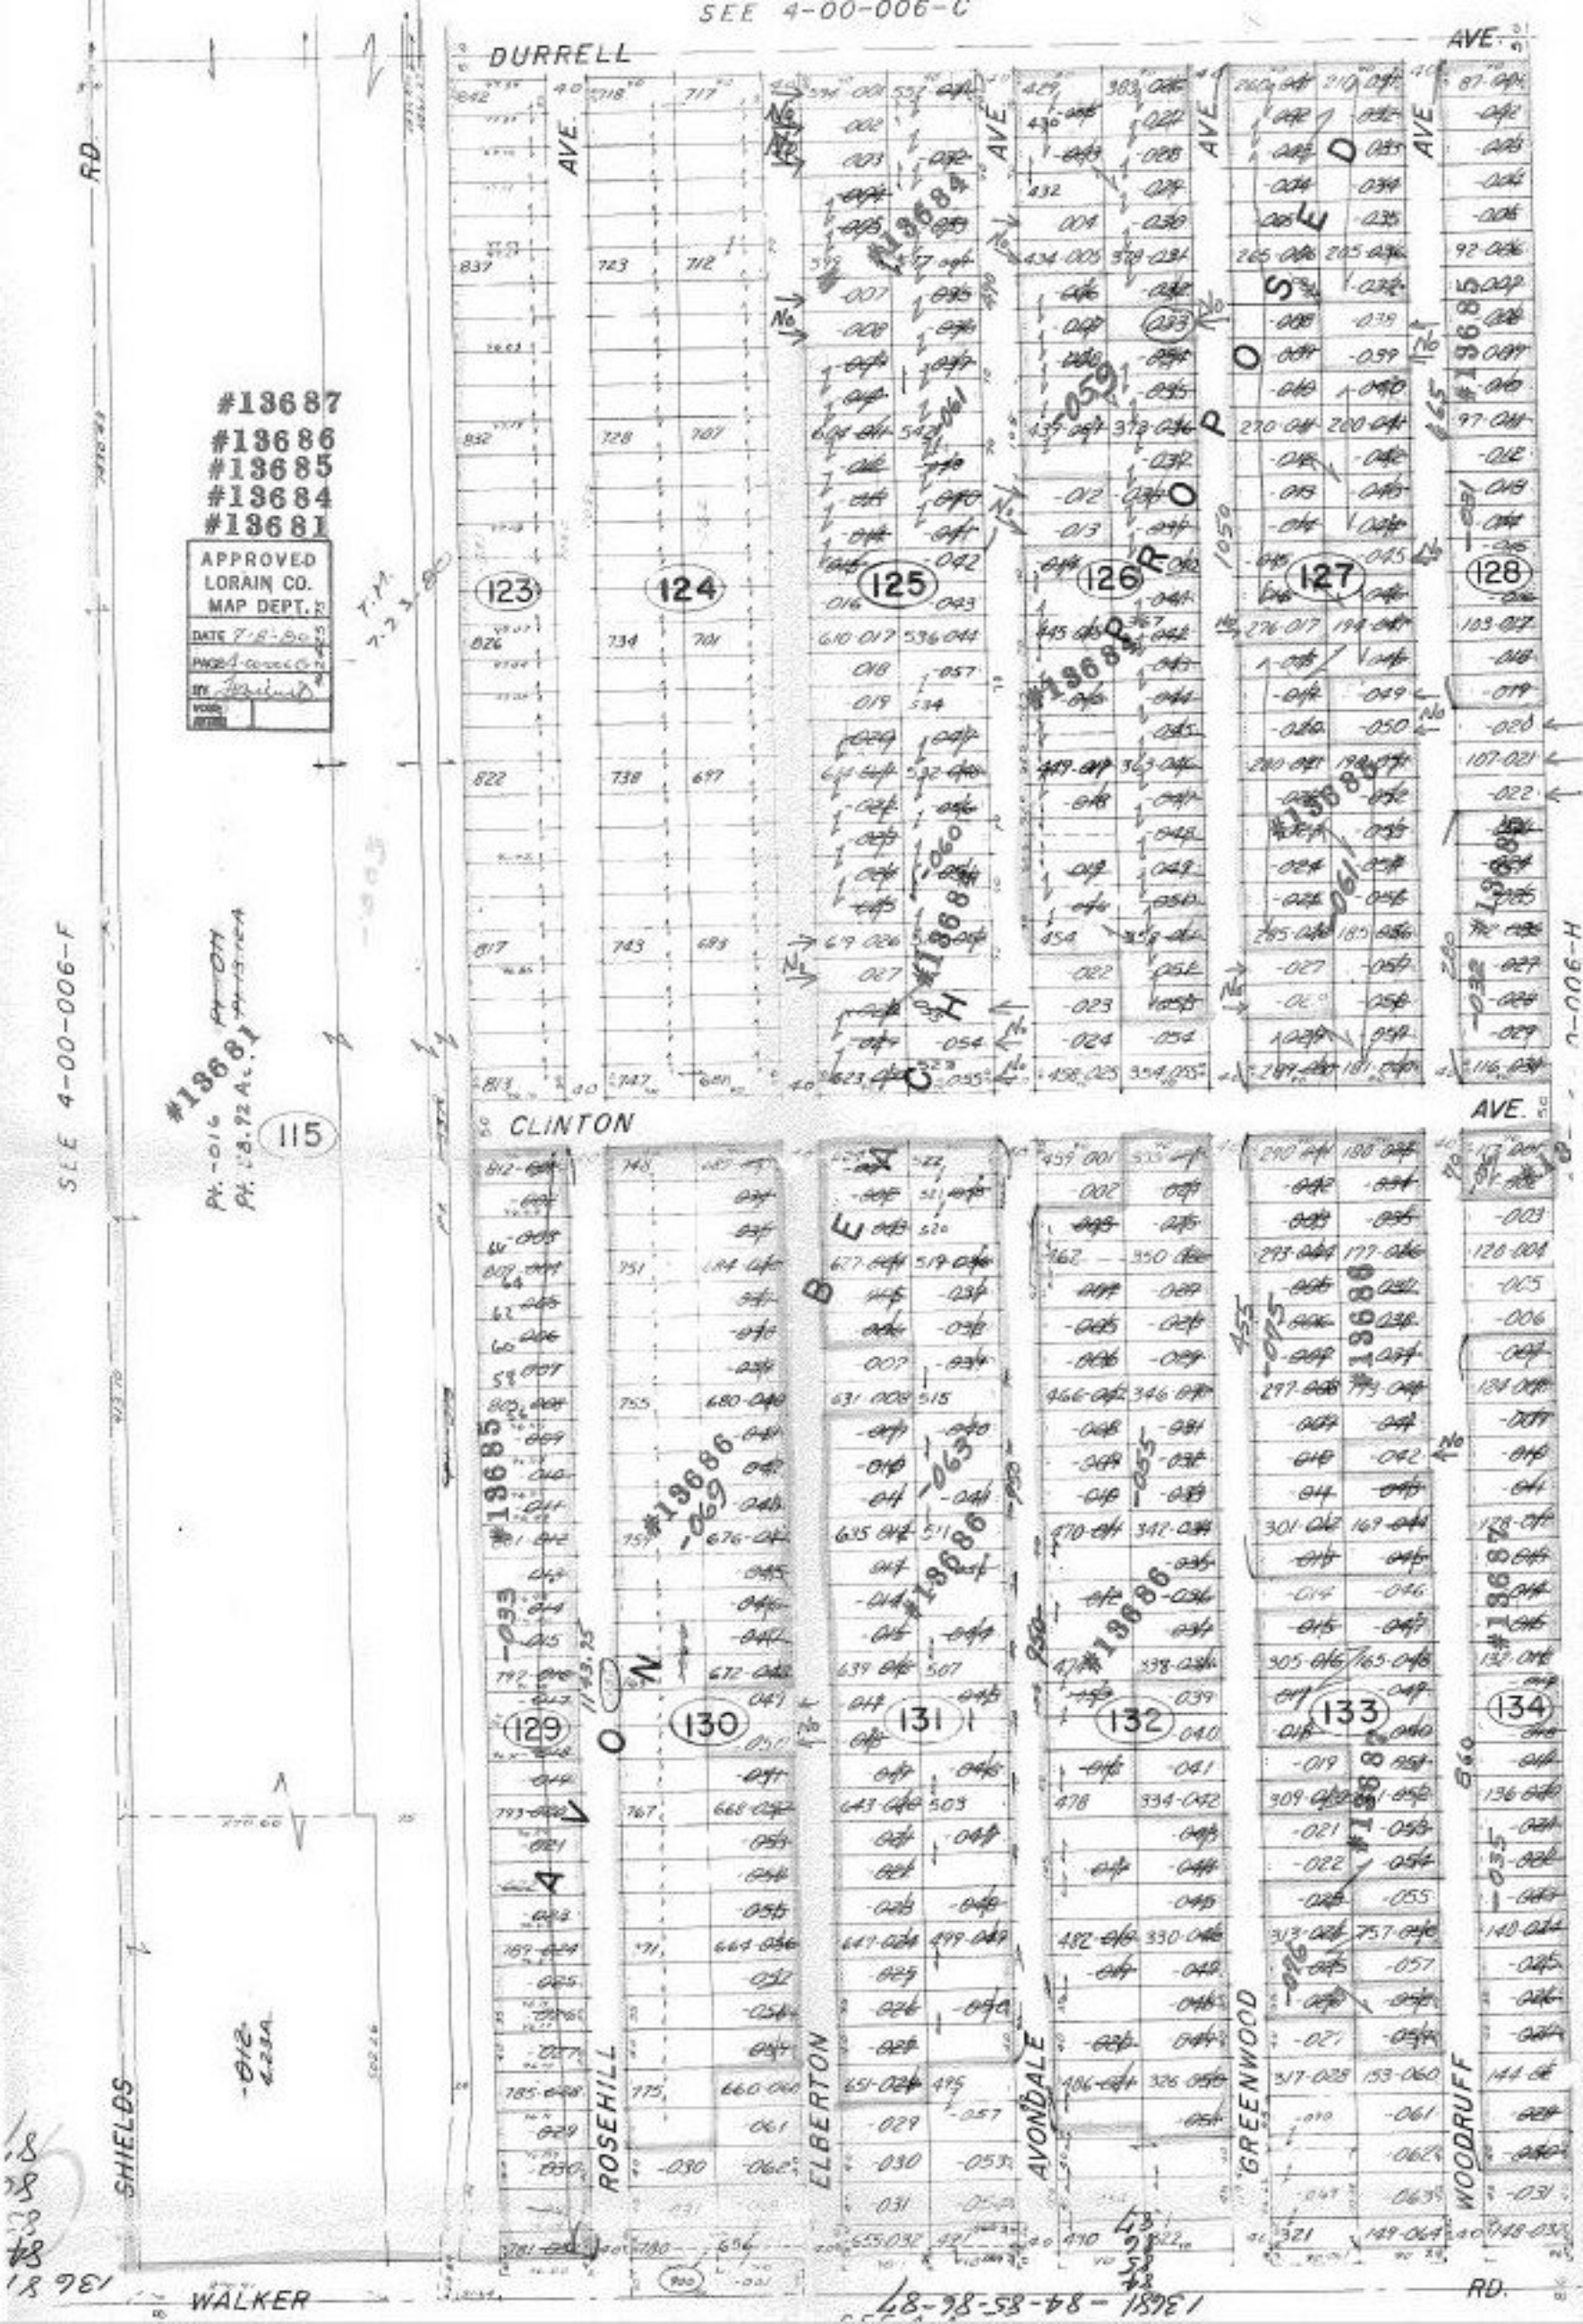
SEE 4-00-006-C
DURRELL
AVE.
CLINTON
AVE.
SHIELDS
RD.
WALKER
RD.
ROSEHILL
ELBERTON
AVONDALE
GREENWOOD
WOODRUFF
AVON
BEACH
PROPOSED
#13687
#13686
#13685
#13684
#13681
APPROVED
LORAIN CO.
MAP DEPT.
DATE 7-8-80
123
124
125
126
127
128
129
130
131
132
133
134
115
SEE 4-00-006-F
SEE 4-00-006-H