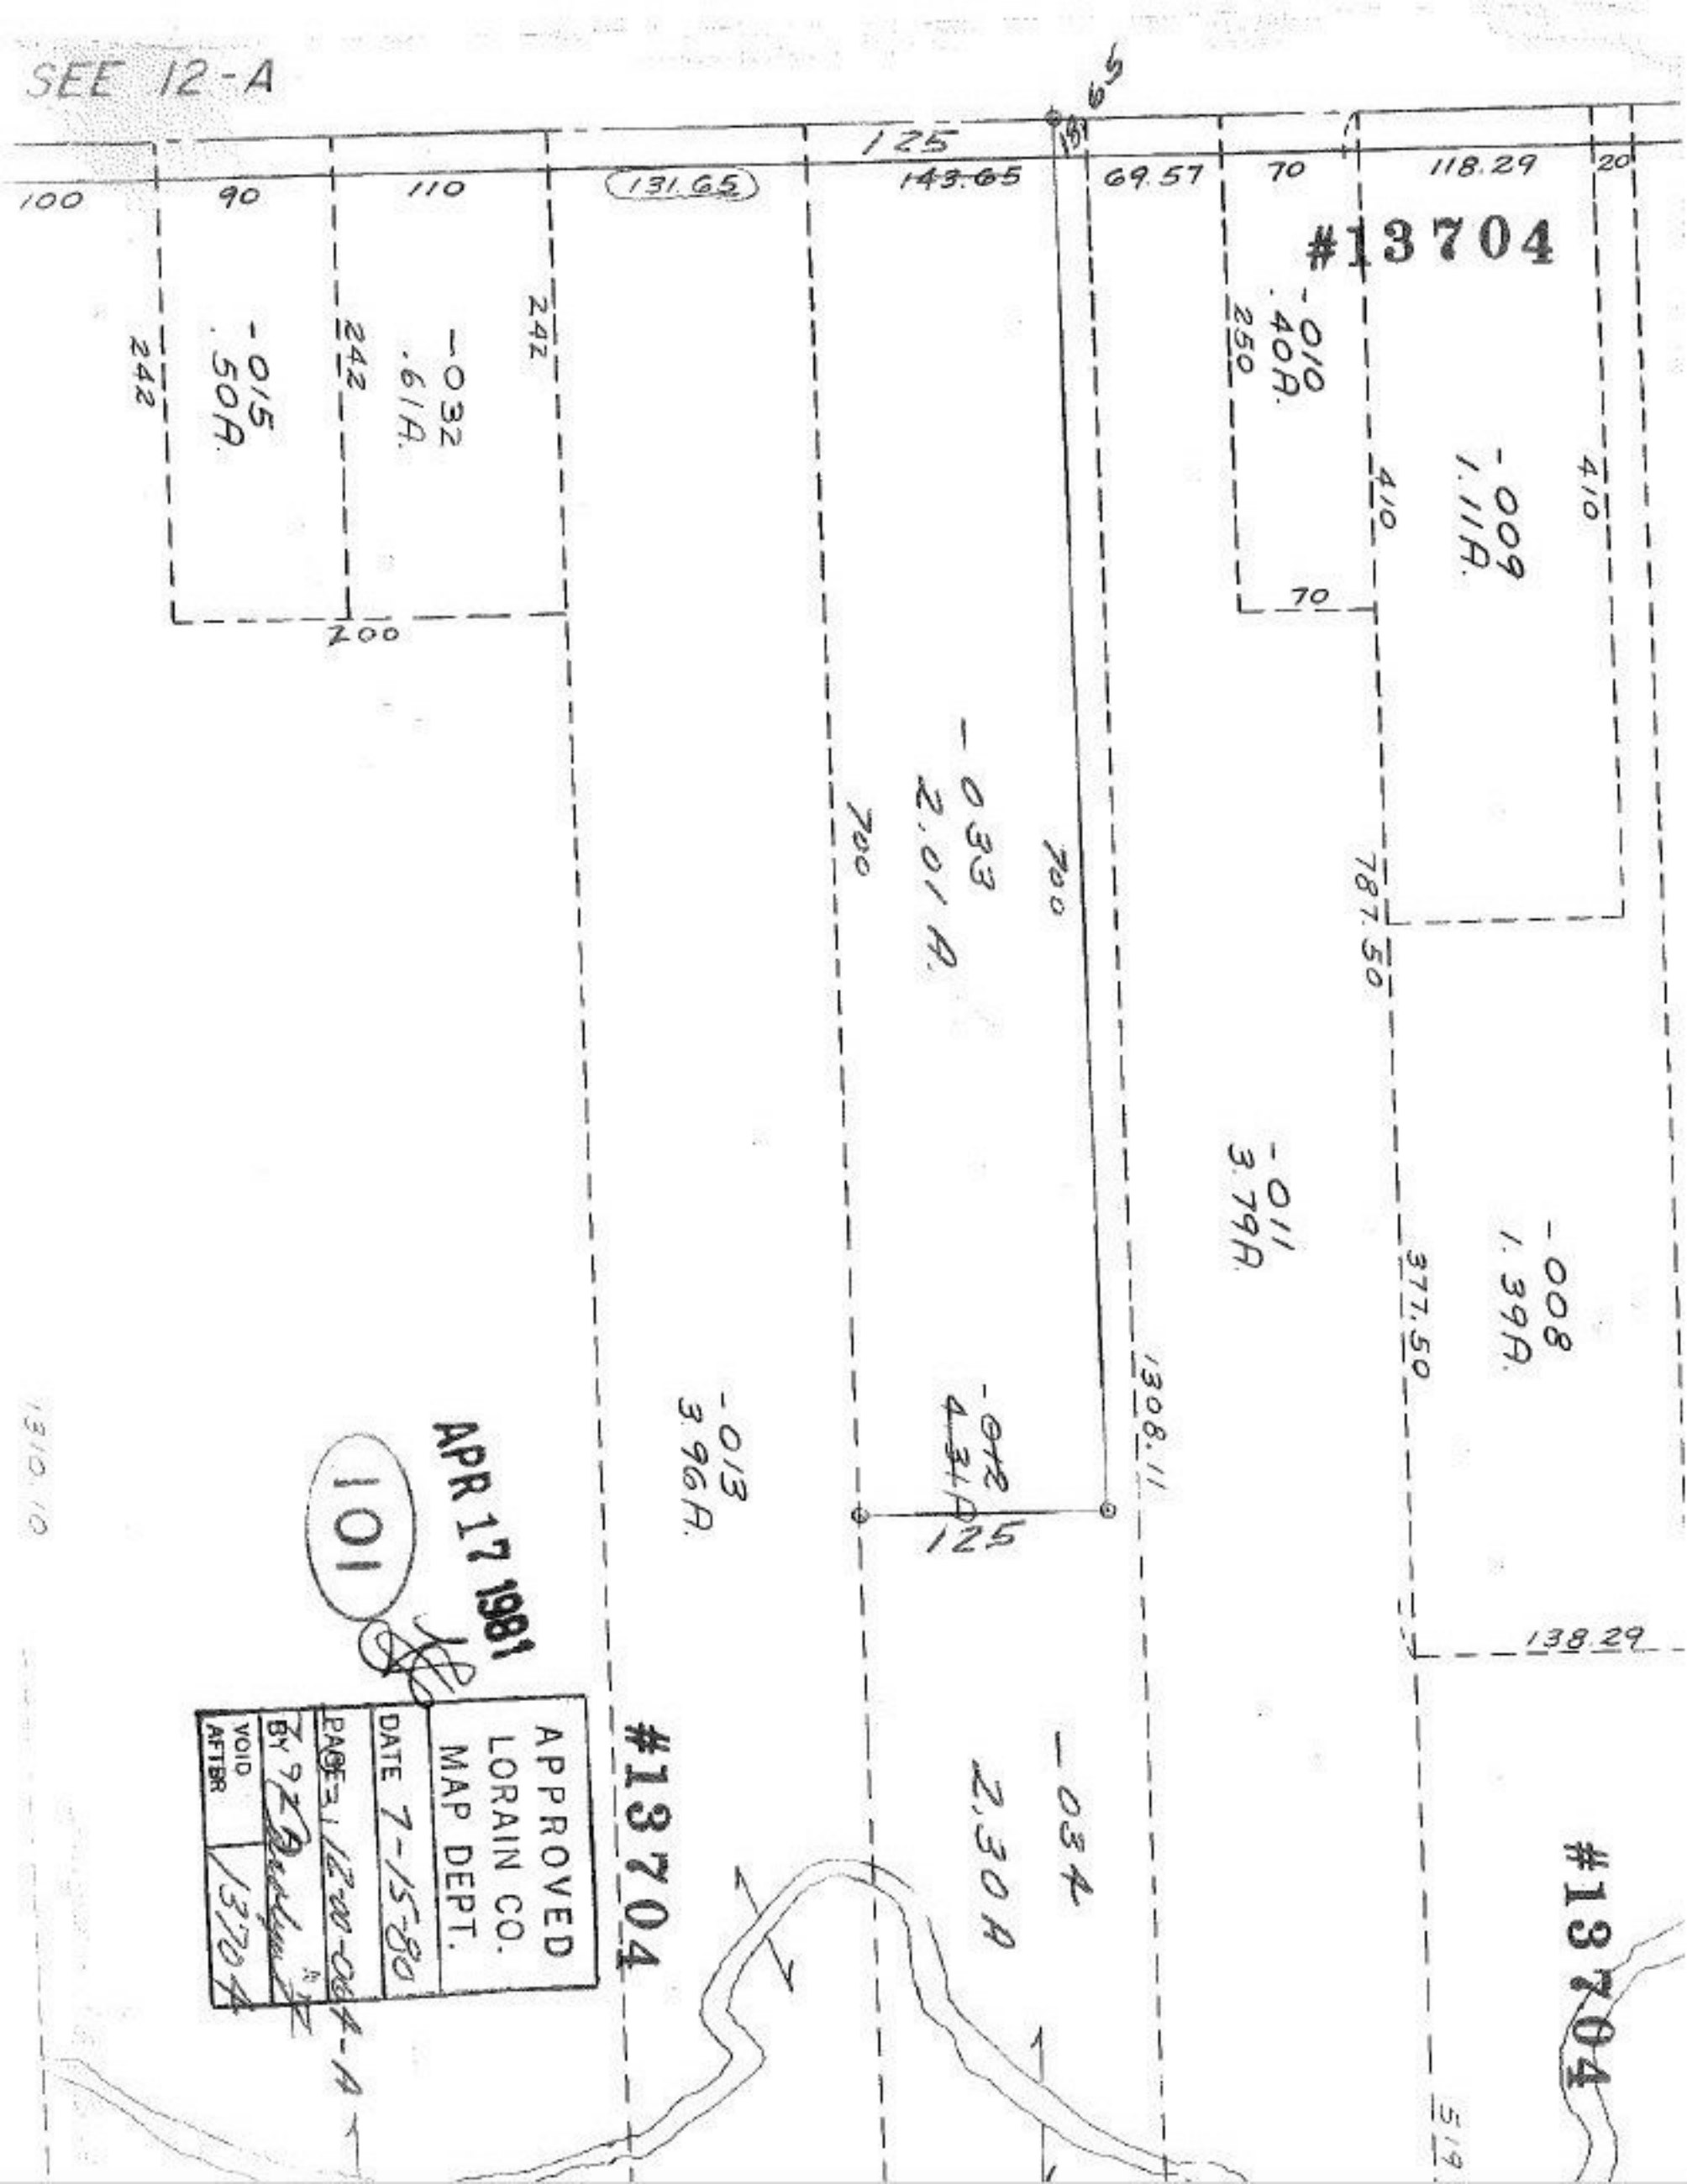
SEE 12-A
125
100
90
110
131.65
143.65
69.57
70
118.29
20
#13704
-015
.50A.
242
-032
.61A.
242
242
200
-010
.40A.
250
-009
1.11A.
410
410
70
-033
2.01 A.
700
700
787.50
-011
3.79A.
377.50
-008
1.39A.
1308.11
-013
3.96A.
-012
4.31A
125
138.29
-034
2.30A
#13704
#13704
APPROVED
LORAIN CO.
MAP DEPT.
DATE 7-15-80
PAGE 12-00-064-A
BY
VOID AFTER 13704
APR 17 1981
101