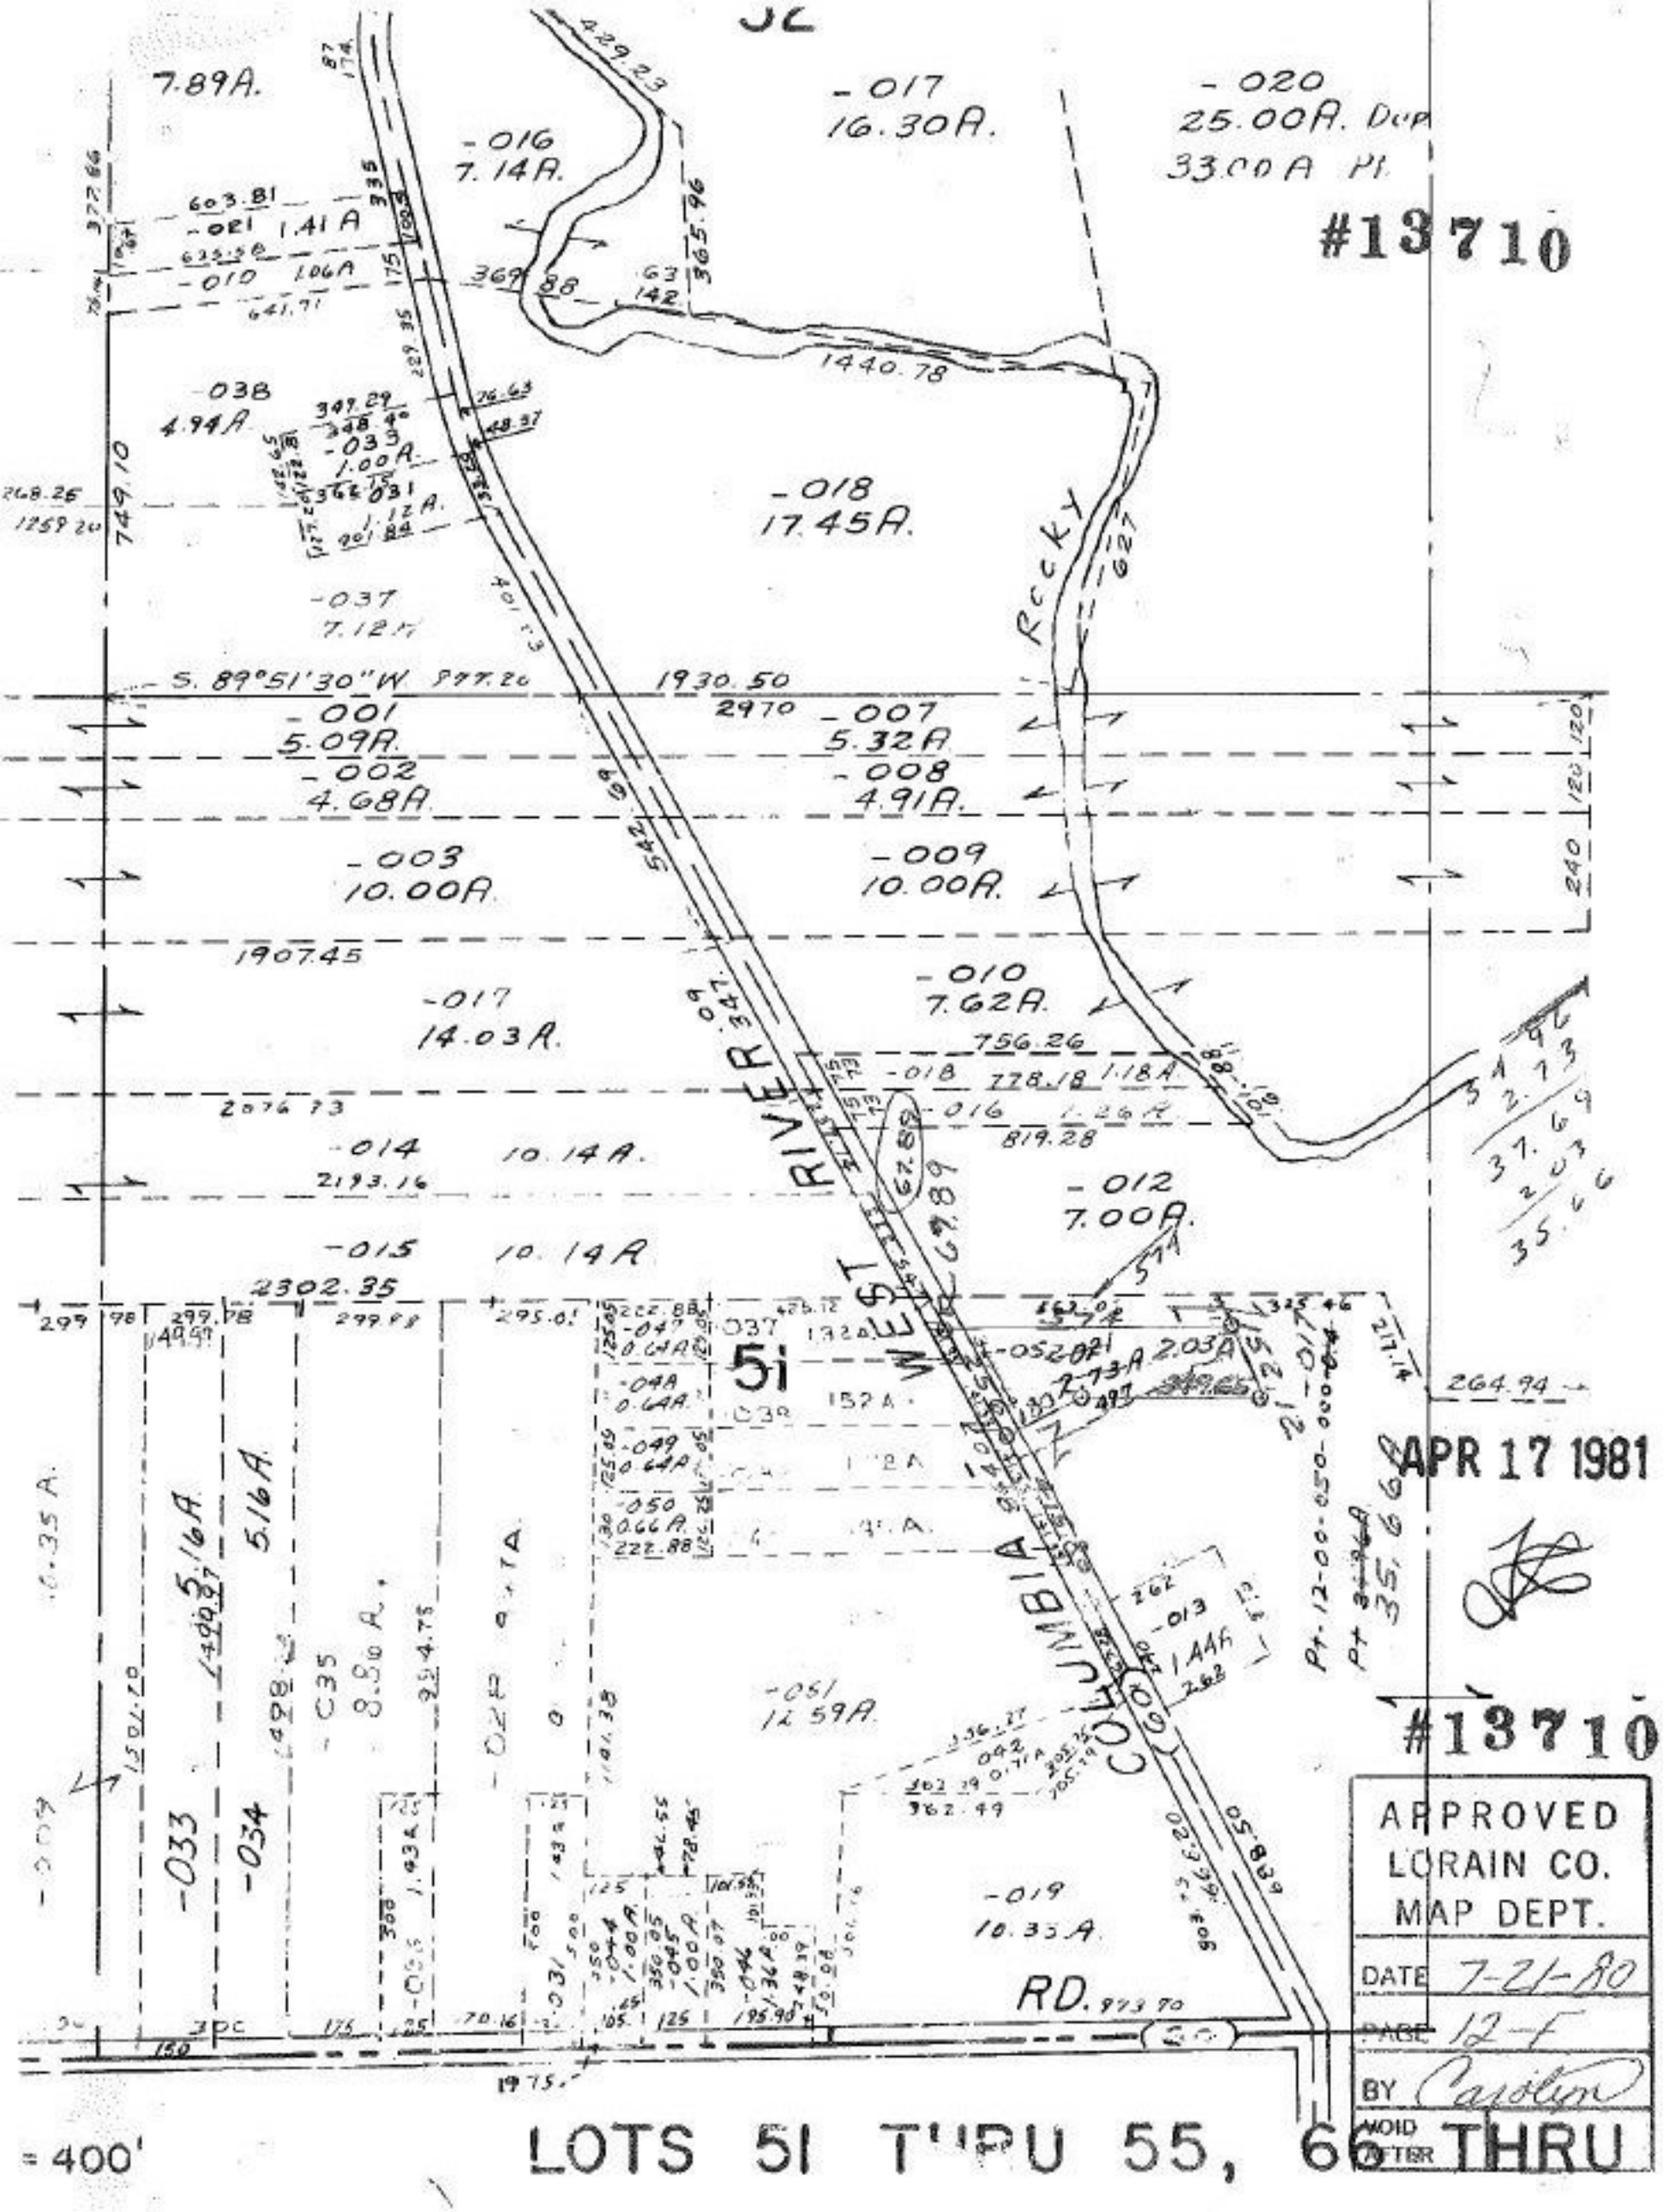

#13710
7.89A.
-016
7.14A.
-017
16.30A.
-020
25.00A. Dup
33.00A Pl.
-018
17.45A.
-038
4.94A.
-037
7.12A.
S. 89°51'30"W
1930.50
2970
-001
5.09A.
-002
4.68A.
-003
10.00A.
-007
5.32A.
-008
4.91A.
-009
10.00A.
-010
7.62A.
-017
14.03A.
-014
10.14A.
-015
10.14A.
-012
7.00A.
-051
12.59A.
-019
10.35A.
Rocky
RIVER
WEST
COLUMBIA
RD.
51
APR 17 1981
#13710
APPROVED
LORAIN CO.
MAP DEPT.
DATE 7-21-80
PAGE 12-F
BY Carolyn
VOID AFTER
= 400'
LOTS 51 THRU 55, 66 THRU 7