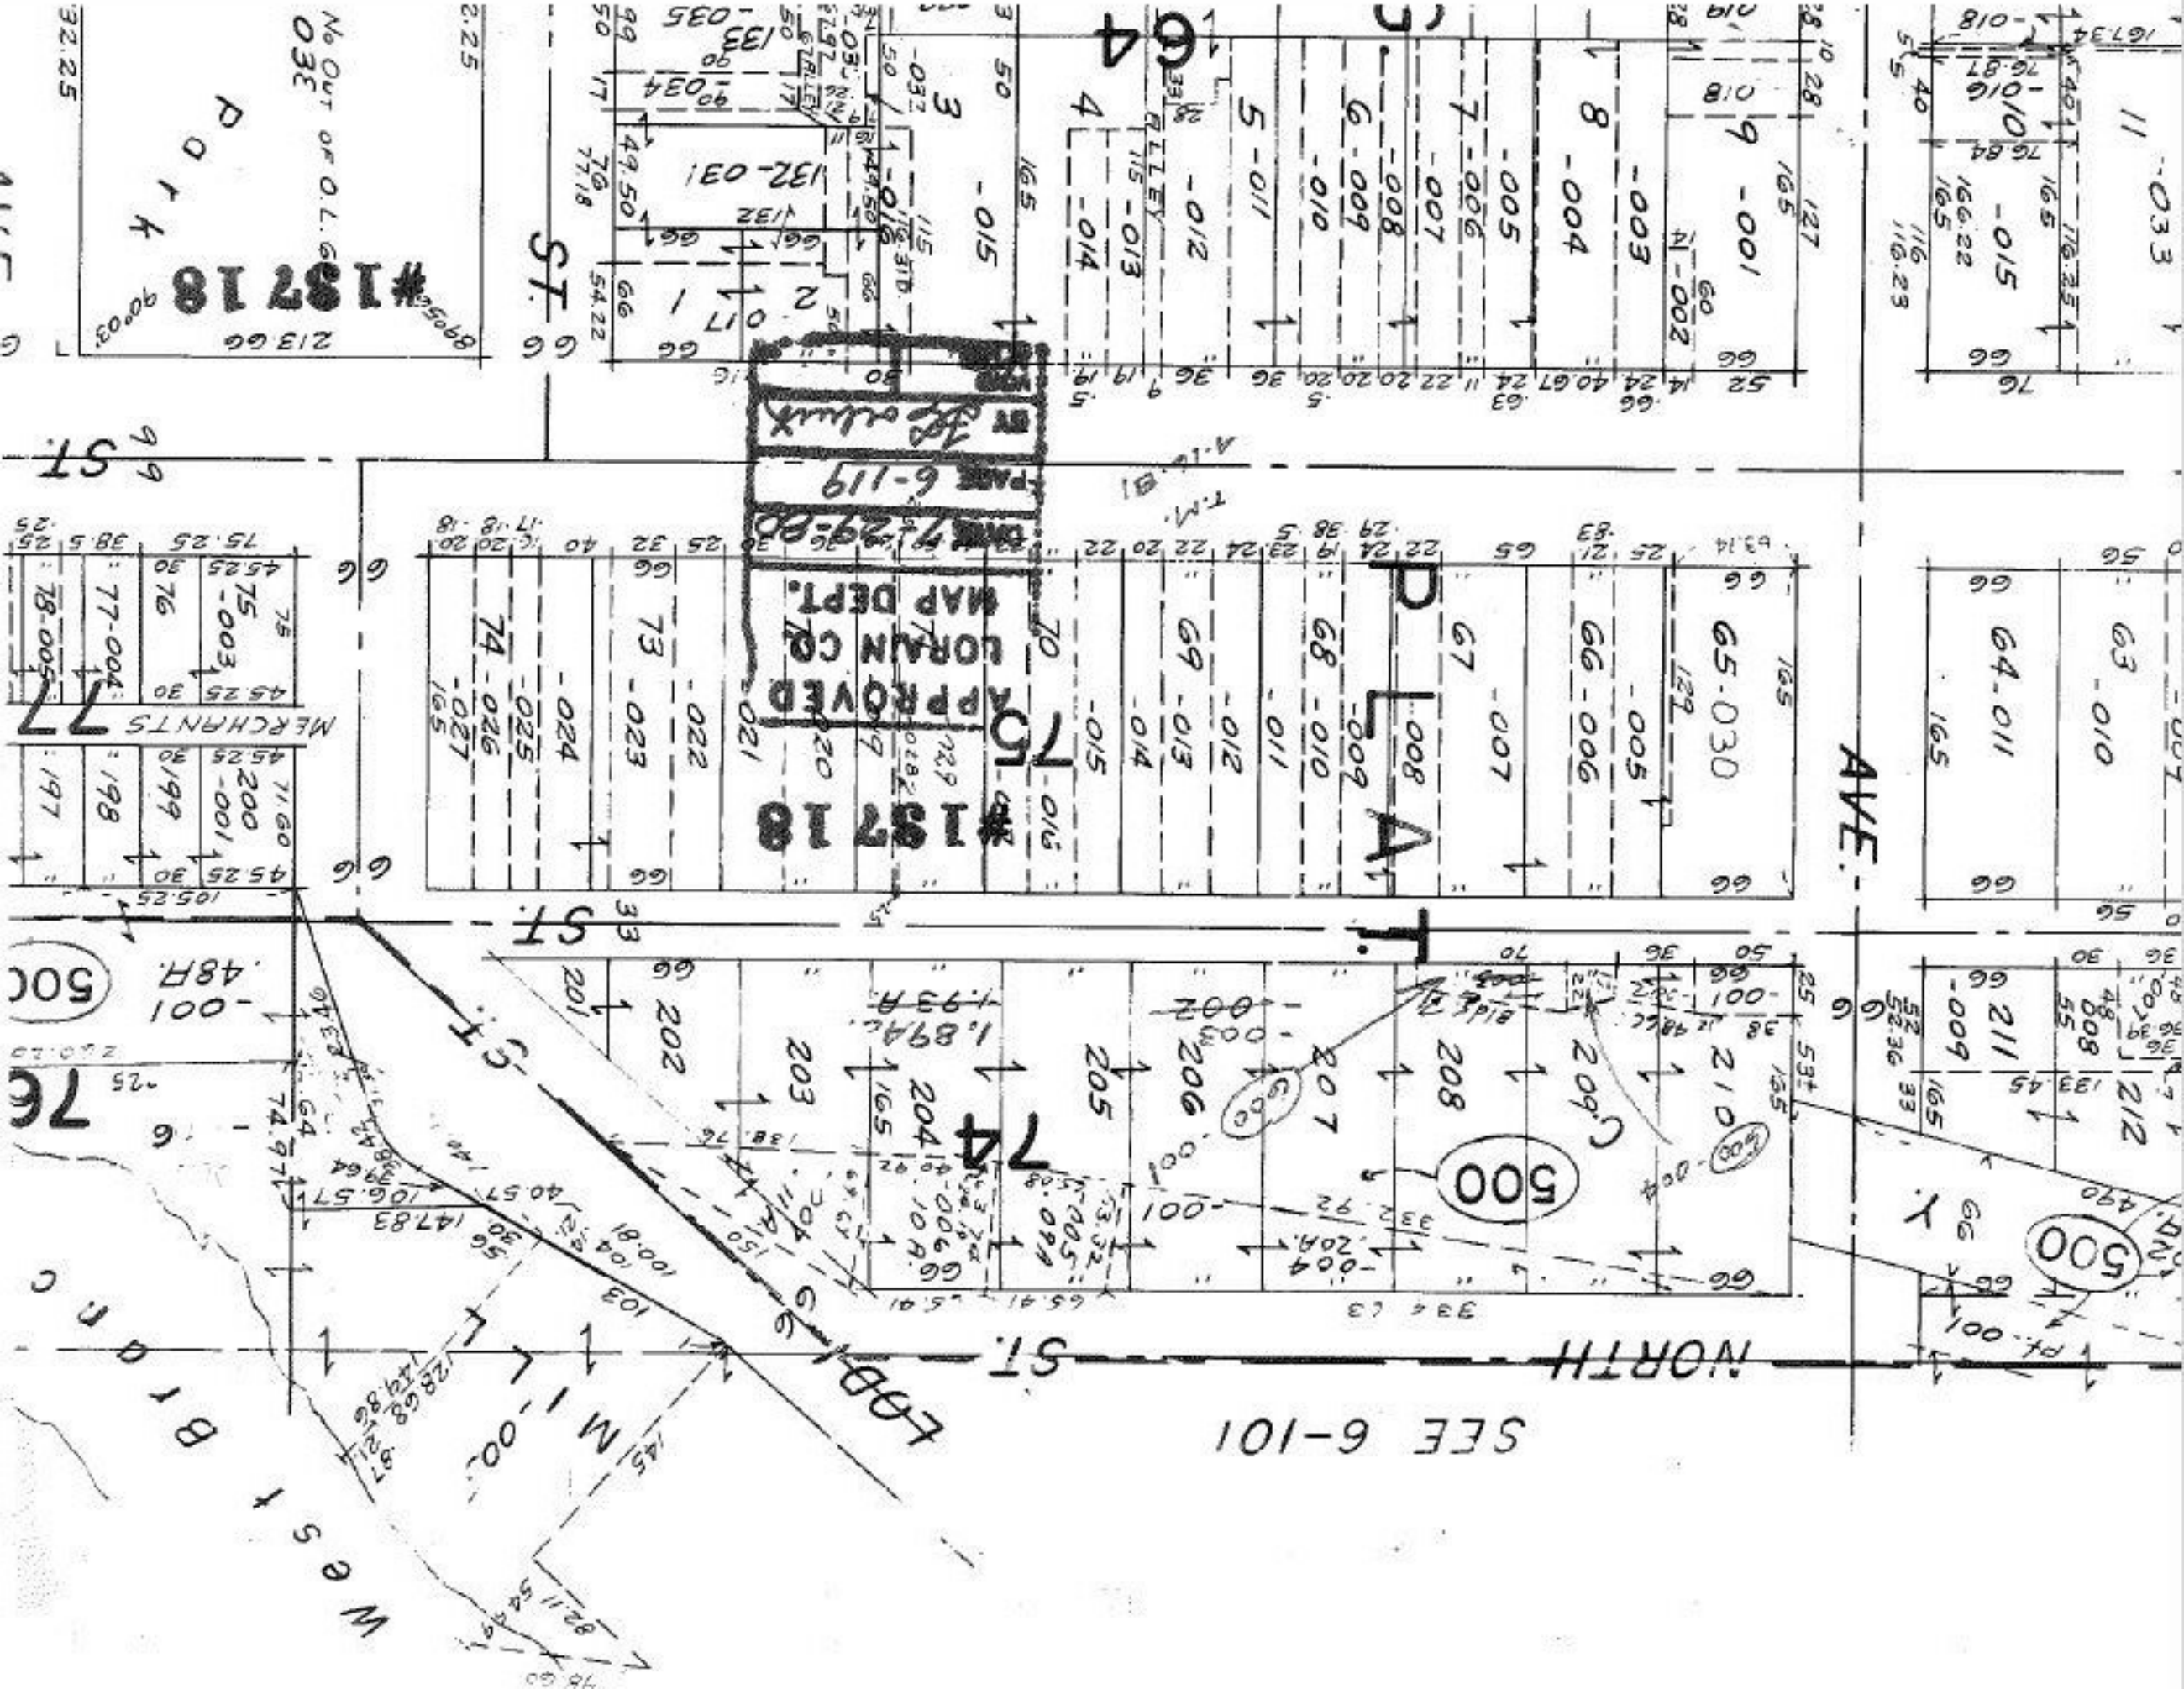
#137 18
APPROVED
LORAIN CO.
MAP DEPT.
PAGE 6-119
ST.
AVE.
NORTH
SEE 6-101
MERCHANTS
Y
74
75
76
77
500
G
A
C
P
M
1.894A.
1.93A.
.48A.
132-031
133-035
No Out of O.L.