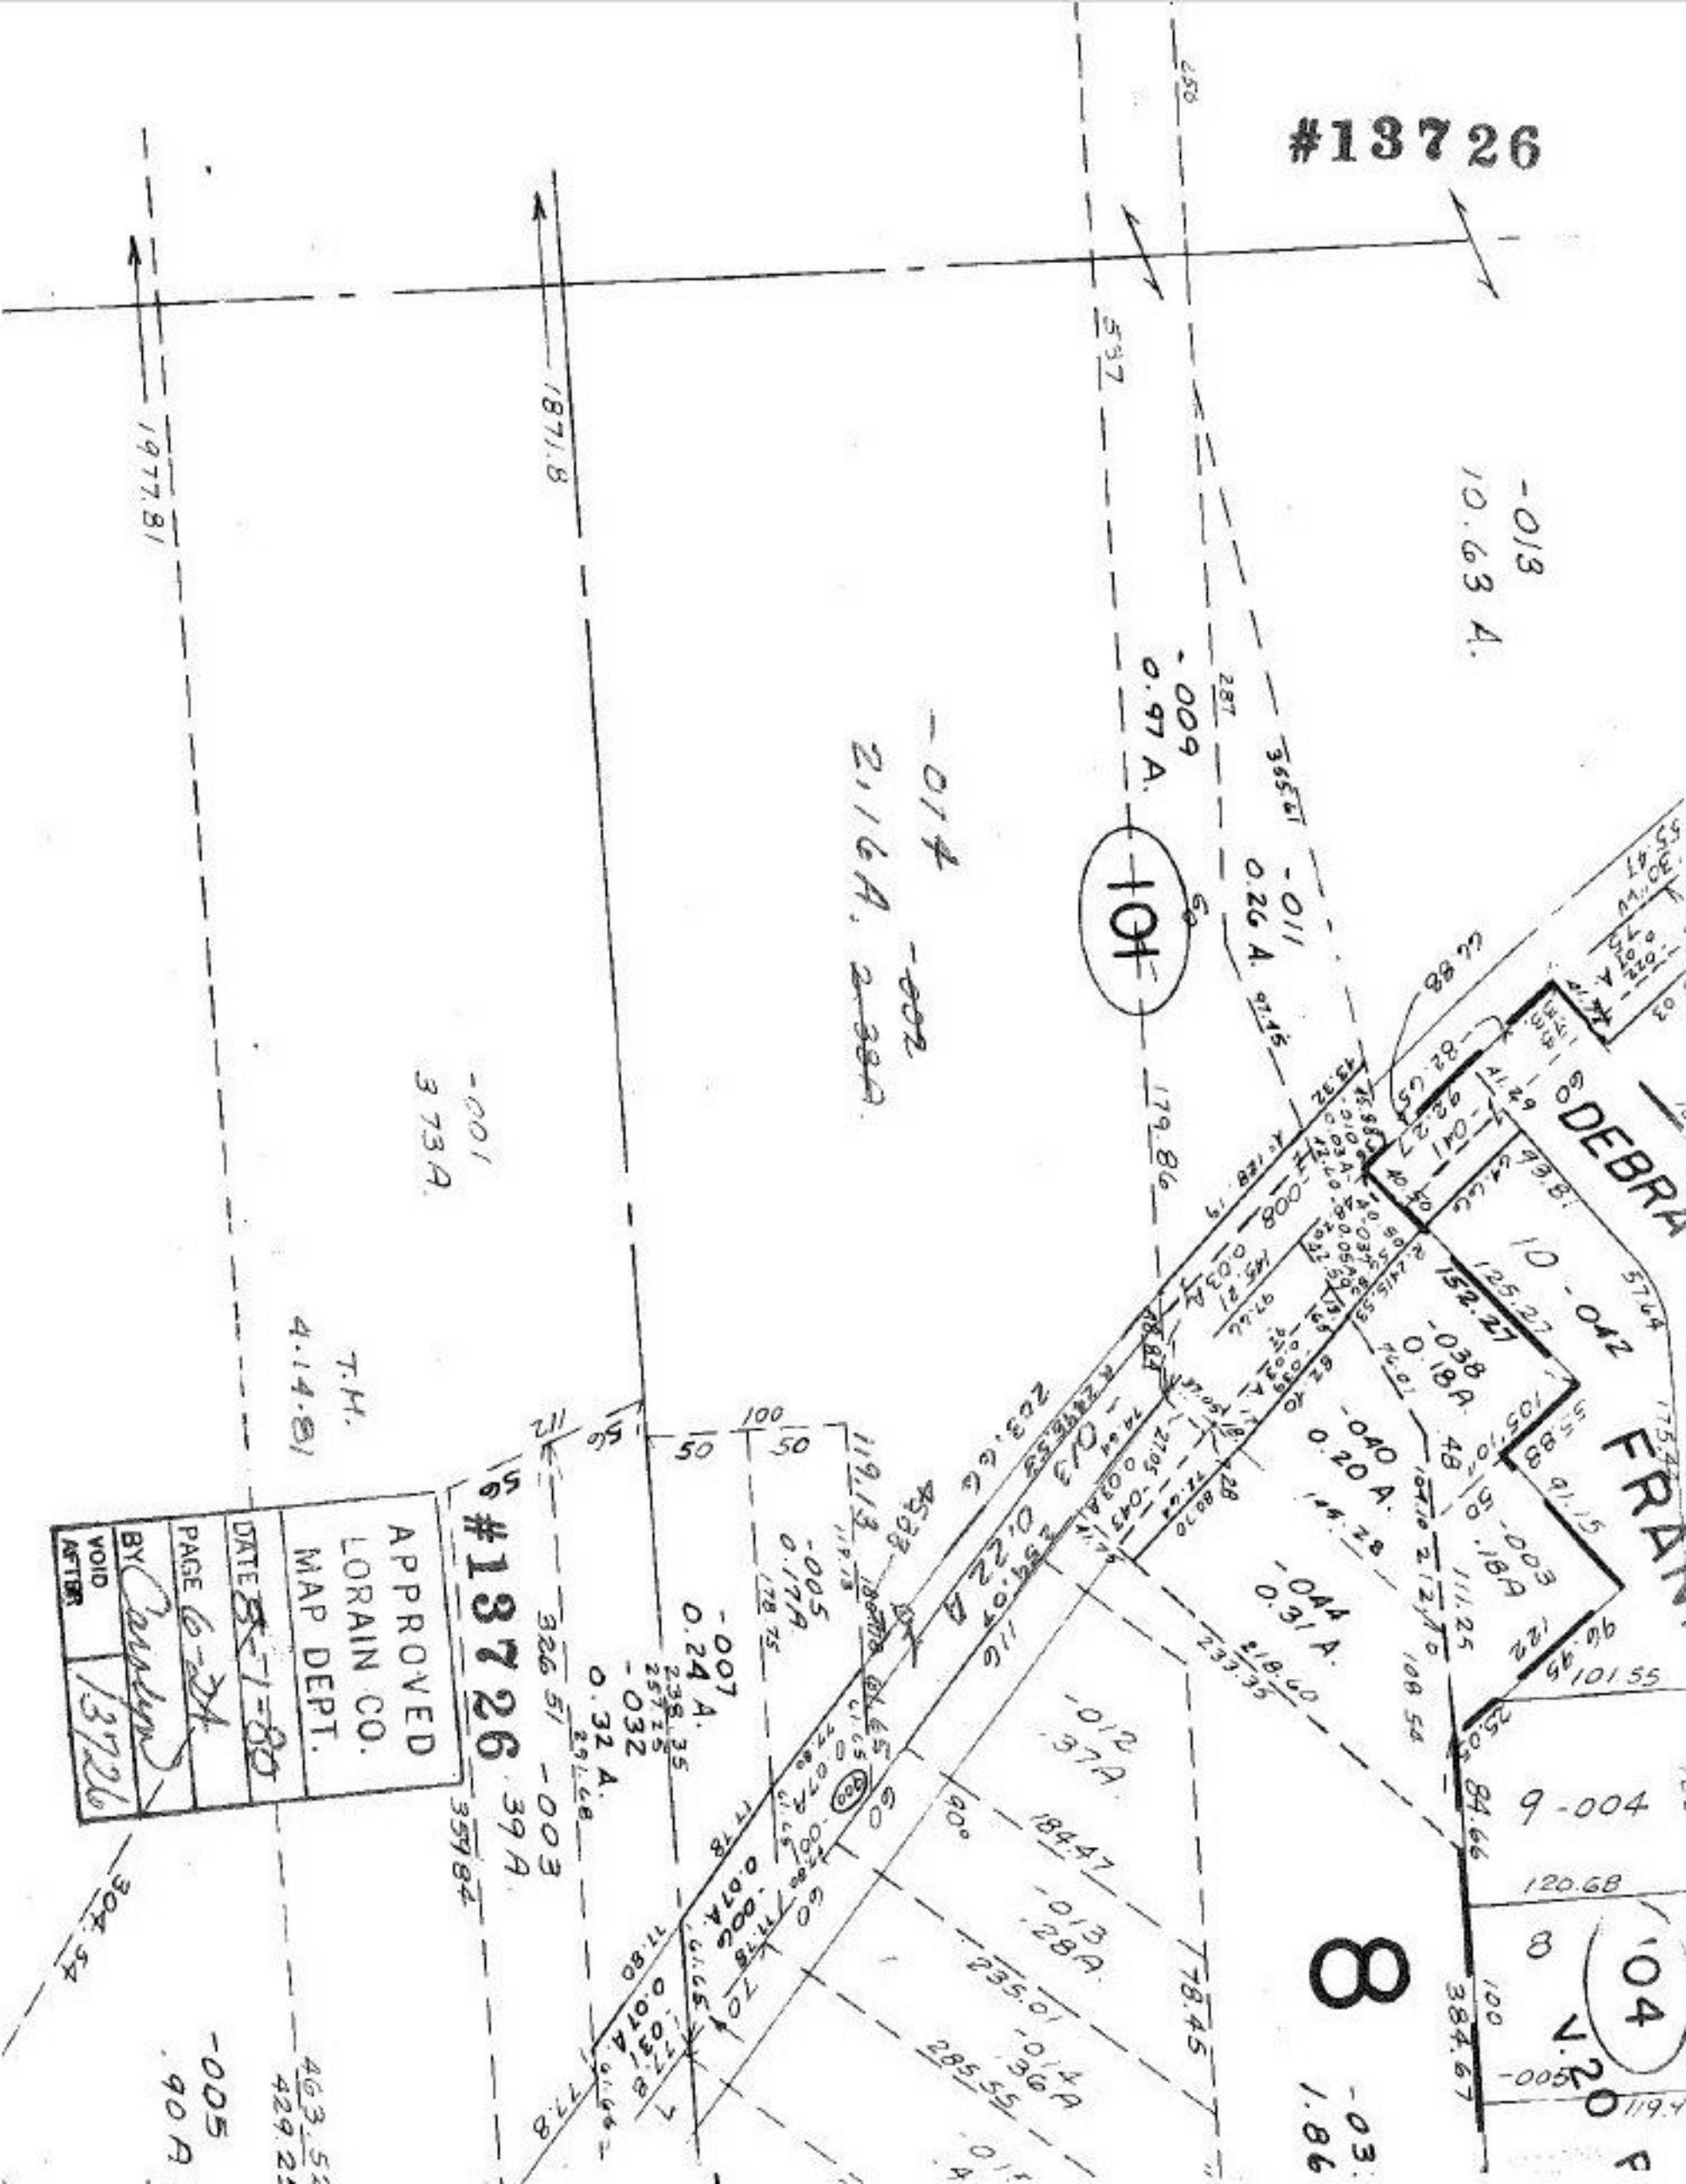
#13726
APPROVED
LORAIN CO.
MAP DEPT.
DATE 8-1-80
PAGE 6-24
BY Carolyn
VOID AFTER 13726
#13726
DEBRA
FRAN
8
V.20
-013
10.63 A.
-009
0.97 A.
-011
0.26 A.
-014
2.16 A.
-001
3.73 A.
T.H.
4.14.81
-007
0.24 A.
-032
0.32 A.
-005
0.17 A.
-003
.39 A.
-012
.37 A.
-013
.28 A.
-014
.36 A.
-038
0.18 A.
-040
0.20 A.
-044
0.31 A.
-003
.18 A.
-042
-005
.90 A.
1977.81
1871.8
179.86
184.47
235.01
285.55
120.68
101.55
9-004
10
8
104